F.H.WA. REGION NO.	STATE	FED. AID PROJ. NO.	SHEET NO.	TOTAL SHEETS
3	MD.			

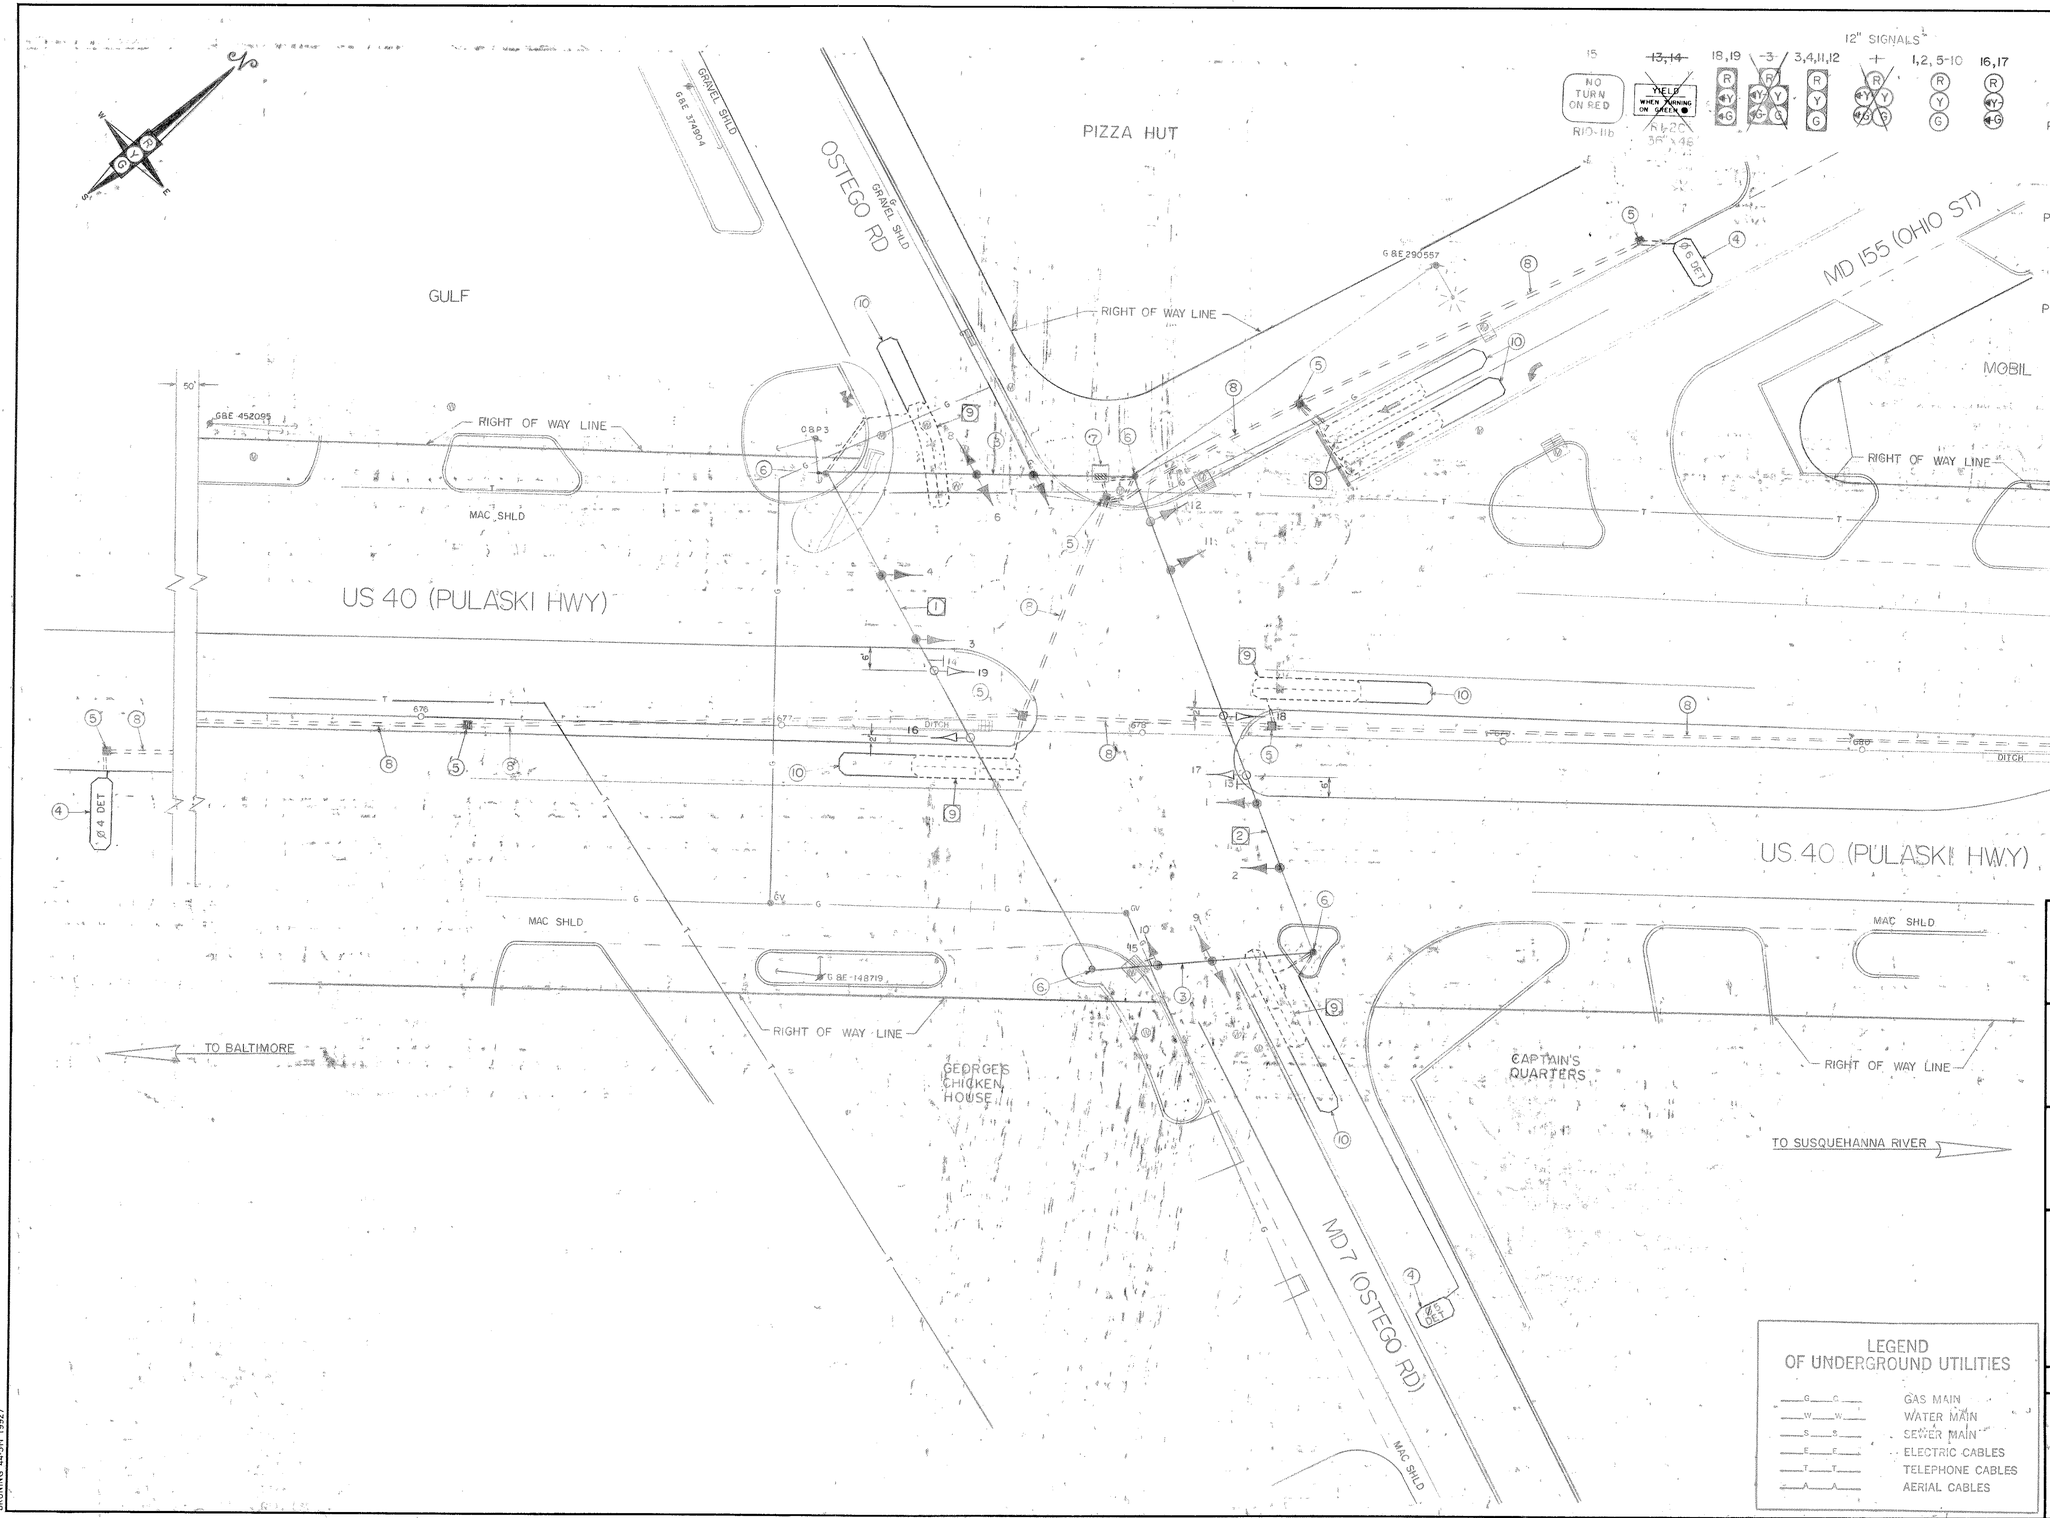

LEGEND OF UNDERGROUND UTILITIES

G G	GAS MAIN
W W	WATER MAIN
S S	SEWER MAIN
E E	ELECTRIC CABLES
T T	TELEPHONE CABLES
A A	AERIAL CABLES

APPROVAL: REGIONAL TRAFFIC ENGINEER

APPROVAL: CHIEF BUREAU OF TRAFFIC ENGINEERING

APPROVAL: ASS'T. CHIEF ENGINEER TRAFFIC

B AUG 8, 1983
CHANGE US 40 LEFT TURNS FROM E/P TO EXCLUSIVE
AW 679-501-085

A ASBUILT 6-29-82

H 700-002-485
FAP NO. TQF-F-125-(12)

REVISIONS

STATE OF MARYLAND
DEPARTMENT OF TRANSPORTATION
STATE HIGHWAY ADMINISTRATION

TRAFFIC DIVISION – BUREAU OF TRAFFIC ENGINEERING

US 40 (PULASKI HWY) & OSTEGO RD & MD 155

SCALE 1" = 20' DATE 8-22-72 CONTRACT NO. AW 679-501-085

DRAWN BY: JOHN BOLING COUNTY: HARFORD

DESIGNED BY: Howard J. Kilian Jr. SIGNAL NO.: ~~12014~~ 12000702.66

CHECKED BY:

DRAWING NO. TS-675B

BRUNING 44-511 19927