F.H.W.A. REGION NO.	STATE	FED. AID PROJ. NO.	SHEET NO.	TOTAL SHEETS
3	MD.	HES-0005(61)	2	5

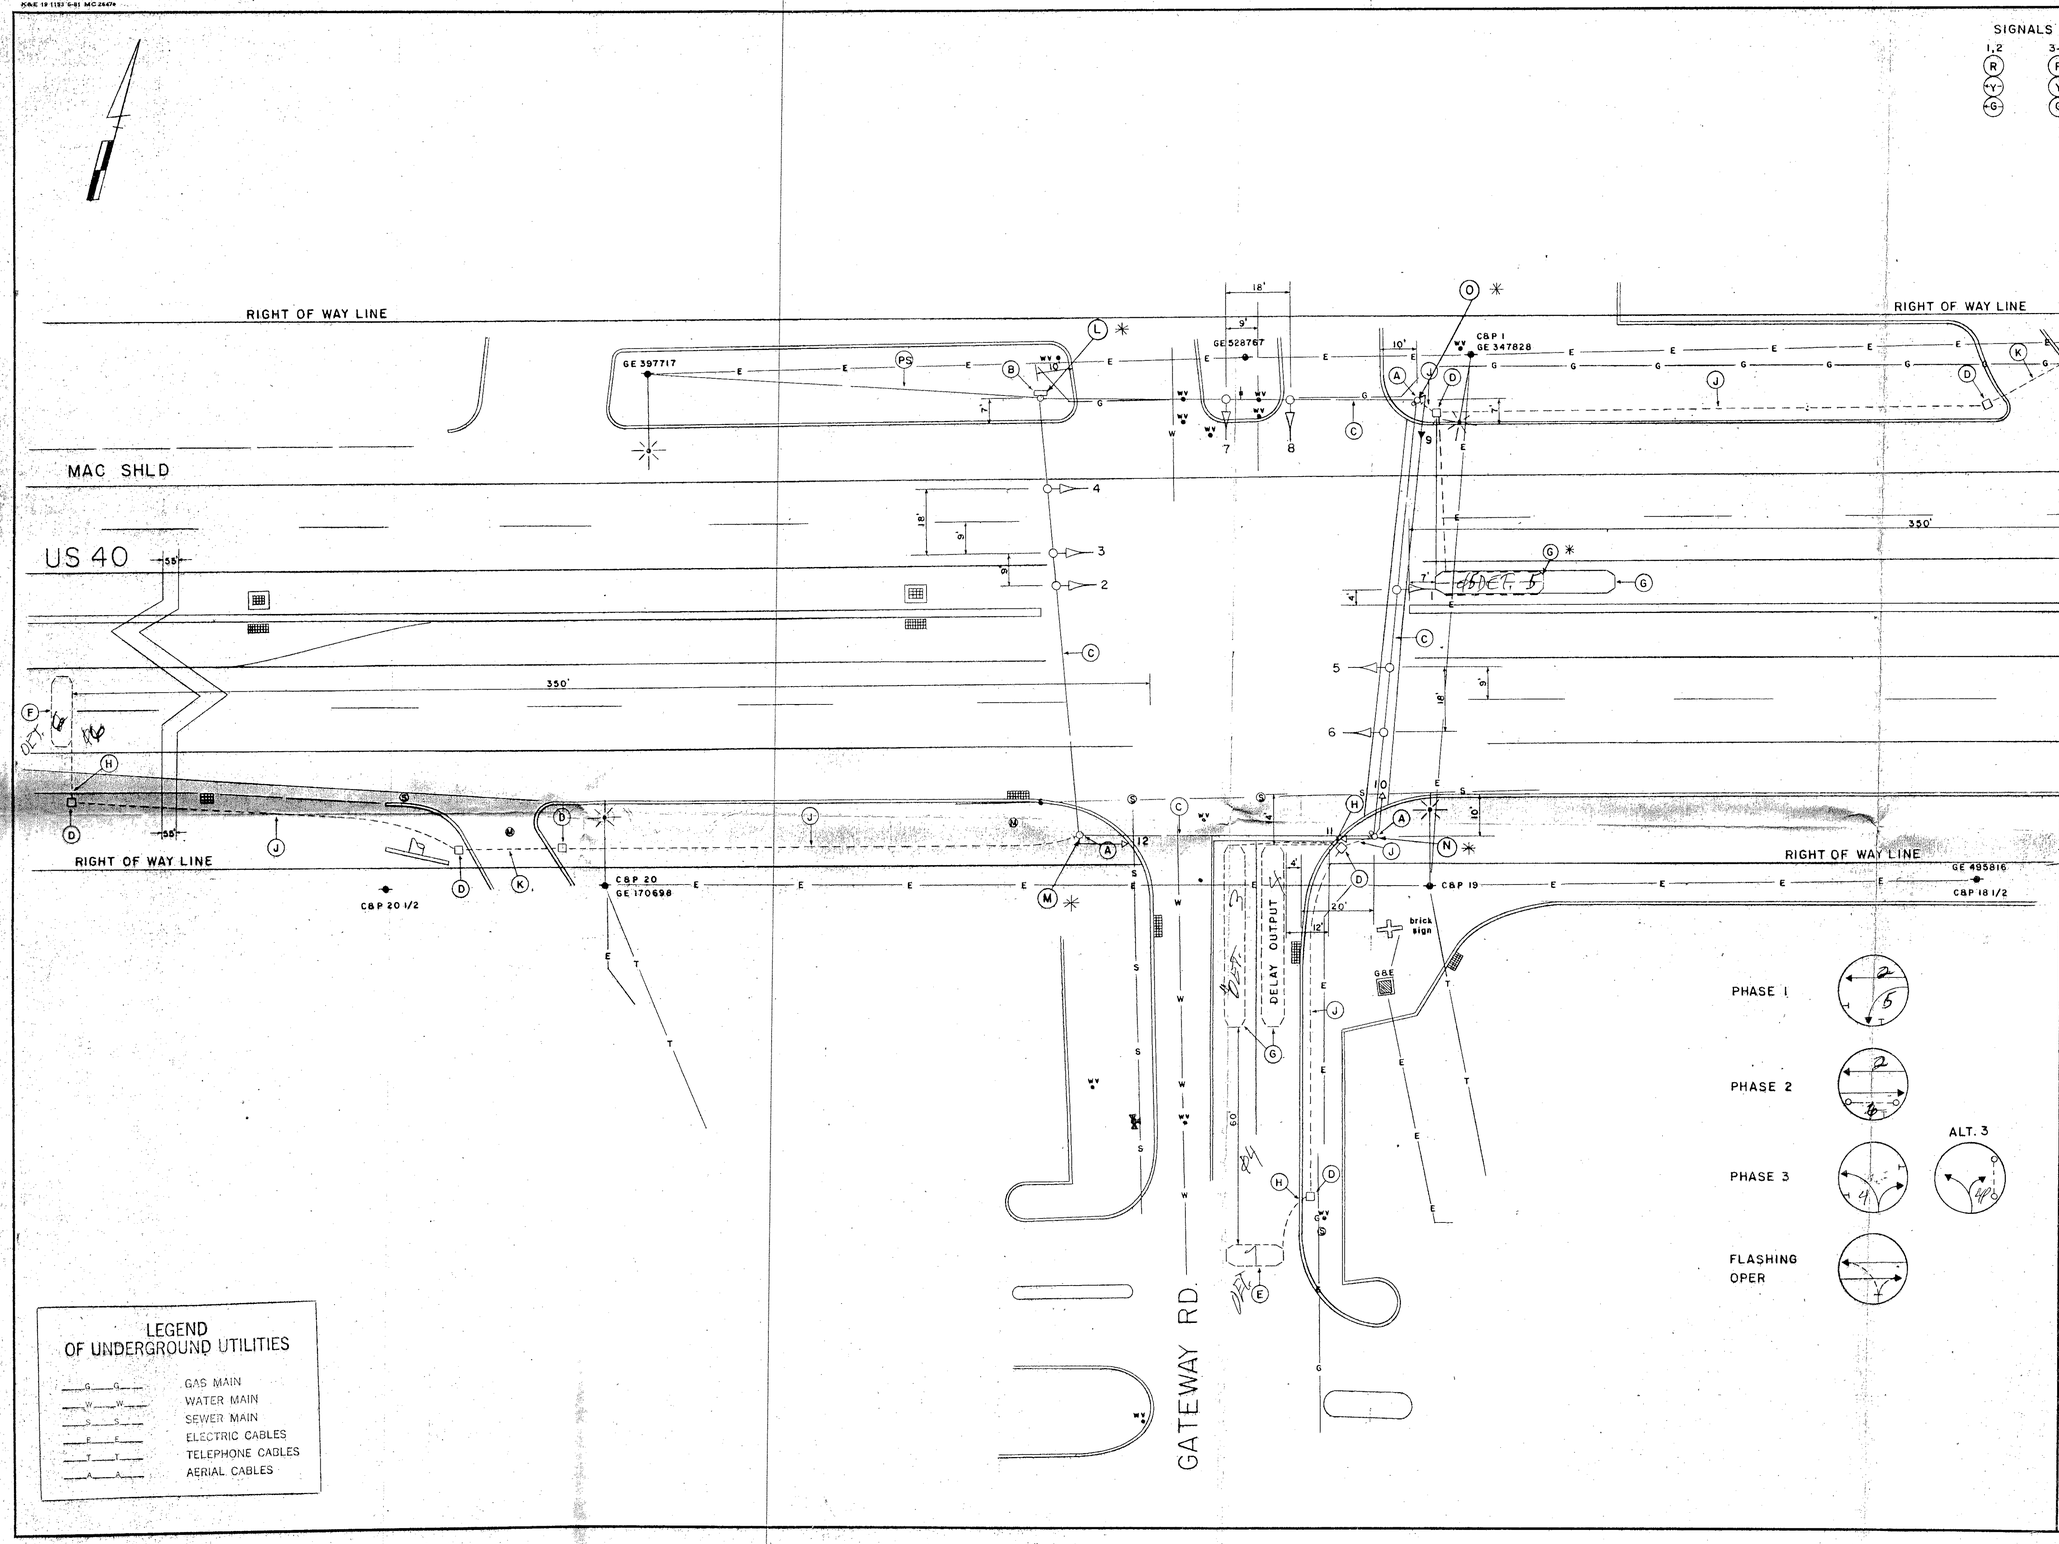

APPROVAL: CHIEF SIGNAL DESIGN SECTION 8/12/82

APPROVAL: REGIONAL TRAFFIC ENGINEER

APPROVAL: CHIEF BUREAU OF TRAFFIC ENGINEERING 9-1-82

APPROVAL: ASS'T. CHIEF ENGINEER TRAFFIC 9/3/82

A 2-1-84
REVISE PED PHASE
RE-CUT L.T. LOOP DET.
AW-603-504-476

SR

REVISIONS

STATE OF MARYLAND
DEPARTMENT OF TRANSPORTATION
STATE HIGHWAY ADMINISTRATION

TRAFFIC DIVISION – BUREAU OF TRAFFIC ENGINEERING

US 40 & GATEWAY RD.

SURVEY BK. 20776

SCALE 1" = 20' DATE 4-19-82 CONTRACT NO. AW-603-504-476

DRAWN BY: J GORDON COUNTY: HARFORD

DESIGNED BY: SIGNAL NO.:

CHECKED BY:

RECEIVED FEB 22 1984 TRAFFIC SIGNAL SHOP

DRAWING NO. TS-1860

12004003.08