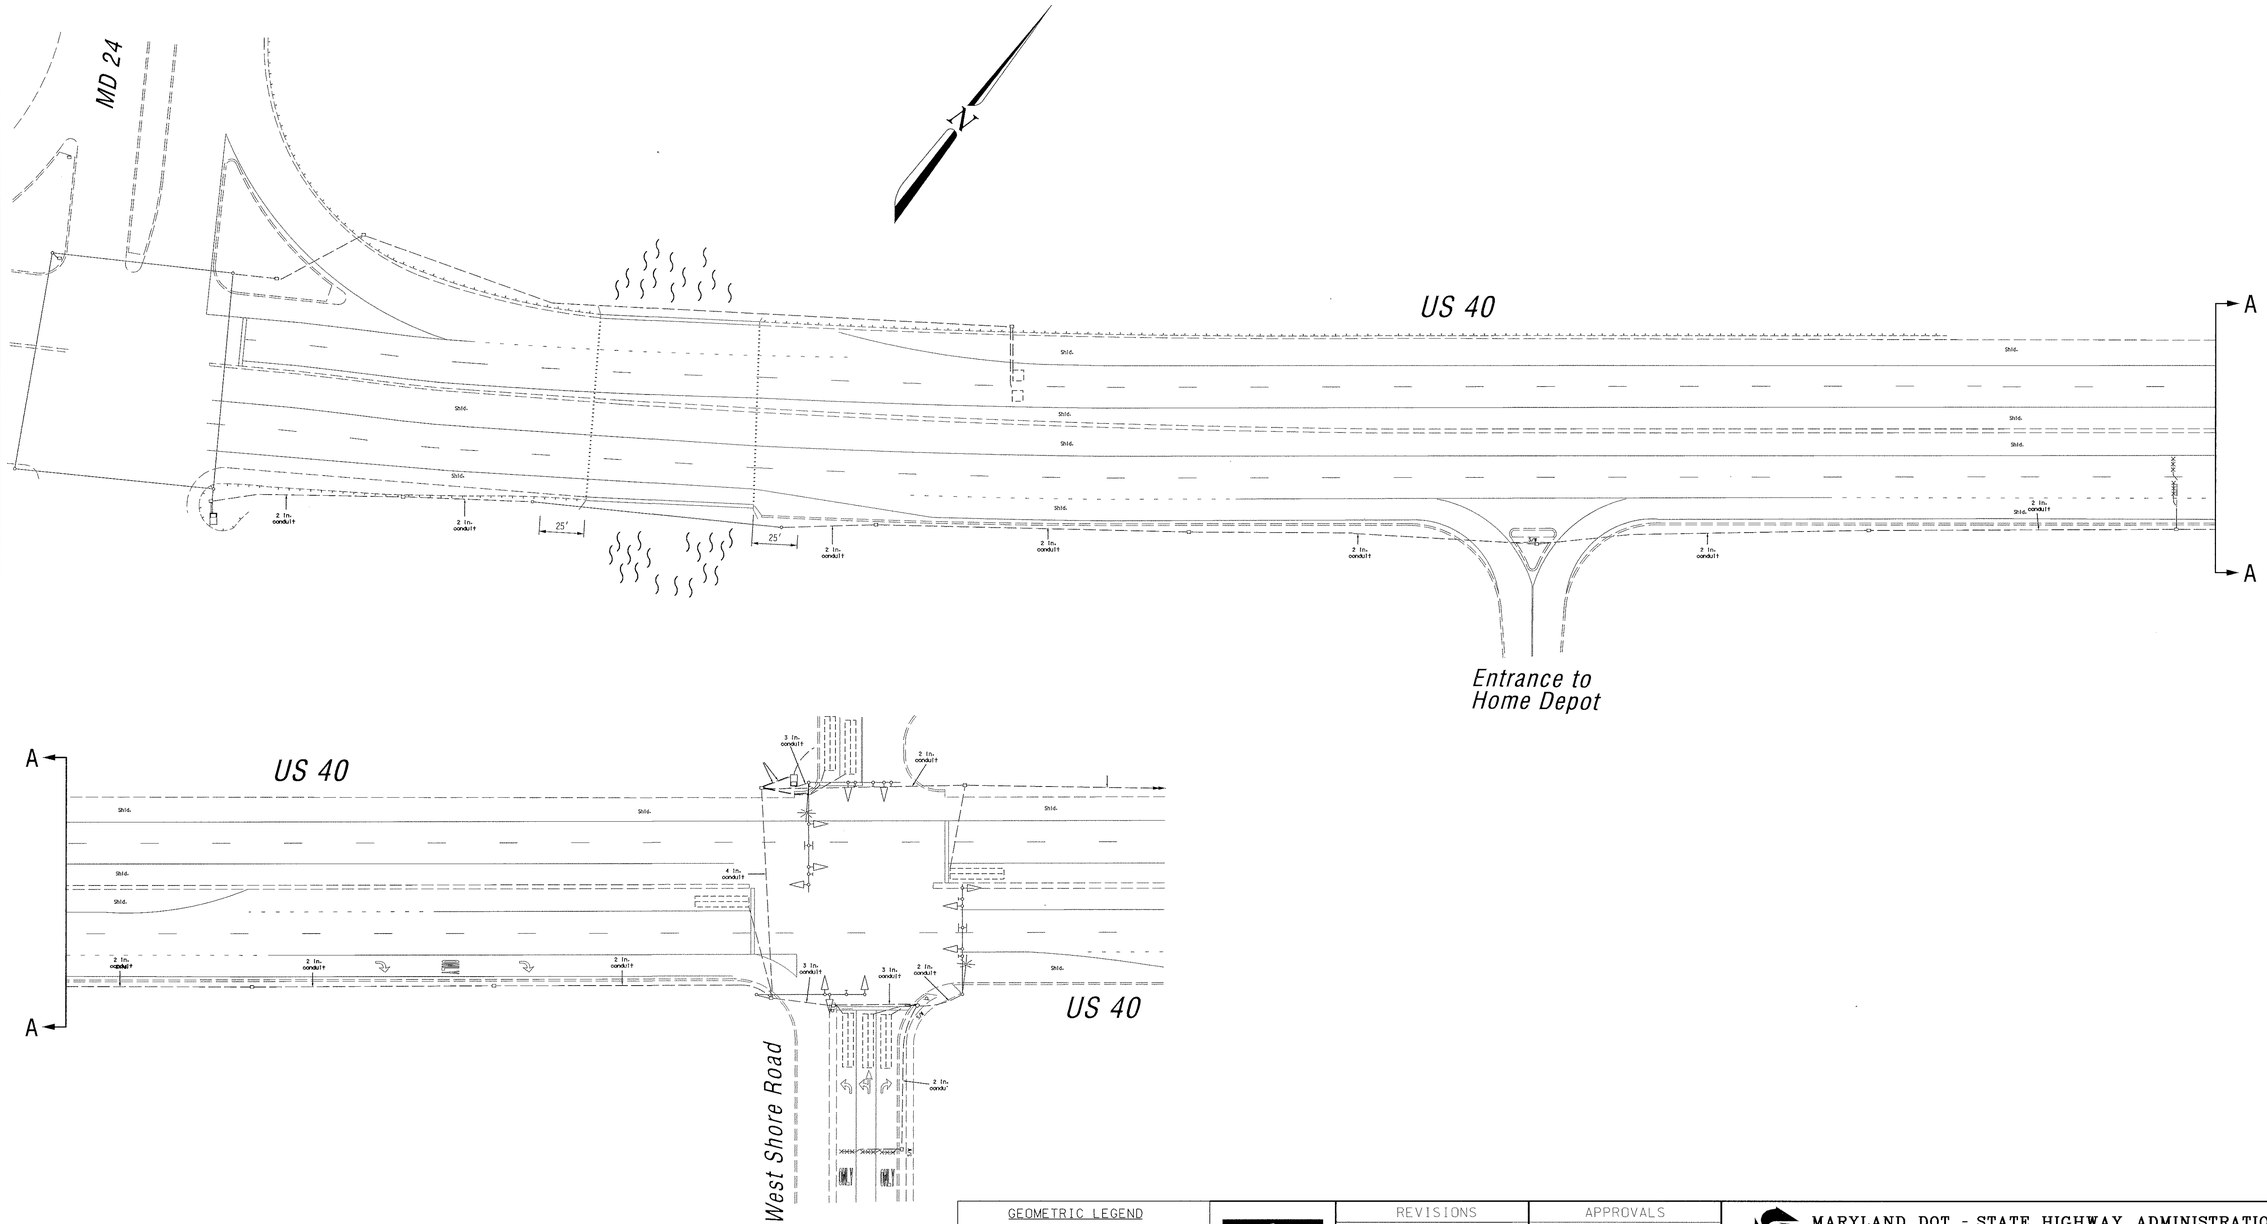

GEOMETRIC LEGEND

EXISTING GEOMETRICS
PROPOSED GEOMETRICS

UTILITY LEGEND

G	GAS MAIN
W	WATER MAIN
S	SEWER MAIN
E	ELECTRIC CABLES
D	STORM DRAIN
A	AERIAL CABLES
T	TELEPHONE CABLES

The Traffic Group

The Traffic Group, Inc.
410-931-6600
Fax 410-931-6601

REVISIONS

"As Built" March 4, 2002
S.H.A. No.:BW996M82
rmd

APPROVALS

TEAM LEADER, TRAFFIC ENGINEERING DESIGN DIVISION

ASST. CHIEF TRAFFIC ENGINEERING DESIGN DIVISION

CHIEF, TRAFFIC ENGINEERING DESIGN DIVISION

DIRECTOR, TRAFFIC & SAFETY

MARYLAND DOT - STATE HIGHWAY ADMINISTRATION
Office of Traffic & Safety
TRAFFIC ENGINEERING DESIGN DIVISION
(Interconnect Plan)

US 40 from MD 24 to West Shore Road

DRAWN BY:	Frank Hoeckel	F.A.P. NO.	N/A	TS NO. 4078-IC	SHEET NO.
CHECKED BY:		S.H.A. NO.	BW996M82		
SCALE:	1" = 40'	COUNTY:	Harford	T.I.M.S. NO. E-376	1 OF 1
DATE:	March 21, 2001	LOG MILE:			

f:\1999\901129\des\ob-ic-plan.dgn 04 MAR 2002