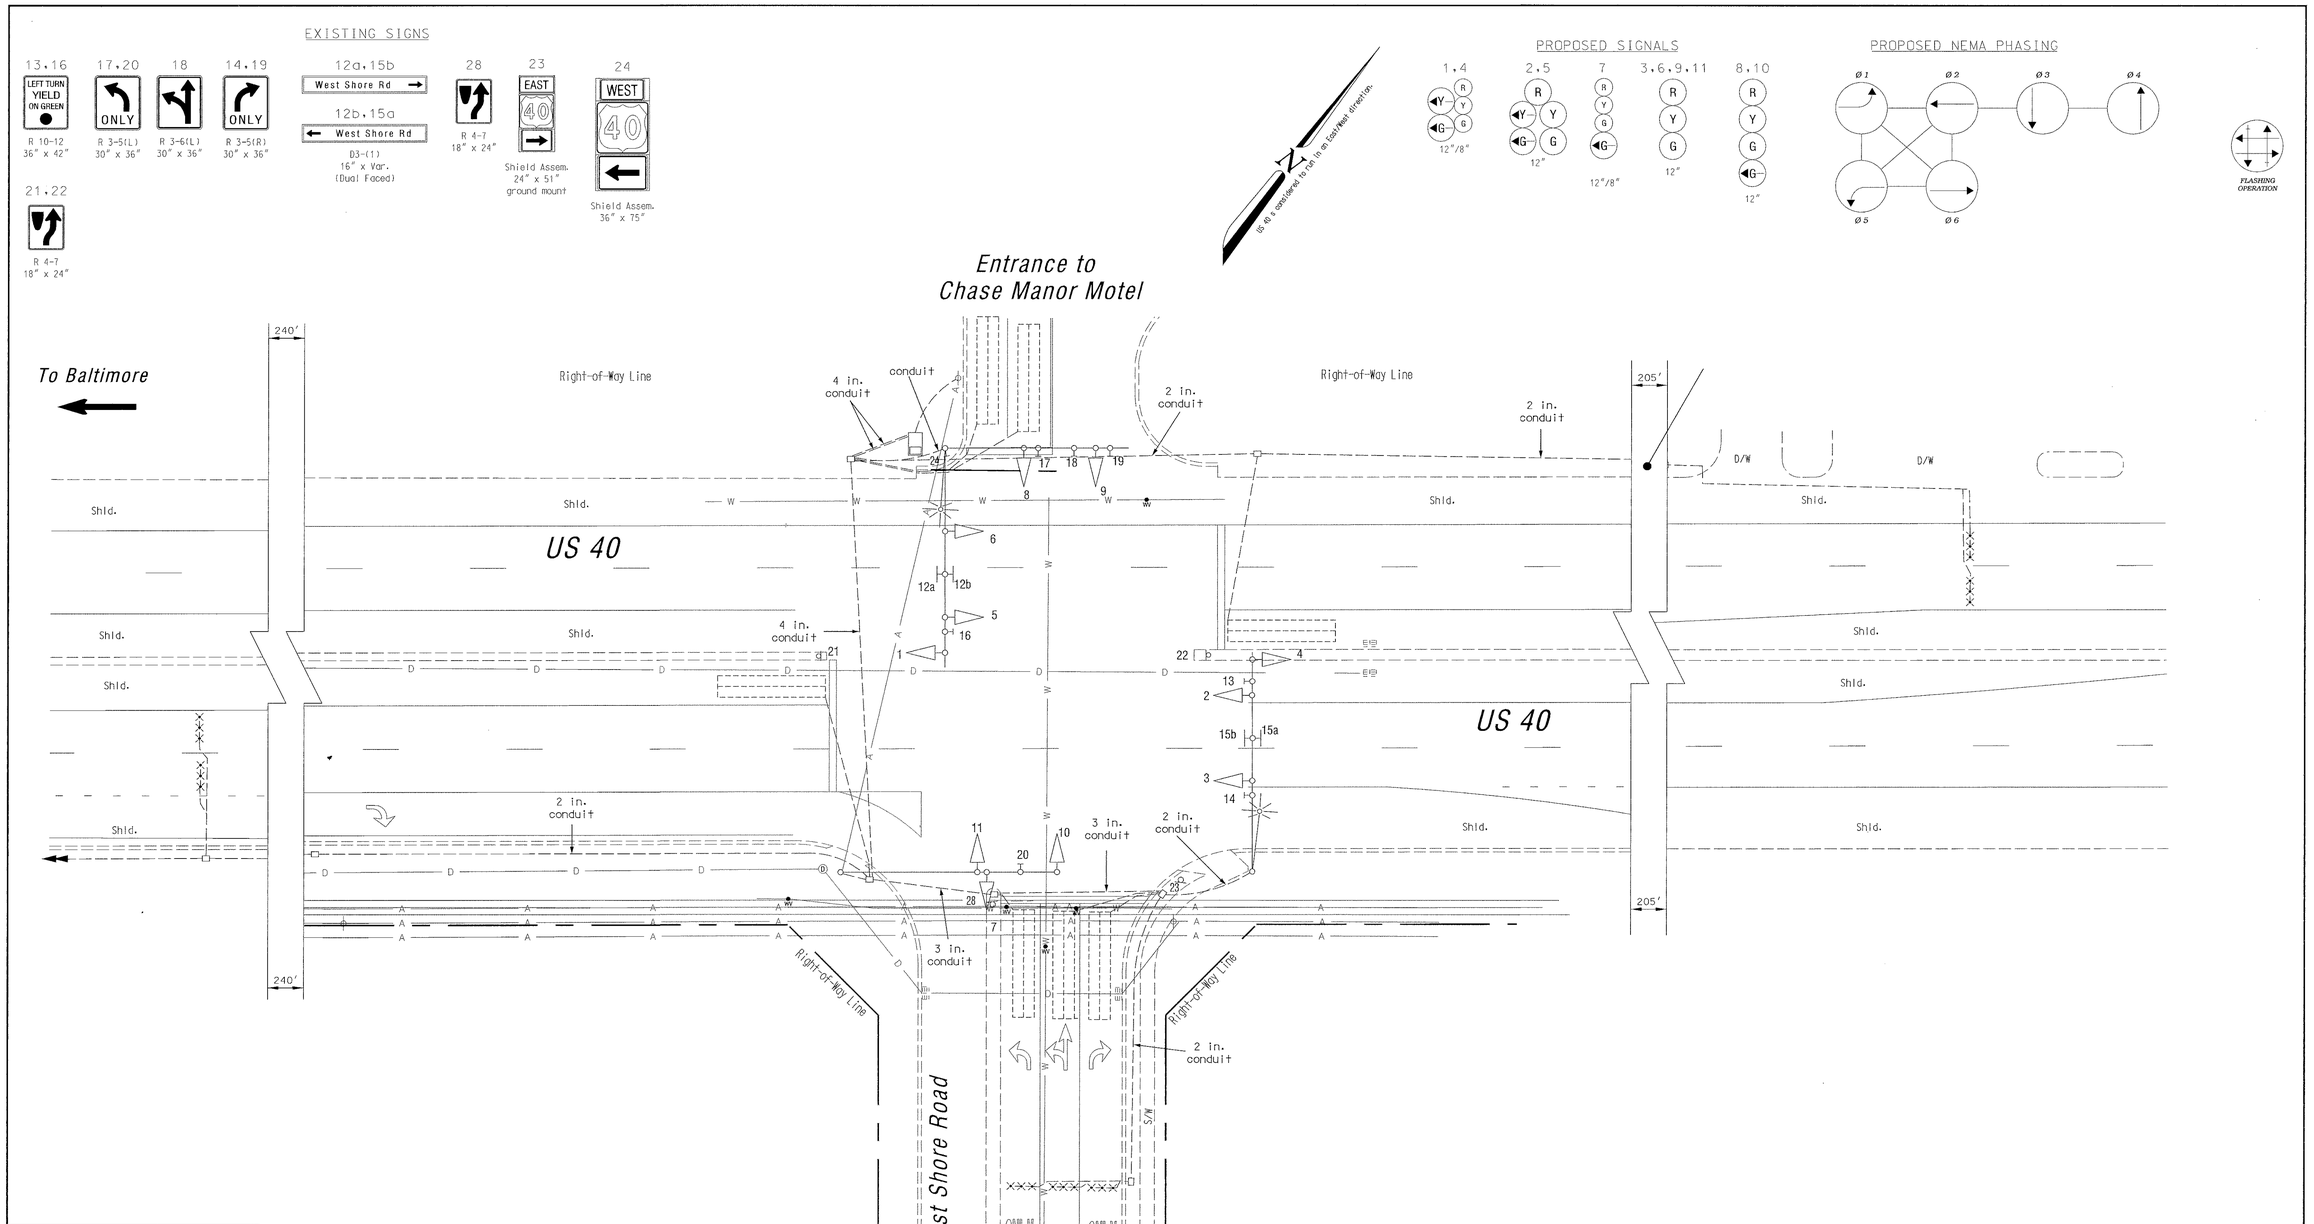

GEOMETRIC LEGEND

EXISTING GEOMETRICS

PROPOSED GEOMETRICS

UTILITY LEGEND

G	GAS MAIN
W	WATER MAIN
S	SEWER MAIN
E	ELECTRIC CABLES
D	STORM DRAIN
A	AERIAL CABLES
T	TELEPHONE CABLES

The Traffic Group

The Traffic Group, Inc.
410-931-6600
Fax 410-931-6601

REVISIONS	APPROVALS
	TEAM LEADER, TRAFFIC ENGINEERING DESIGN DIVISION
	ASST. CHIEF TRAFFIC ENGINEERING DESIGN DIVISION
"As Built" March 4, 2002	CHIEF, TRAFFIC ENGINEERING DESIGN DIVISION
S.H.A. No.:BW996M82	DIRECTOR, TRAFFIC & SAFETY
rmd	

MARYLAND DOT - STATE HIGHWAY ADMINISTRATION

Office of Traffic & Safety

TRAFFIC ENGINEERING DESIGN DIVISION

(Traffic Signal Plan)

US 40 at West Shore Road/Chase Manor Motel Entrance

DRAWN BY:	Frank Hoeckel	F.A.P. NO.	N/A	TS NO. 4078	SHEET NO.
CHECKED BY:		S.H.A. NO.	BW996M82		
SCALE:	1" = 20'	COUNTY:	Harford	T.I.M.S. NO. E-376	1 OF 1
DATE:	March 21, 2001	LOG MILE:			

f:\1999\991129\des\asbuilt.dgn 04 MAR 2002