DRILL HOLES

BORDER REV: DATE: June 1, 2004

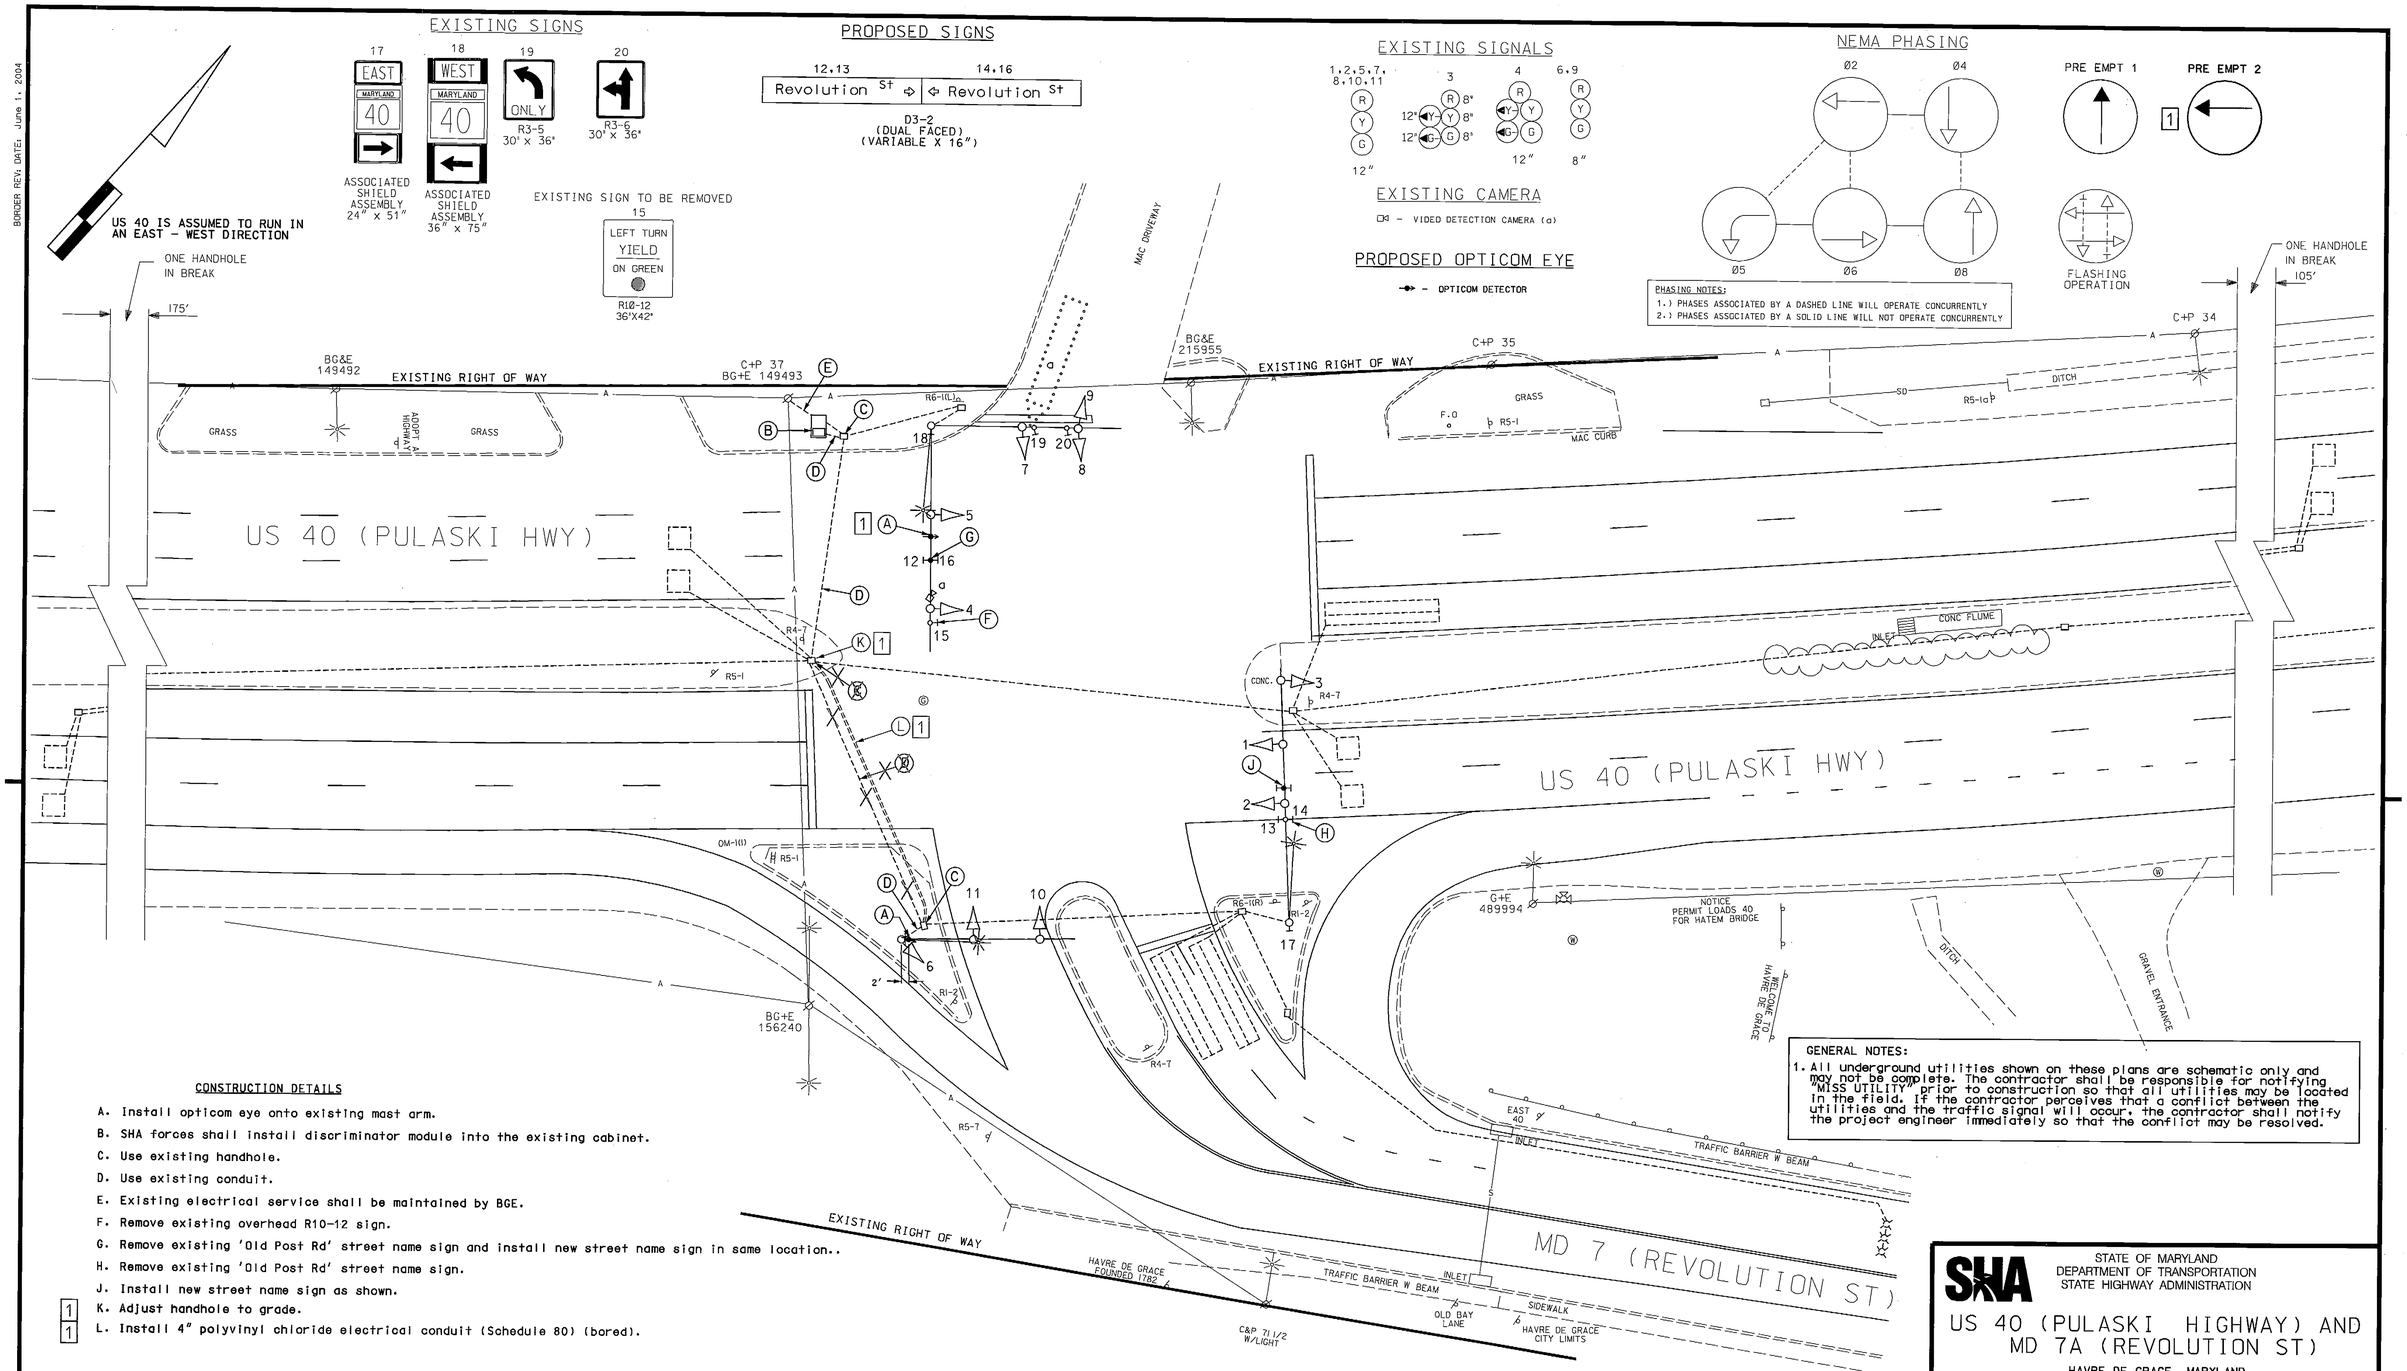

GENERAL NOTES:

1. All underground utilities shown on these plans are schematic only and may not be complete. The contractor shall be responsible for notifying "MISS UTILITY" prior to construction so that all utilities may be located in the field. If the contractor perceives that a conflict between the utilities and the traffic signal will occur, the contractor shall notify the project engineer immediately so that the conflict may be resolved.

CONSTRUCTION DETAILS

A. Install opticom eye onto existing mast arm.
B. SHA forces shall install discriminator module into the existing cabinet.
C. Use existing handhole.
D. Use existing conduit.
E. Existing electrical service shall be maintained by BGE.
F. Remove existing overhead R10-12 sign.
G. Remove existing 'Old Post Rd' street name sign and install new street name sign in same location..
H. Remove existing 'Old Post Rd' street name sign.
J. Install new street name sign as shown.
1 K. Adjust handhole to grade.
1 L. Install 4" polyvinyl chloride electrical conduit (Schedule 80) (bored).

GEOMETRIC LEGEND
PROPOSED
EXISTING

LEGEND OF UNDERGROUND AND OVERHEAD UTILITIES
AERIAL CABLE — A — A —
ELECTRIC — E — E —
TELEPHONE — T — T —
GAS — G — G —
SEWER — S — S —
WATER — W — W —
CABLE TV — TV — TV —

1 REDLINE REVISION 2/11/09
TEDD APPROVAL

1 GREENLINE REVISION 11/25/08
TEDD APPROVAL

REVISION "J"

STREET TRAFFIC STUDIES, LTD.
400 Crain Hwy.N.W.
Glen Burnie,MD 21061
Ph (410) 590-5500
Fax (410) 590-6637

5506a.dgn 5506a.dgn

APPROVALS
TEAM LEADER
ASST. DIV. MGR.
DIVISION CHIEF
OFFICE DIRECTOR
ORIGINAL ON FILE

REVISIONS
(4) 7-9-08 INSTALL OPTICOM DETECTOR EYE
SHA NO: XX4485185 TIMS: 1841
JWA WM DJD
H REDLINE 1 NEW SHEET 9/12/03
RELOCATE MAST ARM FOUNDATION AND ADJUST HANDHOLE HA2195177
KMP DBD MR DAZ BRK
G 3/5/99
REBUILD TRAFFIC SIGNAL AND ADD INTERCONNECT
NML DJD DAZ BRK TH

PLOTTED: @DATETIME@
FILE: @FILE@

STATE OF MARYLAND
DEPARTMENT OF TRANSPORTATION
STATE HIGHWAY ADMINISTRATION

US 40 (PULASKI HIGHWAY) AND MD 7A (REVOLUTION ST)

HAVRE DE GRACE, MARYLAND

TRAFFIC SIGNAL PLAN

SCALE 1"= 20' DATE JULY 22, 1972 CONTRACT NO. AW526A58/B58

DESIGNED BY
DRAWN BY L. TOWNSEND
CHECKED BY H.K.
F.A.P. NO.
COUNTY HARFORD
LOGMILE 12004016.30
TIMS NO. 1841
TOD NO.

TS NO. 630H | DRAWING NO. 3 OF 5 | SHEET NO. OF

C:\500\35506\5506a1500a.dgn 2/12/2009 11:35:50 AM