F.H.WA REGION NO	STATE	FED. AID PROJ. NO	SHEET NO.	TOTAL SHEETS
3	MD.	CMG-125-1 (15)	9	12

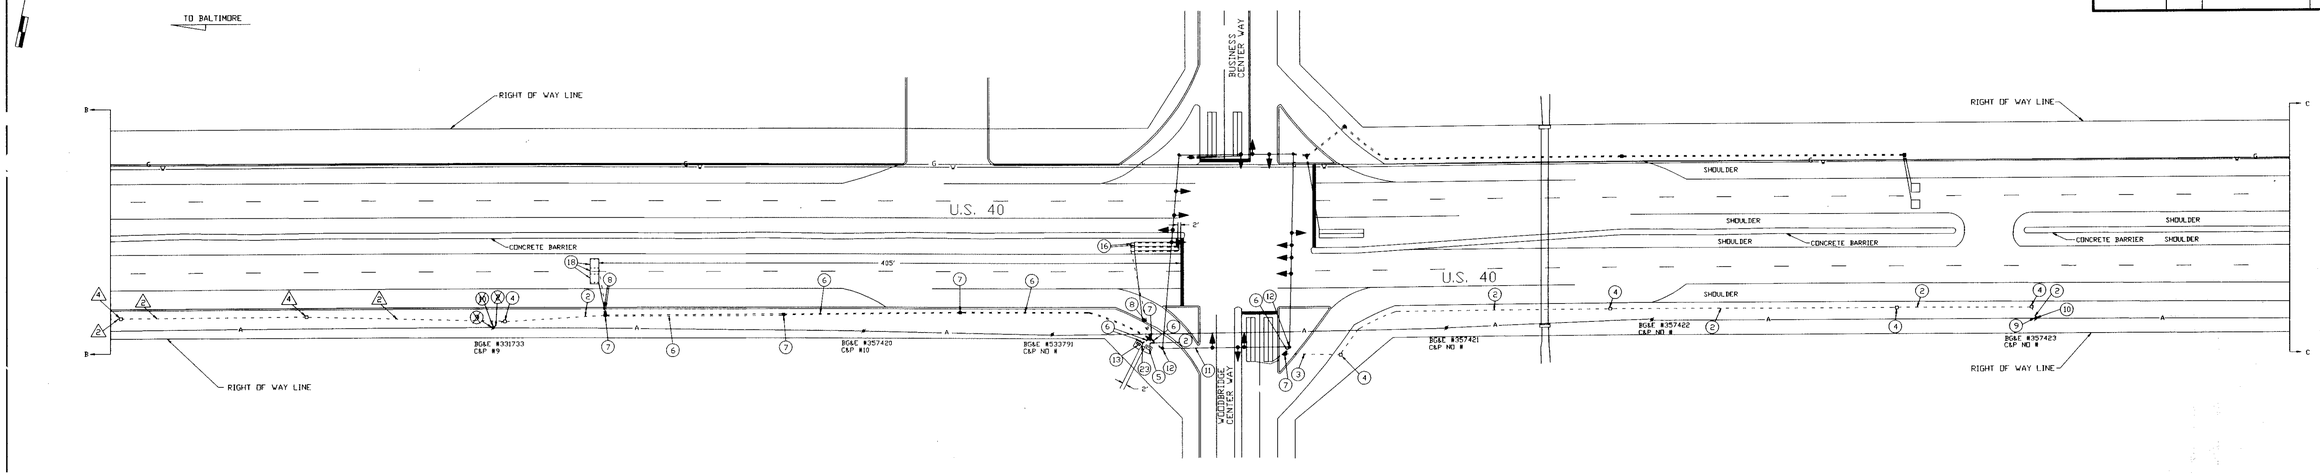

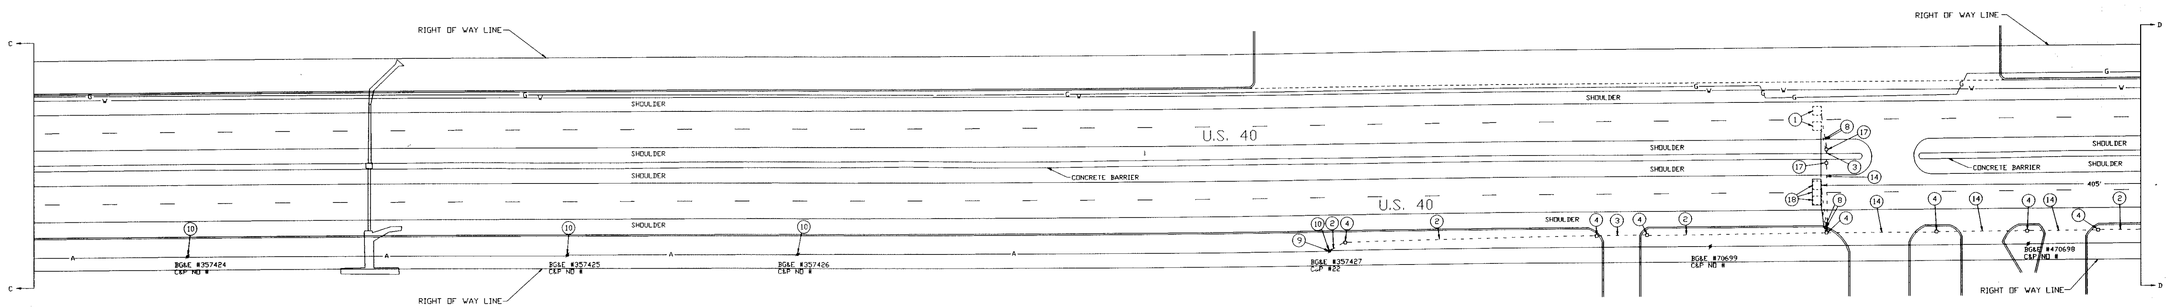

TO ABERDEEN

REVISIONS	APPROVALS
A. 05/93 REDRAWN W.M.	CHIEF, SIGNAL DESIGN SECTION
1. 05/93 - RELOCATED SOME O/H TELEMETRY CABLE TO UNDERGROUND SHA # H-933-501-485 W.M.	ASST. DISTRICT ENGINEER, TRAFFIC
	CHIEF, TRAFFIC ENGINEERING DESIGN DIVISION
	DIRECTOR, OFFICE OF TRAFFIC & SAFETY

MDOT – STATE HIGHWAY ADMINISTRATION

Office of Traffic & Safety

TRAFFIC ENGINEERING DESIGN DIVISION

SIGNAL # 12004002.12

DRAWN BY: W. Malcolm

DES. BY: W. Malcolm

CHK. BY:

U.S. 40 (PULASKI HIGHWAY) FROM MD. 152 TO MD. 755

COUNTY: HARFORD

DATE: 08/92

SCALE: 1" = 50'

F.A.P. NO. CMG-125-1 (15)

S.H.A. NO. H-933-501-485

TS/STD. NO. TS-3252X B

SHEET NO. 9 OF 12

UTILITY LEGEND

—G—G—	GAS MAIN
—V—V—	WATER MAIN
—S—S—	SEWER MAIN
—E—E—	ELECTRIC CABLES
—A—A—	AERIAL CABLES
—T—T—	TELEPHONE CABLES

F#27

12004002.12