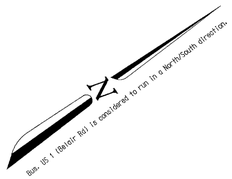


EXISTING SIGNALS

1.2.3.4

R
Y
Y

12"/8"

EXISTING SIGNS

5a
Auction Way →

5b
← Auction Way

D 3-2
16" x Var.
(Dual-faced)

6
Auction Way
W 2-2
D-3(2)

7
Broadview Ave.
W 2-2
D-3(2)

8
Auction Way
W 2-2
D-3(2)

9
STOP
R1-1

10-13
R 7-11

14
Auction Way
D-3

NEMA PHASING

NORMAL OPERATION

SPECIAL OPERATION




GEOMETRIC LEGEND

EXISTING GEOMETRICS
PROPOSED GEOMETRICS

UTILITY LEGEND

| | |
|---|---|
| G | GAS MAIN |
| W | WATER MAIN |
| S | SEWER MAIN |
| E | ELECTRIC CABLES |
| D | STORM DRAIN |
| A | AERIAL CABLES |
| T | TELEPHONE CABLES |

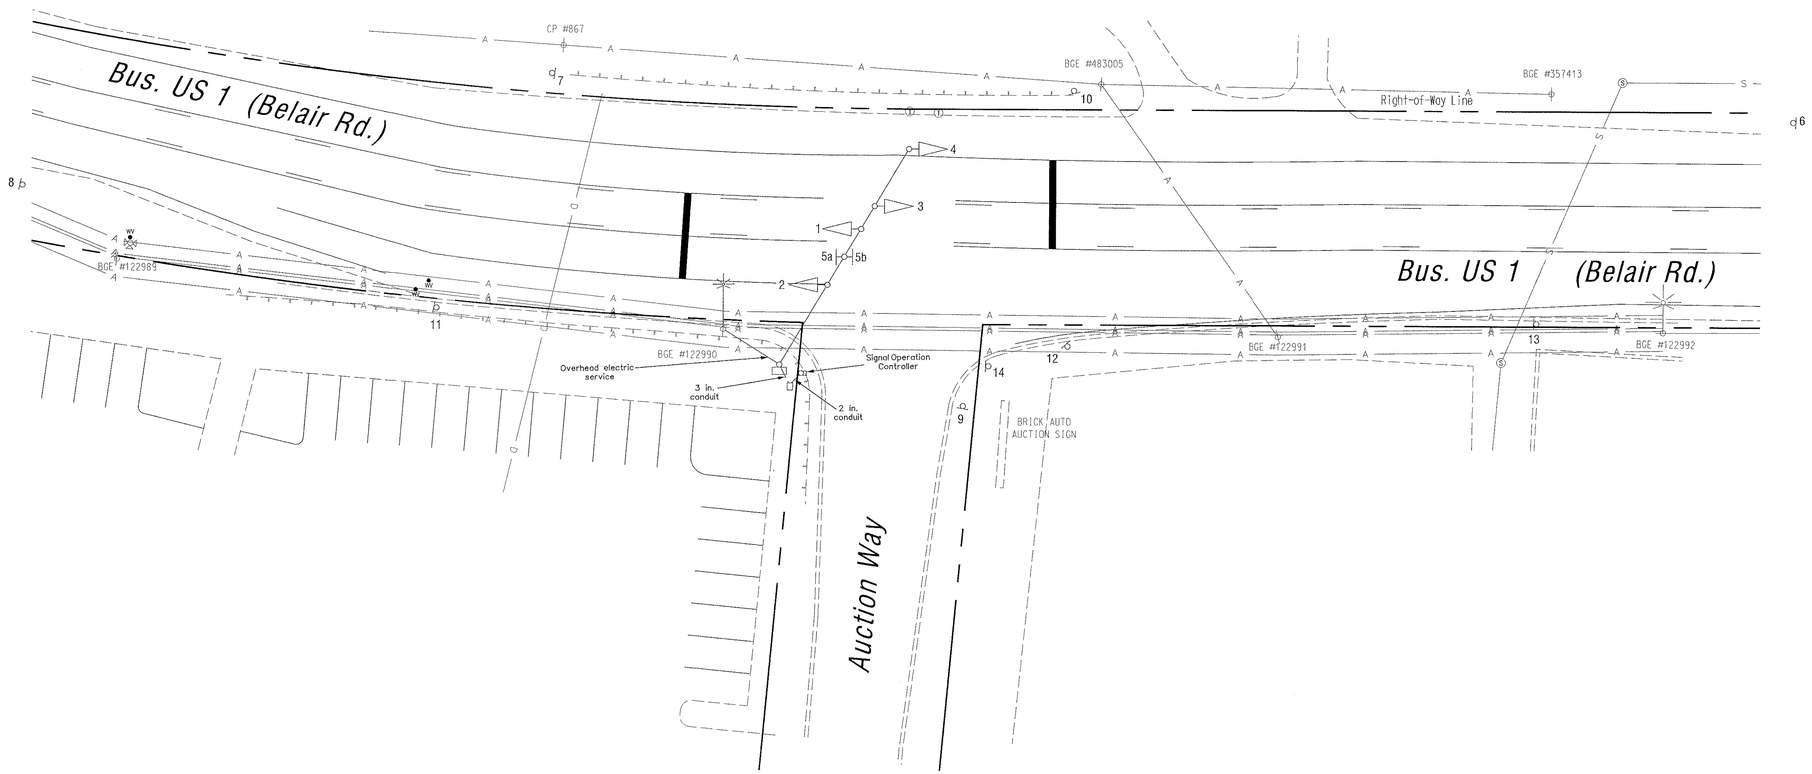The Traffic Group
The Traffic Group, Inc.
410-931-6600
Fax 410-931-6601

REVISIONS

March 28, 2002
"As Built"
S.H.A. No.:BW996M82
rmd

APPROVALS

TEAM LEADER, TRAFFIC ENGINEERING DESIGN DIVISION

ASST. CHIEF TRAFFIC ENGINEERING DESIGN DIVISION

CHIEF, TRAFFIC ENGINEERING DESIGN DIVISION

DIRECTOR, TRAFFIC & SAFETY

MARYLAND DOT - STATE HIGHWAY ADMINISTRATION
*Office of Traffic & Safety*
TRAFFIC ENGINEERING DESIGN DIVISION
(Traffic Signal Plan)

*US Business Route 1 (Belair Rd.) at Auction Way*

| | | | | | |
|---|---|---|---|---|---|
| DRAWN BY: | F. Brownley | F.A.P. NO. | N/A | TS NO. | SHEET NO. |
| CHECKED BY: | | S.H.A. NO. | BW996M82 | 4100 | |
| SCALE: | 1" = 20' | COUNTY: | Harford | T.I.M.S. NO. | |
| DATE: | June 25, 2001 | LOG MILE: | 12B00100.00 | D-959 | 1 OF 1 |

F:\2000\2000-1023\Des\asbuilt.dgn 03/28/2002