F.H.W.A. REGION NO.	STATE	FED. AID PROJ. NO.	SHEET NO.	TOTAL SHEETS
3	MD.		19	26

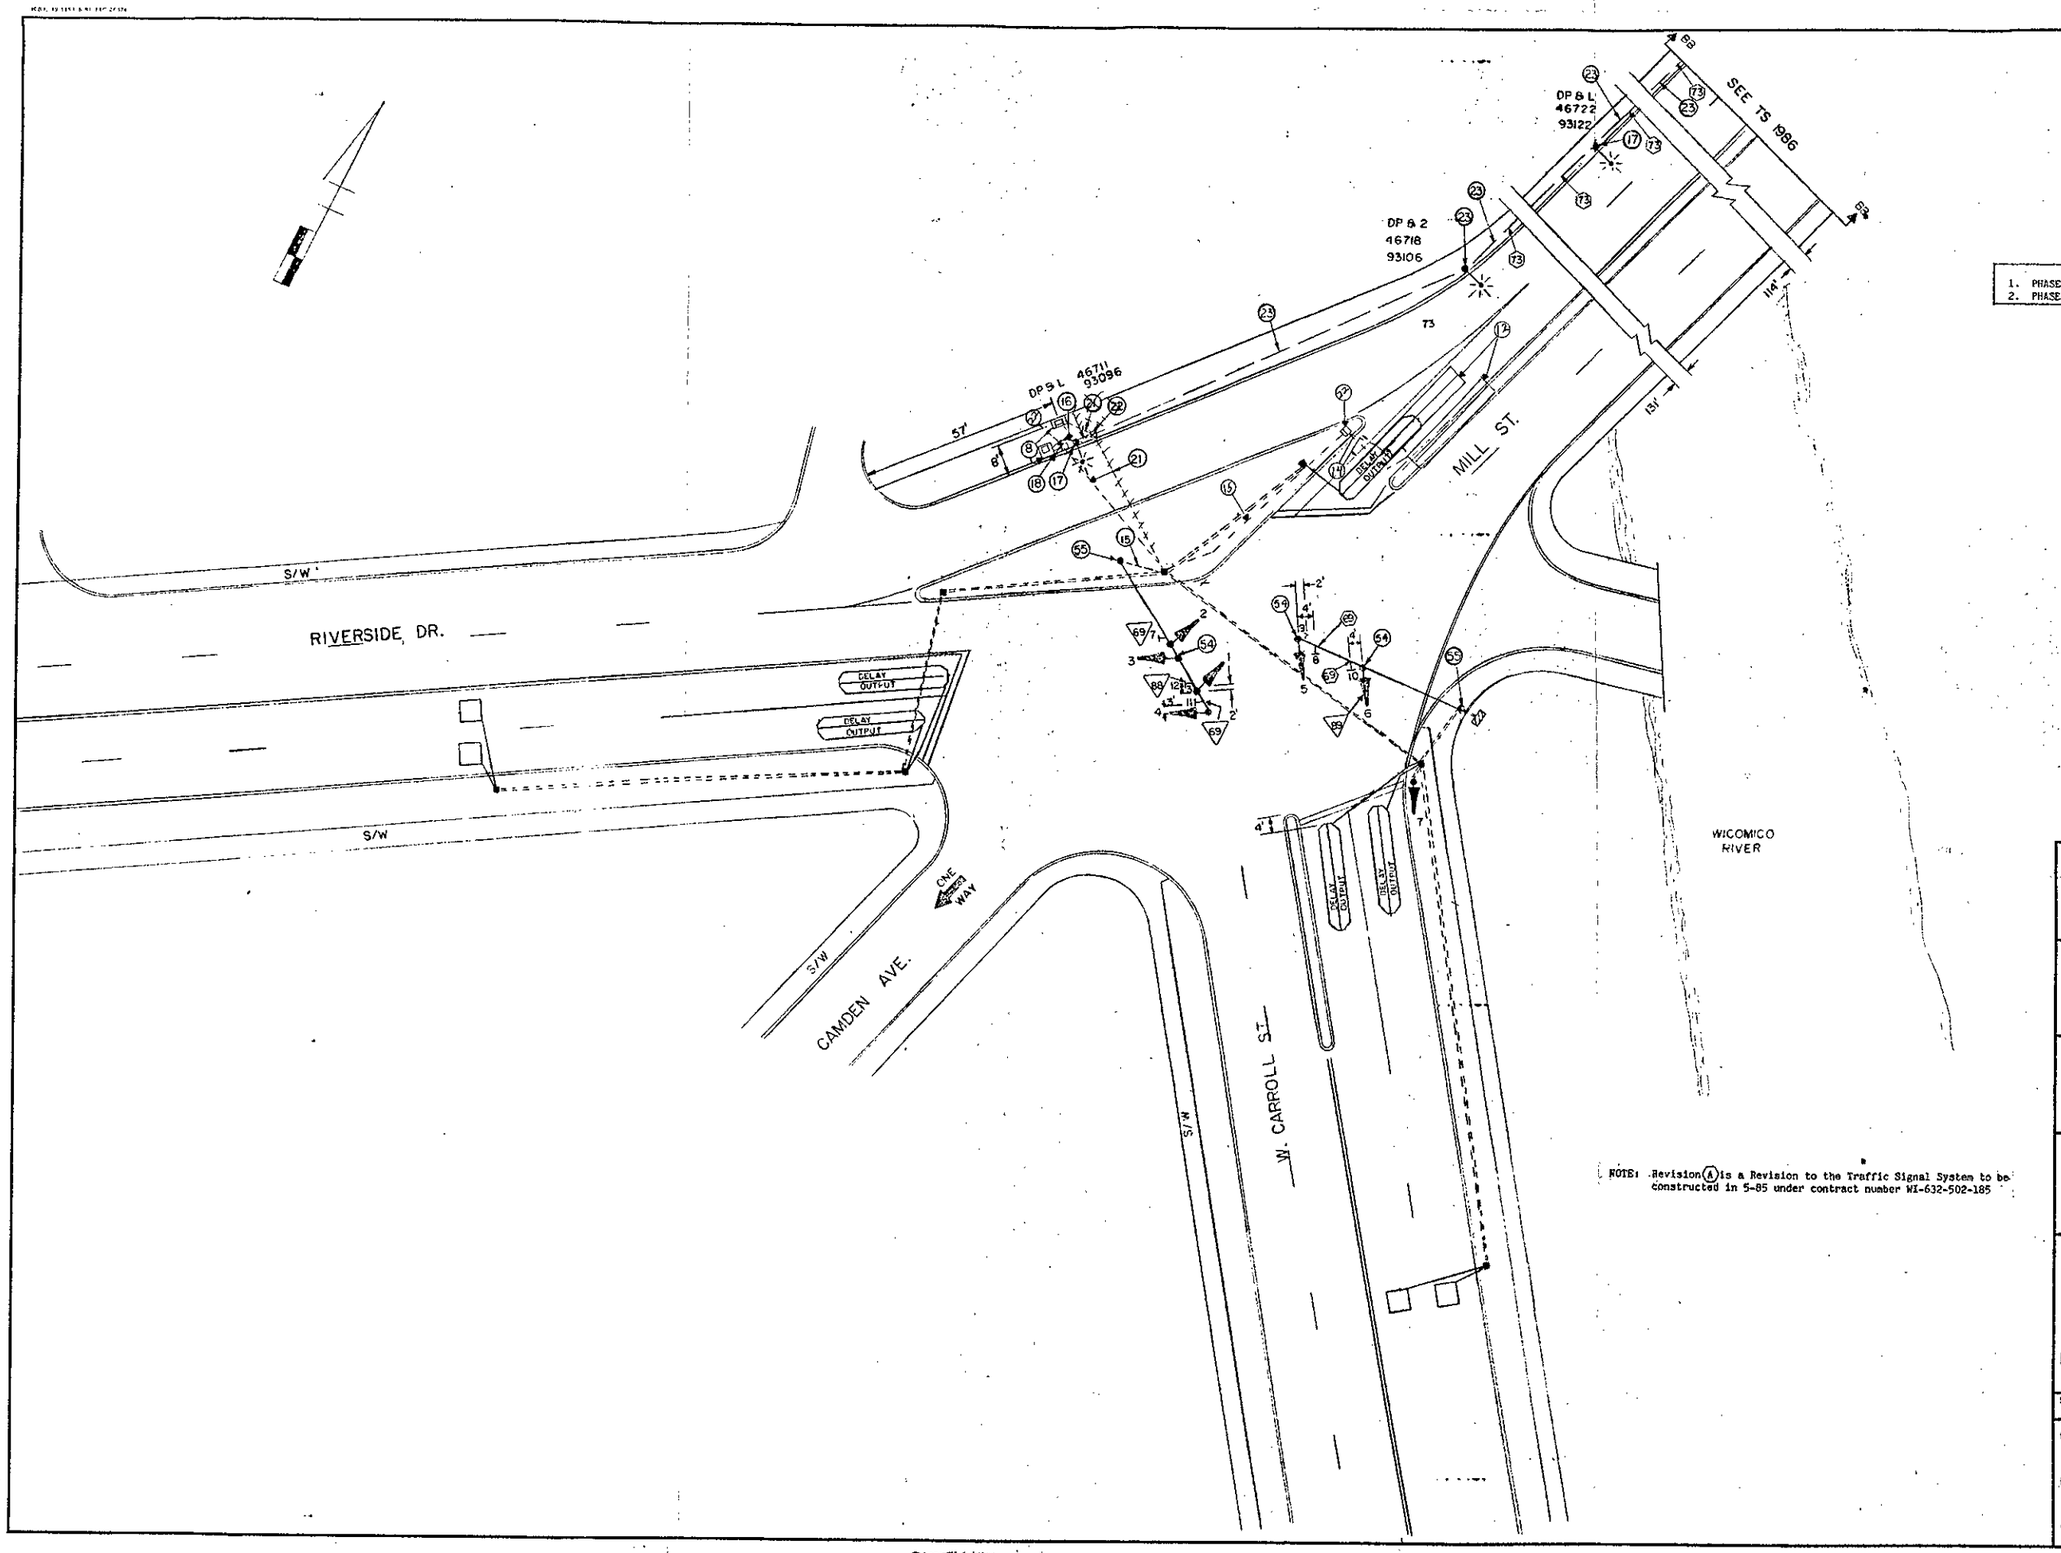

NOTE: Revision (A) is a Revision to the Traffic Signal System to be constructed in 5-85 under contract number WI-632-502-185

NEMA PHASING

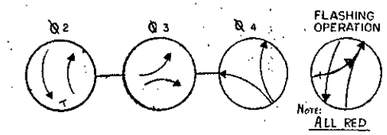

NEMA PHASING NOTES
1. PHASES ASSOCIATED BY A DASHED LINE WILL OPERATE CONCURRENTLY.
2. PHASES ASSOCIATED BY A SOLID LINE WILL NOT OPERATE CONCURRENTLY.

12" SIGNALS

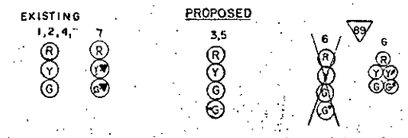

SIGNS

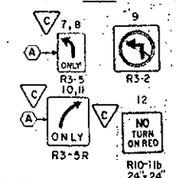

APPROVAL: CHIEF SIGNAL DESIGN SECTION

APPROVAL: DISTRICT TRAFFIC ENGINEER

APPROVAL: CHIEF-BUREAU OF TRAFFIC ENGINEERING

APPROVAL: DEPUTY- CHIEF ENGINEER - TRAFFIC

C 1-6-87, WI-632-502-185 ADD SIGNS, AND MODIFY SIGNAL HEAD NO. 6, NEW PHASING

B 8-25-86 INSTALL LOOP DETECTOR AND CONDUIT SHA No 835-25004

A 4-10-85 ADJUST SIGNAL HEADS, SIGNS AND PHASING

REVISIONS

STATE OF MARYLAND
DEPARTMENT OF TRANSPORTATION
STATE HIGHWAY ADMINISTRATION

OFFICE OF TRAFFIC — BUREAU OF TRAFFIC ENGINEERING

MILL ST. AT RIVERSIDE DR./ W. CARROLL ST.

SCALE 1" = 20' DATE 6/18/84 CONTRACT NO. WI 632-502-185

DRAWN BY: LISA BUCK COUNTY: WICOMICO

DESIGNED BY: SIGNAL NO.:

CHECKED BY: 9-10-84

DRAWING NO. TS-1967

23MCAR00.00