K&E 19 1153 6-81 MC 26474

F.H.W.A. REGION NO.	STATE	FED. AID PROJ. NO.	SHEET NO.	TOTAL SHEETS
3	MD.		10	18

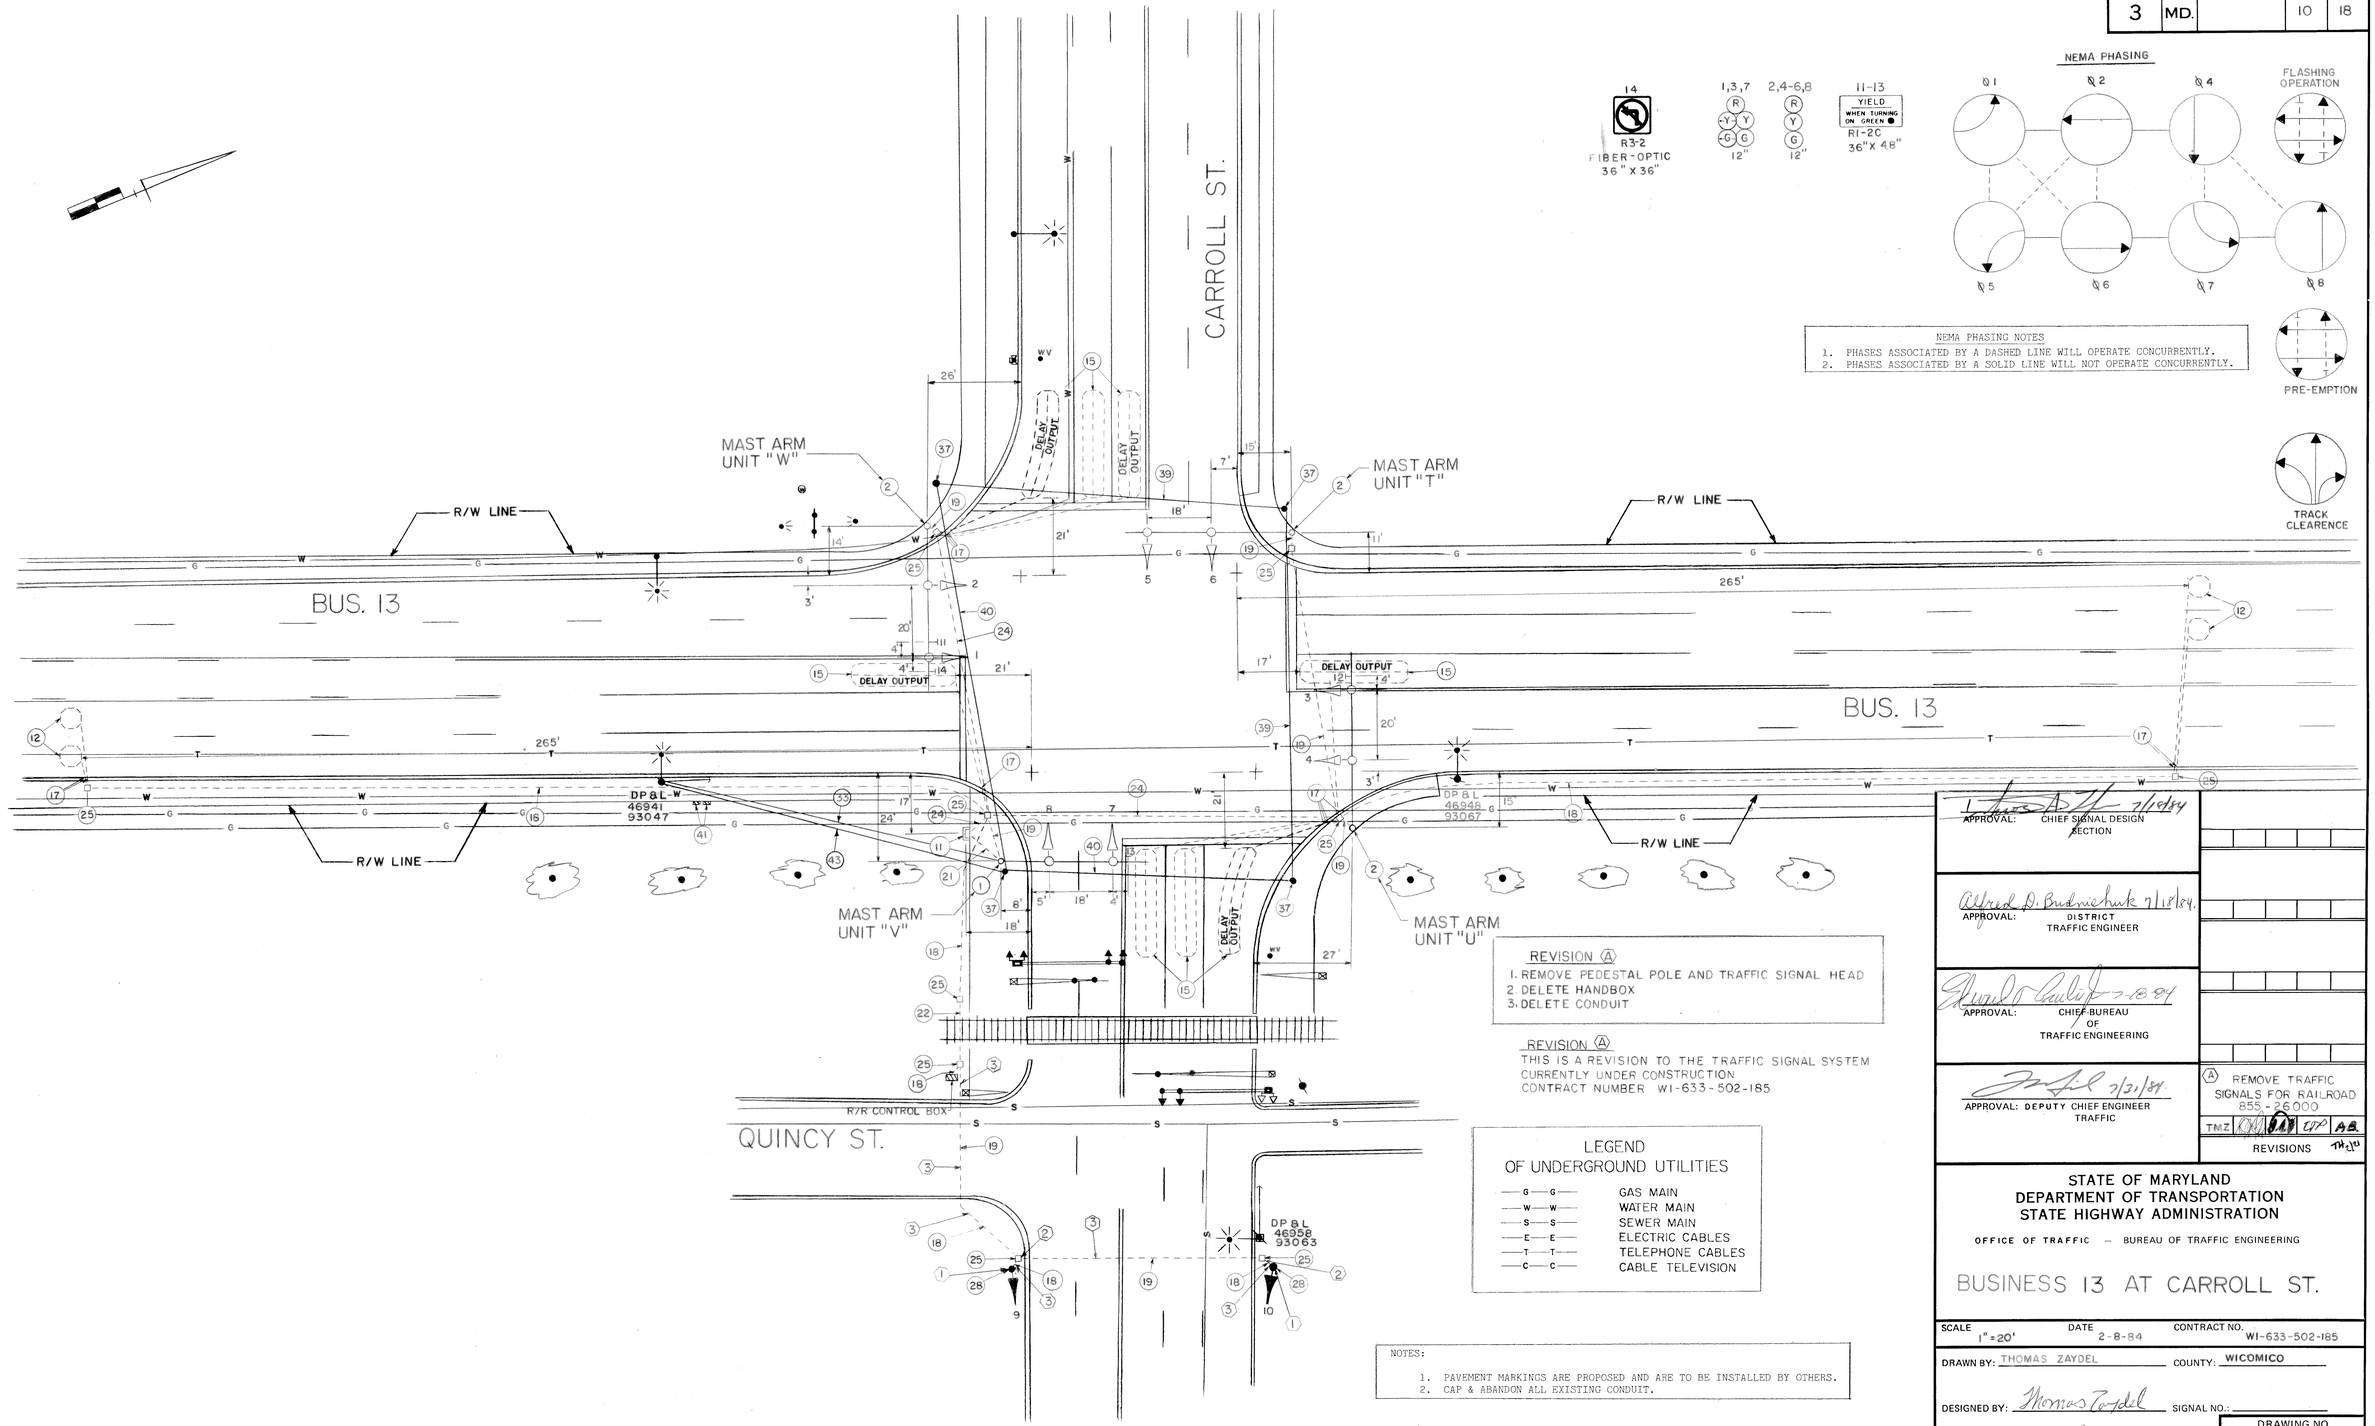

APPROVAL: CHIEF SIGNAL DESIGN SECTION 7/19/84

APPROVAL: DISTRICT TRAFFIC ENGINEER 7/18/84

APPROVAL: CHIEF BUREAU OF TRAFFIC ENGINEERING 7-18-84

APPROVAL: DEPUTY CHIEF ENGINEER TRAFFIC 7/20/84

(A) REMOVE TRAFFIC SIGNALS FOR RAILROAD 855-26000

TMZ | REVISIONS

STATE OF MARYLAND
DEPARTMENT OF TRANSPORTATION
STATE HIGHWAY ADMINISTRATION

OFFICE OF TRAFFIC — BUREAU OF TRAFFIC ENGINEERING

BUSINESS 13 AT CARROLL ST.

SCALE 1" = 20' | DATE 2-8-84 | CONTRACT NO. WI-633-502-185

DRAWN BY: THOMAS ZAYDEL | COUNTY: WICOMICO

DESIGNED BY: Thomas Zaydel | SIGNAL NO.:

CHECKED BY: 8/12/84

DRAWING NO. TS-1939 A