F H WA REGION NO	STATE	FED. AID PROJ. NO	SHEET NO.	TOTAL SHEETS
3	MD.			

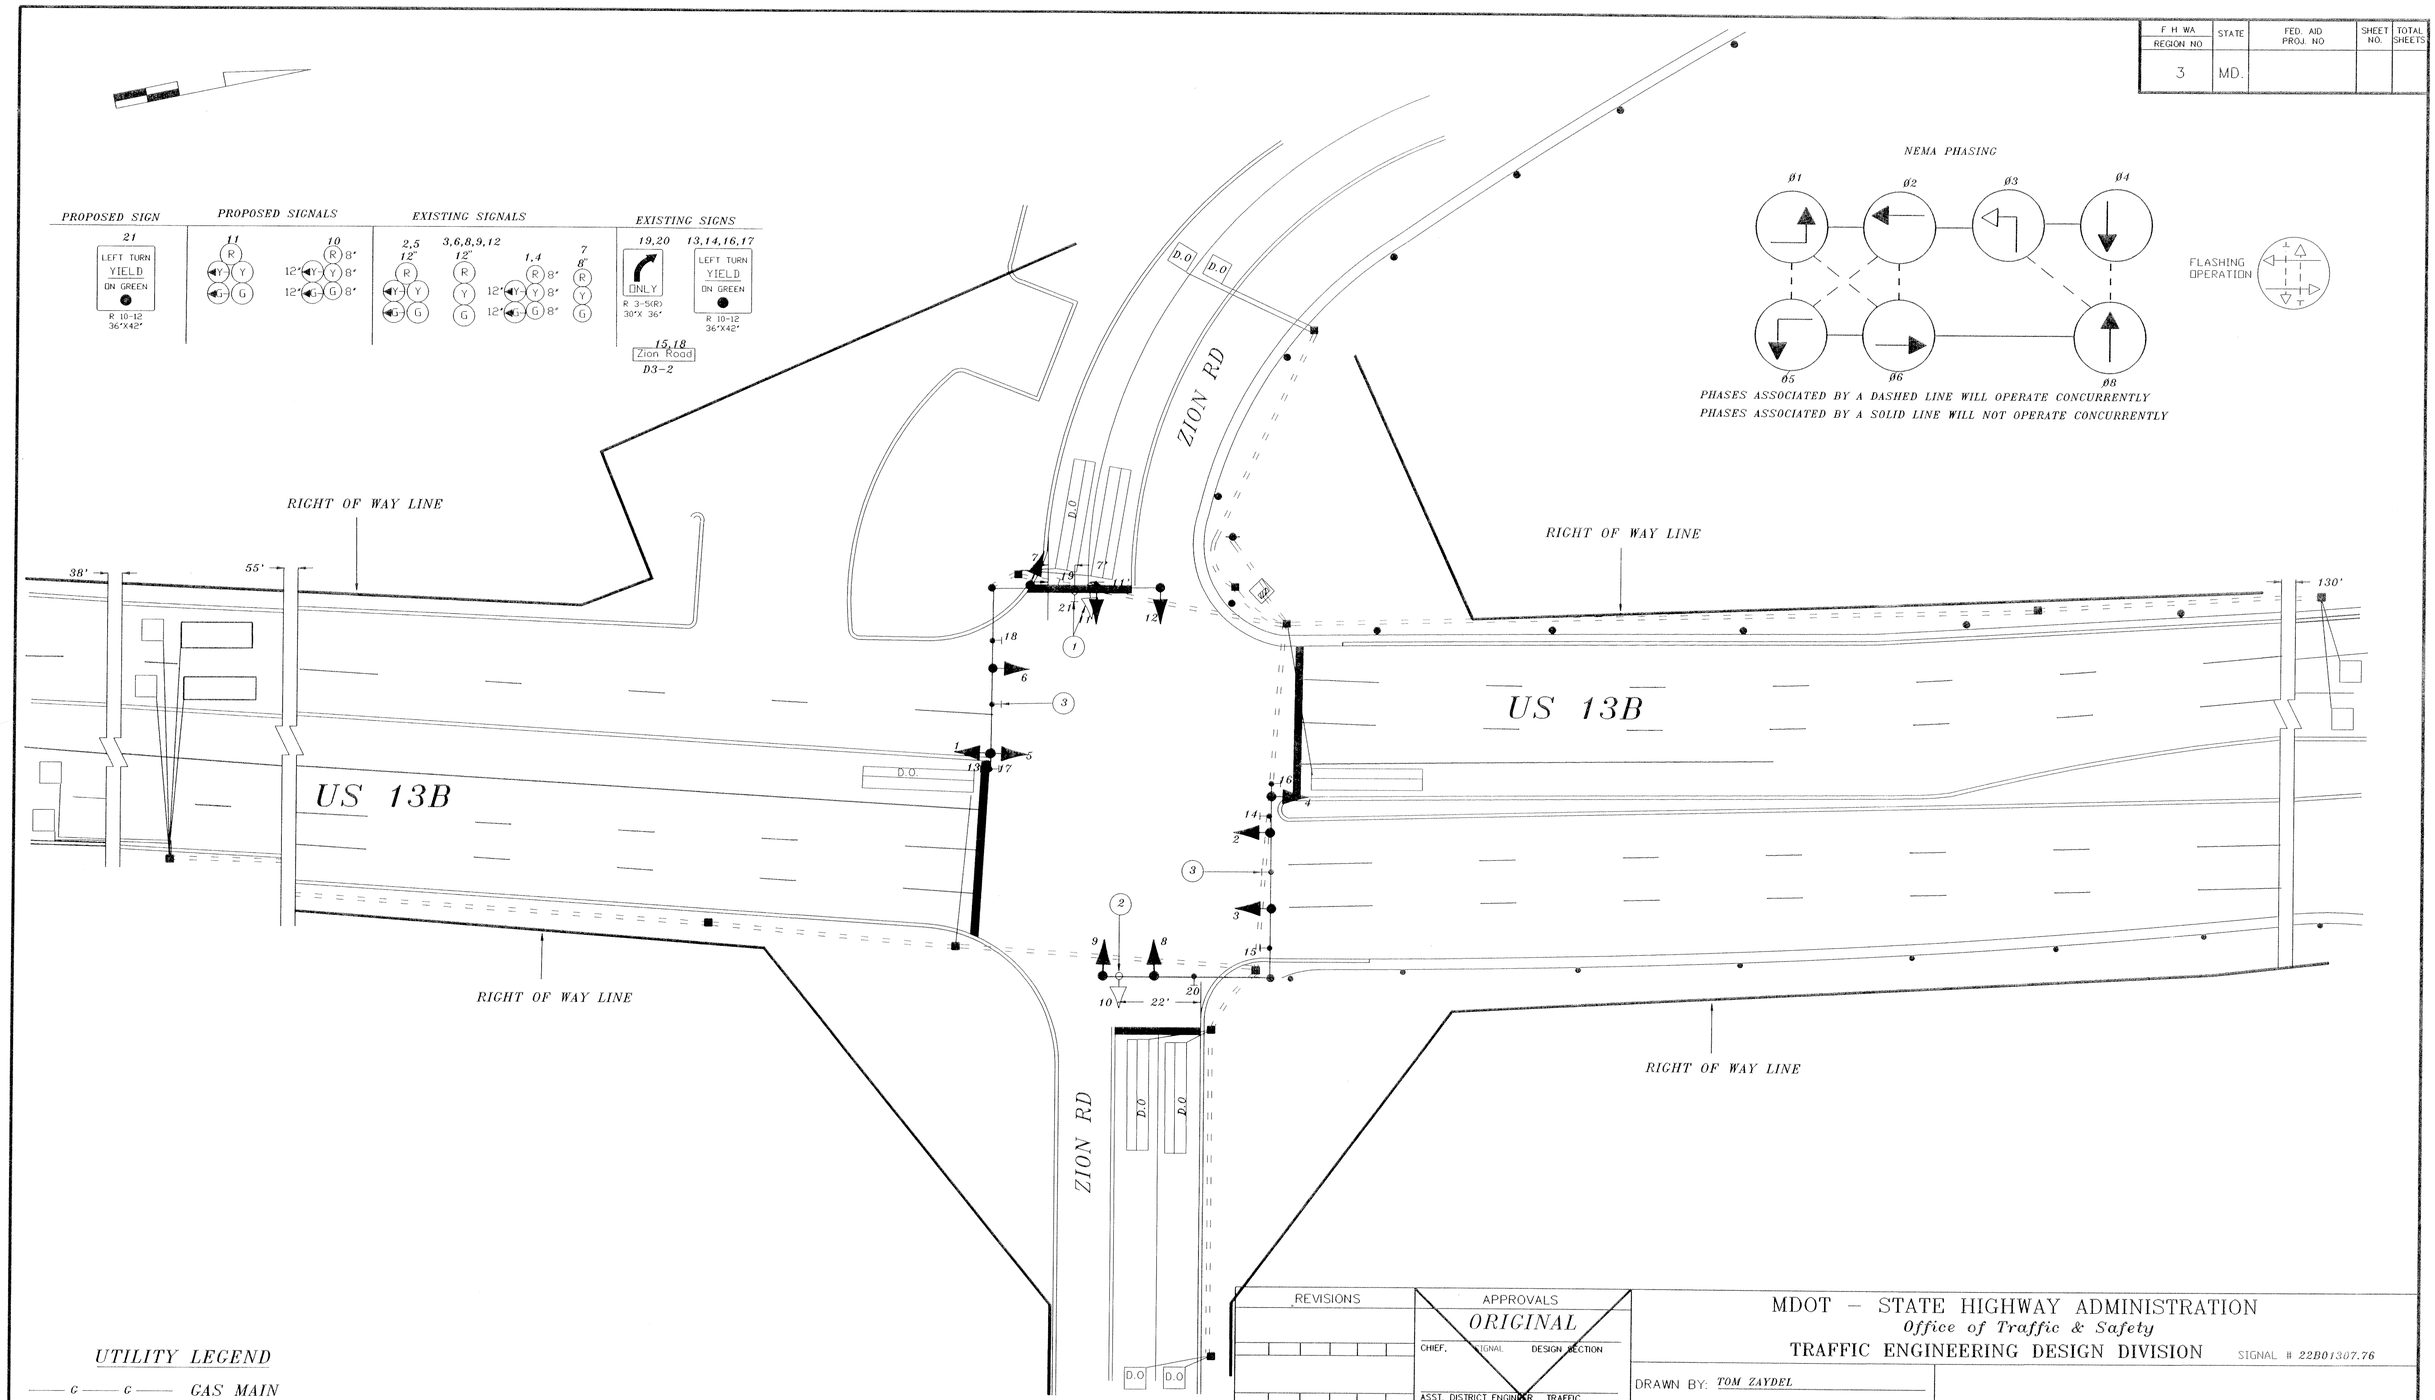

REVISIONS

(B) ASBUILT 8/92
INSTALL E/P LEFT TURN FOR WB ZION RD

A ADDED NEW LOOPS DUE TO NEW GEOMETRICS AND ASBUILT 9/82
S.H.A. NO. DW-300-802-112

EMM

APPROVALS

ORIGINAL

CHIEF, SIGNAL DESIGN SECTION

ASST. DISTRICT ENGINEER, TRAFFIC

ON

CHIEF, TRAFFIC ENGINEERING DISIGN DIVISION

FILE

DIRECTOR, OFFICE OF TRAFFIC & SAFETY

MDOT – STATE HIGHWAY ADMINISTRATION
Office of Traffic & Safety
TRAFFIC ENGINEERING DESIGN DIVISION

SIGNAL # 22B01307.76

DRAWN BY: TOM ZAYDEL
DES. BY:
CHK. BY:

US 13B AND ZION RD

COUNTY: WICOMICO

DATE: 2/23/82
SCALE: 1" = 20'

F.A.P. NO. ORIGINAL
S.H.A. NO. W1-617-502-185

TS/STD. NO. 1855 (B)

SHEET NO. 1 OF 5

F# 60