


PHASES ASSOCIATED BY A DASHED LINE WILL OPERATE CONCURRENTLY
PHASES ASSOCIATED BY A SOLID LINE WILL NOT OPERATE CONCURRENTLY

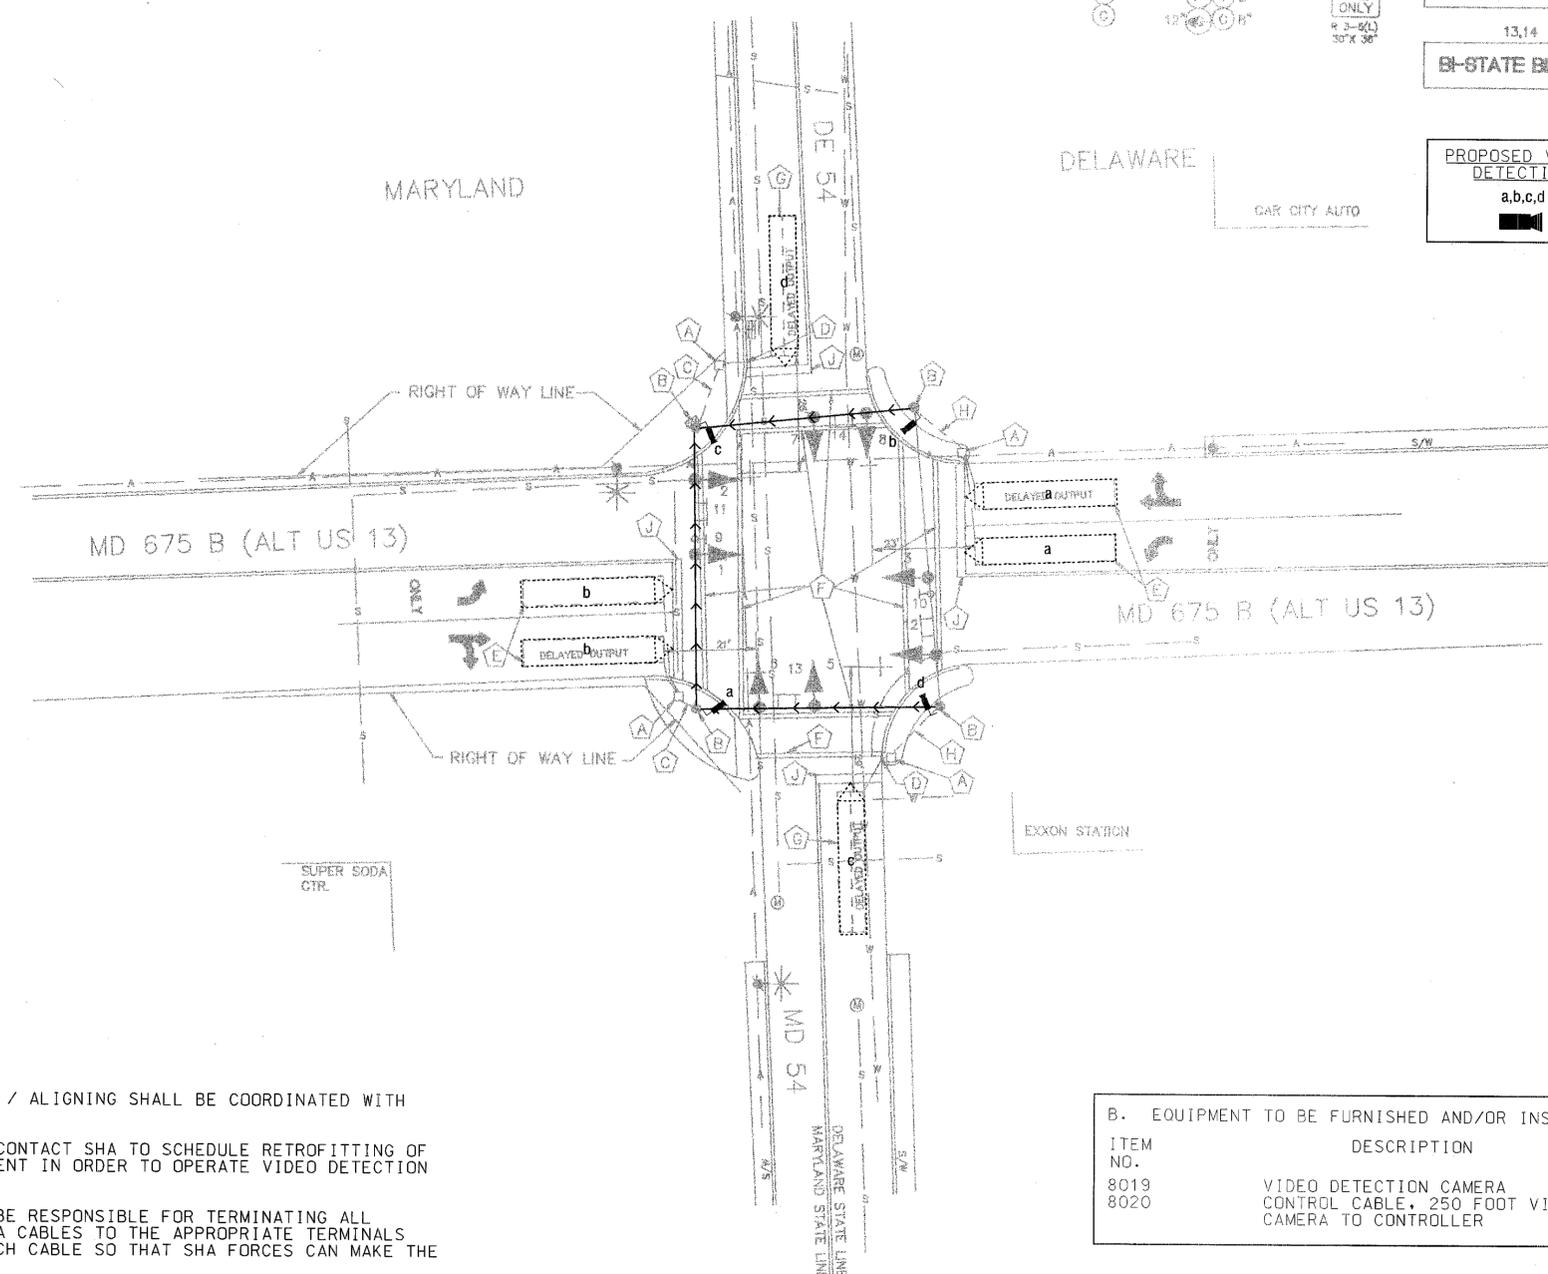


GENERAL NOTES

1. VIDEO CAMERA LOCATION / ALIGNING SHALL BE COORDINATED WITH THE SHA ENGINEER.
2. THE CONTRACTOR SHALL CONTACT SHA TO SCHEDULE RETROFITTING OF THE CONTROLLER EQUIPMENT IN ORDER TO OPERATE VIDEO DETECTION EQUIPMENT.
3. THE CONTRACTOR SHALL BE RESPONSIBLE FOR TERMINATING ALL VIDEO DETECTION CAMERA CABLES TO THE APPROPRIATE TERMINALS AND PROPERLY LABEL EACH CABLE SO THAT SHA FORCES CAN MAKE THE FINAL CONNECTIONS.
4. THE INSTALLATION OF PROPOSED VIDEO DETECTION EQUIPMENT SHALL NECESSITATE THE REMOVAL OF EXISTING CABLES ASSOCIATED WITH THE PRESENCE LOOP DETECTORS BEING REPLACED BY VIDEO DETECTION.
5. ALL EXISTING TRAFFIC SIGNAL EQUIPMENT REMOVED SHALL BECOME THE PROPERTY OF THE SIGNAL CONTRACTOR UPON COMPLETION OF THE SIGNAL MODIFICATIONS.
6. ALL UNUSED SIGNAL CABLES SHALL BE REMOVED AND DISPOSED.

NOTE:
1. LOOP DETECTORS SHALL BE INSTALLED PRIOR TO THE INSTALLATION OF PAVEMENT MARKINGS.
2. PAVEMENT MARKINGS SHALL BE INSTALLED ACCORDING TO S.H.A. STANDARDS.

B. EQUIPMENT TO BE FURNISHED AND/OR INSTALLED BY THE CONTRACTOR.			
ITEM NO.	DESCRIPTION	UNITS	QUANTITY
8019	VIDEO DETECTION CAMERA	EA	4
8020	CONTROL CABLE, 250 FOOT VIDEO DETECTION CAMERA TO CONTROLLER	EA	4

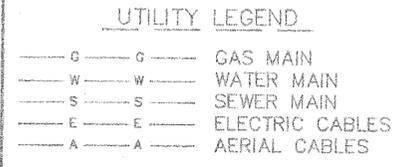

SABRA, WANG & ASSOCIATES, INC.
1504 JOH AVENUE
SUITE 180
BALTIMORE, MD 21227
(410) 737-8564
WWW.SABRA-WANG.COM

REVISIONS	APPROVALS
<p>3/15/04 INSTALL VIDEO DETECTION SHA No. AT3085185 SHA [Signature] ASBULT, INSTALL P.V.C. LOOP DETECTORS ON MD 575. 1-23-85 REBUILD SIGNAL S.H.A. NO. 855-28001 DLA DAZ ITP DT</p>	<p>CHEF, SIGNAL DESIGN SECTION ASST. DISTRICT ENGINEER - TRAFFIC DEPUTY CHIEF ENGINEER, OFFICE OF TRAFFIC</p>

SHA MDOT — STATE HIGHWAY ADMINISTRATION
Office of Traffic
TRAFFIC ENGINEERING DIVISION

DRAWN BY: BRUCE THOMPSON LL
DES. BY: W.J.
CHK. BY: STEVEN RENZI

MD 54 and MD 675 B (US 13 ALT)
DELMAR
COUNTY: WICOMICO

DATE: RE-DRAWN 2-6-91
SCALE: 1" = 20'

F.A.P. NO. 75-01-003
S.H.A. NO. W-500X-000-285

TS/STD. NO. 2042 X C
SHEET NO. OF

FILE: P:\02-12-2004\PC\Task 12\spare_3\mic\m54main615.dgn DATE: 05-Mar-04 08:48