

DRILL HOLES

DRILL HOLES

DRILL HOLES

BORDER REV. DATE: June 1, 2004



NOTE: MD 346 IS CONSIDERED TO RUN IN AN EAST-WEST DIRECTION




PROJECT DESCRIPTION

I. GENERAL

This project involves the removal of a mast arm, pushbutton activated Hazard Identification Beacon in front of Parsonsburg VFD on MD 346 (Ocean Highway).

CONSTRUCTION DETAILS

- A. Remove existing 21' steel pole with 50' mast arm, pole mounted cabinet, signals, signs and electrical service equipment. Remove foundation 24" below grade.
- B. Remove handhole. Cap and abandon existing conduit.
- C. Abandon existing conduit.
- D. Remove existing electrical service.
- E. Remove existing telephone service.

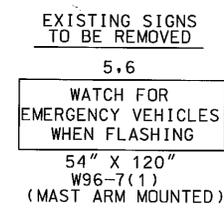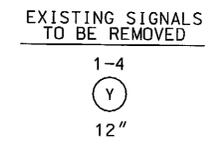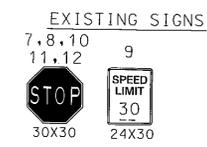


EQUIPMENT LIST

A. EQUIPMENT TO BE SUPPLIED BY S.H.A..

THERE IS NO EQUIPMENT TO BE SUPPLIED BY THE SHA.

B. EQUIPMENT TO BE FURNISHED AND INSTALLED BY THE CONTRACTOR

ITEM NO.	DESCRIPTION	QUANTITY
1001	Maintenance of traffic per assignment.	1 EA
8023	Remove and dispose of equipment per assignment.	1 EA

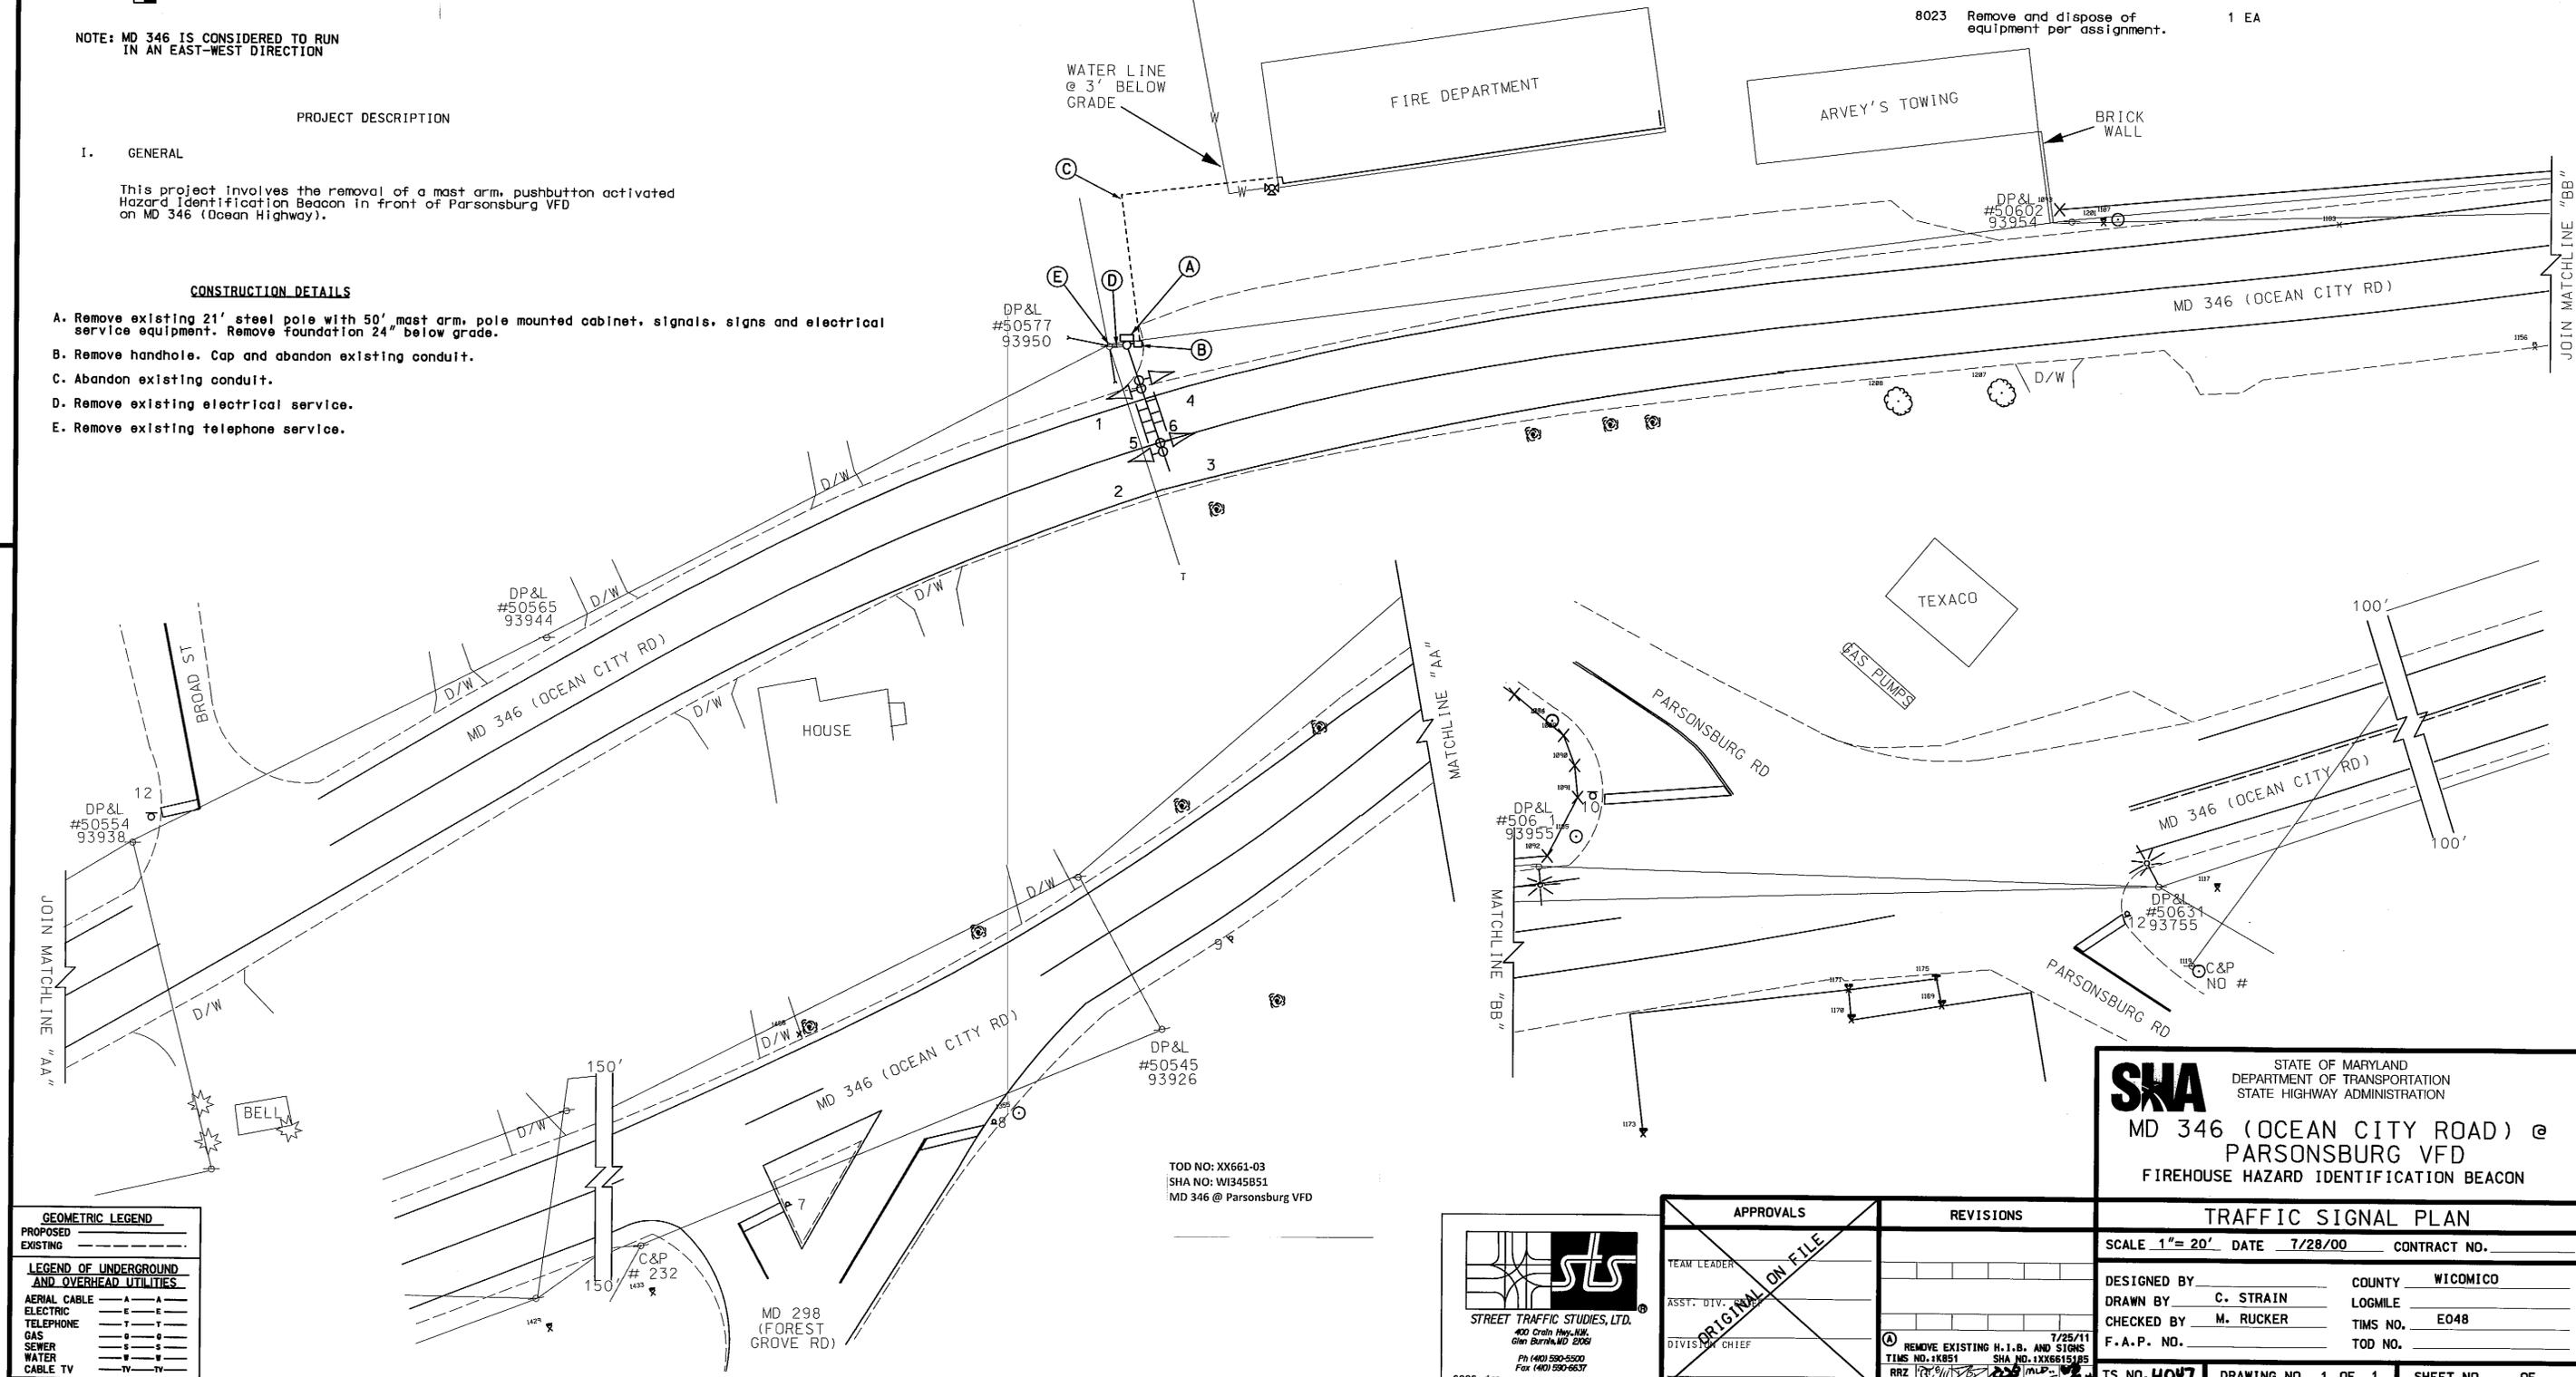

GEOMETRIC LEGEND

PROPOSED	---
EXISTING	---

LEGEND OF UNDERGROUND AND OVERHEAD UTILITIES

AERIAL CABLE	A	A
ELECTRIC	E	E
TELEPHONE	T	T
GAS	G	G
SEWER	S	S
WATER	W	W
CABLE TV	TV	TV

TOD NO: XX661-03
SHA NO: W1345B51
MD 346 @ Parsonsburg VFD

APPROVALS

TEAM LEADER	
ASST. DIV.	
DIVISION CHIEF	
OFFICE DIRECTOR	

ORIGINAL ON FILE

REVISIONS

NO.	DESCRIPTION	DATE
1	REMOVE EXISTING H.I.B. AND SIGNS	7/28/11

7/28/11
TIMS NO. 1X851
RRZ

SHA STATE OF MARYLAND
DEPARTMENT OF TRANSPORTATION
STATE HIGHWAY ADMINISTRATION

**MD 346 (OCEAN CITY ROAD) @ PARSONSBURG VFD
FIREHOUSE HAZARD IDENTIFICATION BEACON**

TRAFFIC SIGNAL PLAN

SCALE 1"=20' DATE 7/28/00 CONTRACT NO.

F.A.P. NO.		TOD NO.	

TS NO. 4047 DRAWING NO. 1 OF 1 SHEET NO. OF

