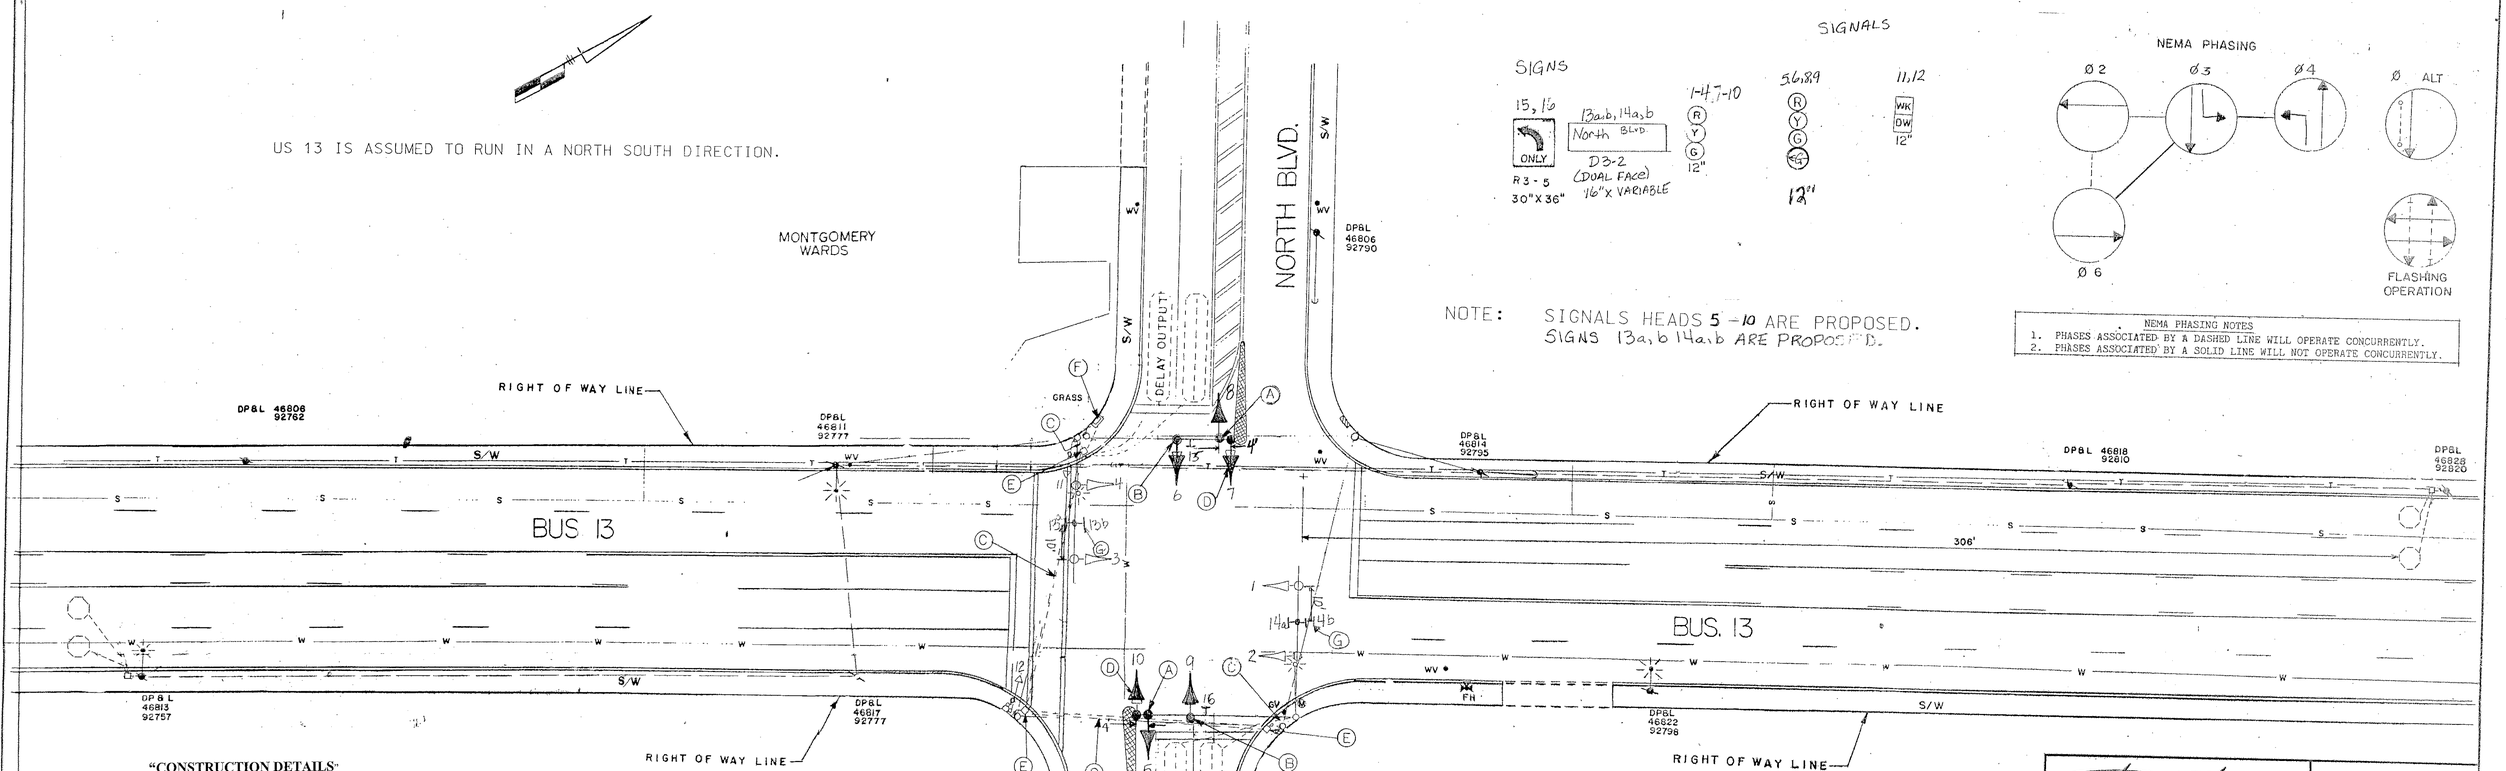

SIGNS

15, 16 — R3-5 ONLY 30"X36"

13a,b, 14a,b — North BLVD. — D3-2 (DUAL FACE) 16"X VARIABLE

1-4, 7-10 — R Y G 12"

5,6,8,9 — R Y G 12"

11,12 — WK DW 12"

SIGNALS

NEMA PHASING

NOTE: SIGNALS HEADS 5 - 10 ARE PROPOSED.
SIGNS 13a,b 14a,b ARE PROPOSED.

NEMA PHASING NOTES
1. PHASES ASSOCIATED BY A DASHED LINE WILL OPERATE CONCURRENTLY.
2. PHASES ASSOCIATED BY A SOLID LINE WILL NOT OPERATE CONCURRENTLY.

"CONSTRUCTION DETAILS"

(A) INSTALL 12" ONE-WAY, FOUR SECTION (R,Y,G,GA) BLACK FACE SIGNAL HEAD.

(B) REMOVE EXISTING ONE-WAY THREE SECTION (R,Y,G) SIGNAL HEAD AND INSTALL 12" ONE-WAY, FOUR SECTION (R,Y,G,GA) BLACK FACE SIGNAL HEAD.

(C) USE EXISTING CONDUIT.

(D) REMOVE EXISTING ONE-WAY THREE SECTION (R,Y,G) SIGNAL HEAD AND INSTALL 12" ONE-WAY, THREE SECTION (R,Y,G) BLACK FACE SIGNAL HEAD.

(E) USE EXISTING HANDHOLE.

(F) USE EXISTING CABINET.

(G) INSTALL D3-2 STREET NAME SIGNS.

LEGEND OF UNDERGROUND UTILITIES	
—G— G—	GAS MAIN
—W— W—	WATER MAIN
—S— S—	SEWER MAIN
—E— E—	ELECTRIC CABLES
—T— T—	TELEPHONE CABLES
—C— C—	CABLE TELEVISION

NOTES:
1. PAVEMENT MARKINGS ARE PROPOSED AND ARE TO BE INSTALLED BY OTHERS.
2. CAP & ABANDON ALL EXISTING CONDUIT.

WIRING DIAGRAM

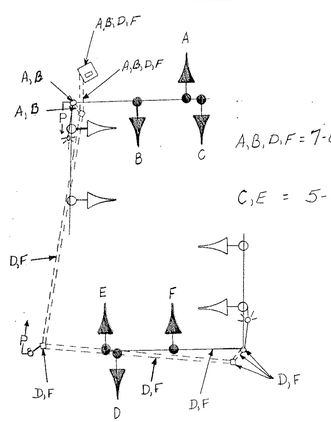

A,B,D,F = 7-Conductor Electrical Cable

C,E = 5-Conductor Electrical Cable

"EQUIPMENT LIST"

Furnished and Installed by Contractor:

Section Number	Category Code	Description	Unit	Quantity:
1001	100000	MAINTENANCE OF TRAFFIC	EA	1
8051	813015	INSTALL OVERHEAD SIGN	SF	32
8015	800000	FURNISH AND INSTALL 12 INCH VEHICULAR TRAFFIC SIGNAL HEAD SECTION	EA	28
8062	861107	FURNISH AND INSTALL ELECTRICAL CABLE - 5 CONDUCTOR (NO. 14 AWG)	LF	40
8063	861108	FURNISH AND INSTALL ELECTRICAL CABLE - 7 CONDUCTOR NO 14 AWG	LF	600

Furnished by SHA:

Section Number	Category Code	Description	Unit	Quantity:
9004	900000	SHEET ALUMINUM SIGN	SF	22

4 EACH D3-2 (NORTH BLVD) 16"X VARIABLE (DUAL FACE) - MAST ARM MOUNTED

APPROVAL: CHIEF SIGNAL DESIGN SECTION — 2/28/84

APPROVAL: DISTRICT TRAFFIC ENGINEER — Alfred D. Budniechuk 7/18/84

APPROVAL: CHIEF BUREAU OF TRAFFIC ENGINEERING — 7-18-84

APPROVAL: DEPUTY CHIEF ENGINEER TRAFFIC — 2/21/84

(A) SIDE STREET SPLIT PHASING 4/00

REVISIONS

STATE OF MARYLAND
DEPARTMENT OF TRANSPORTATION
STATE HIGHWAY ADMINISTRATION

OFFICE OF TRAFFIC — BUREAU OF TRAFFIC ENGINEERING

BUSINESS 13 AT NORTH BLVD.

23854725028 03

SCALE 1"=20' DATE 2-9-84 CONTRACT NO.

DRAWN BY: G.HALLAMEYER COUNTY: WICOMICO

DESIGNED BY: Thomas Trundel SIGNAL NO.:

DRAWING NO. TS-1936A