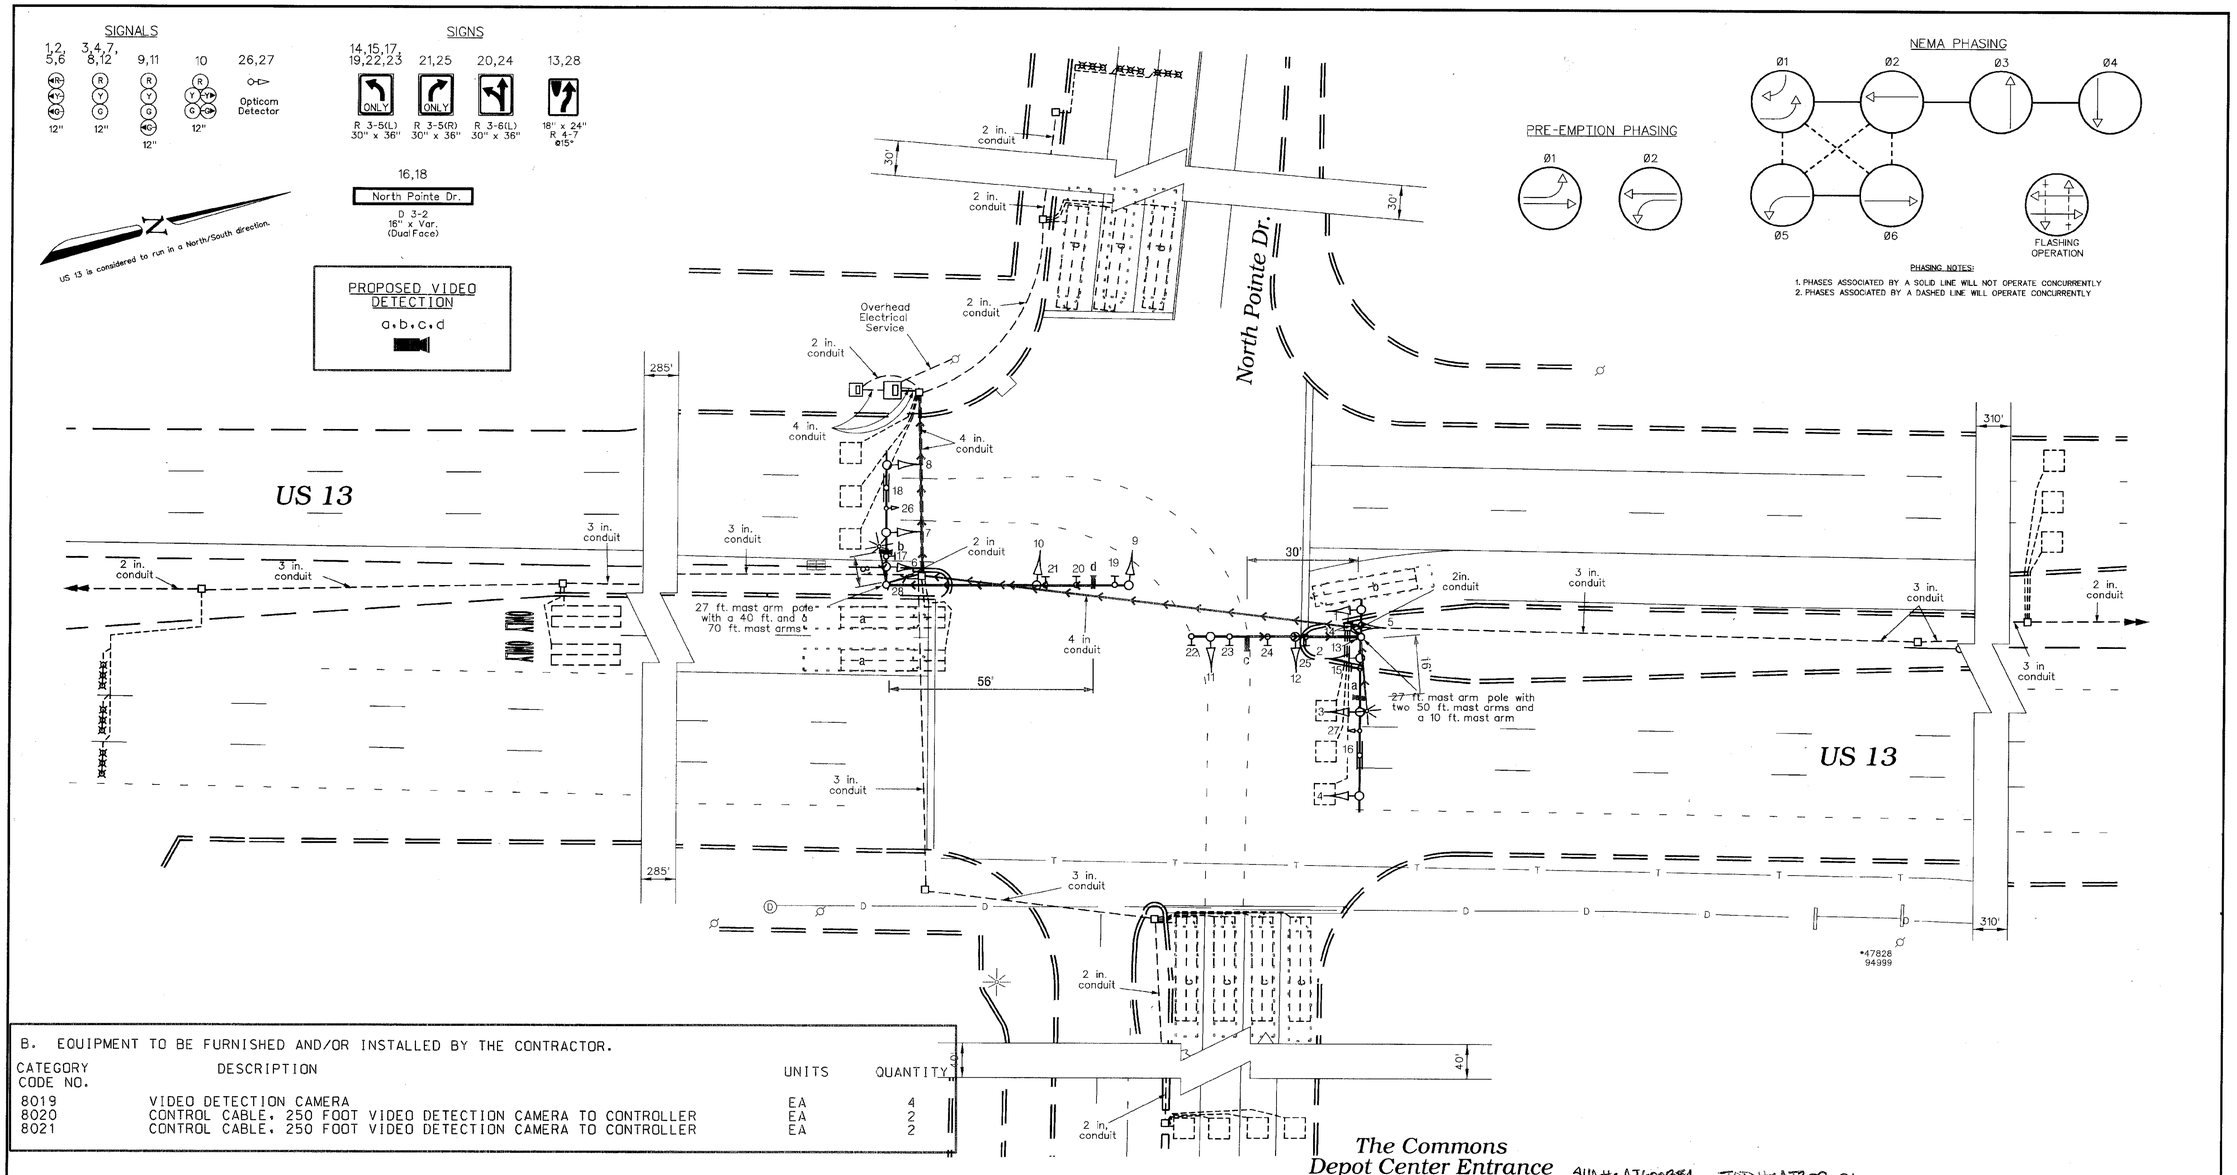

B. EQUIPMENT TO BE FURNISHED AND/OR INSTALLED BY THE CONTRACTOR.

CATEGORY CODE NO.	DESCRIPTION	UNITS	QUANTITY
8019	VIDEO DETECTION CAMERA	EA	4
8020	CONTROL CABLE, 250 FOOT VIDEO DETECTION CAMERA TO CONTROLLER	EA	2
8021	CONTROL CABLE, 250 FOOT VIDEO DETECTION CAMERA TO CONTROLLER	EA	2

SHA#: AT600851 TOD#: AT308-01

VIDEO CAMERA LEGEND

= VIDEO CABLE (PATH TO CONTROLLER)

SABRA, WANG & ASSOCIATES, INC.
1504 JOH AVENUE
SUITE 160
BALTIMORE, MD 21227
(410) 737-6564
WWW.SABRA-WANG.COM

GEOMETRIC LEGEND

EXISTING GEOMETRICS
PROPOSED GEOMETRICS

UTILITY LEGEND

GAS MAIN
WATER MAIN
SEWER MAIN
ELECTRIC CABLES
STORM DRAIN
AERIAL CABLES
TELEPHONE CABLES

REVISIONS

3/ /04
INSTALL VIDEO DETECTION
SHA No. AT3085185
SWA
February 10, 1999
ASBUILT
S.H.A. No.:BW996M82

APPROVALS

ASST. DIVISION CHIEF TRAFFIC ENGINEERING DESIGN DIVISION
CHIEF, TRAFFIC ENGINEERING DESIGN DIVISION
ASST. DISTRICT ENGINEER - TRAFFIC
DIRECTOR, OFFICE OF TRAFFIC & SAFETY
ORIGINAL ON FILE

MDOT – STATE HIGHWAY ADMINISTRATION
Office of Traffic & Safety
TRAFFIC ENGINEERING DESIGN DIVISION

DRAWN BY: J.R.I.
DES. BY: J.H.S. III
CHK. BY: E.M.

(Traffic Signal Plan)
US 13 at North Pointe Drive/ Depot Centre Entrance
COUNTY: WICOMICO
LOG MILE • 22001312.53

DATE: February 2, 1993
SCALE: 1" = 20'
F.A.P. NO. N/A
S.H.A. NO.
TS/STD. NO. 3297~~8~~D
SHEET NO. 1 of 1

FILE: r:\02-12 2001-12\task 12\dwg\tif\wicomico\us13northpointe.dgn
DATE: 27-Feb-04 16:51