BORDER REV: DATE: June 1, 2004

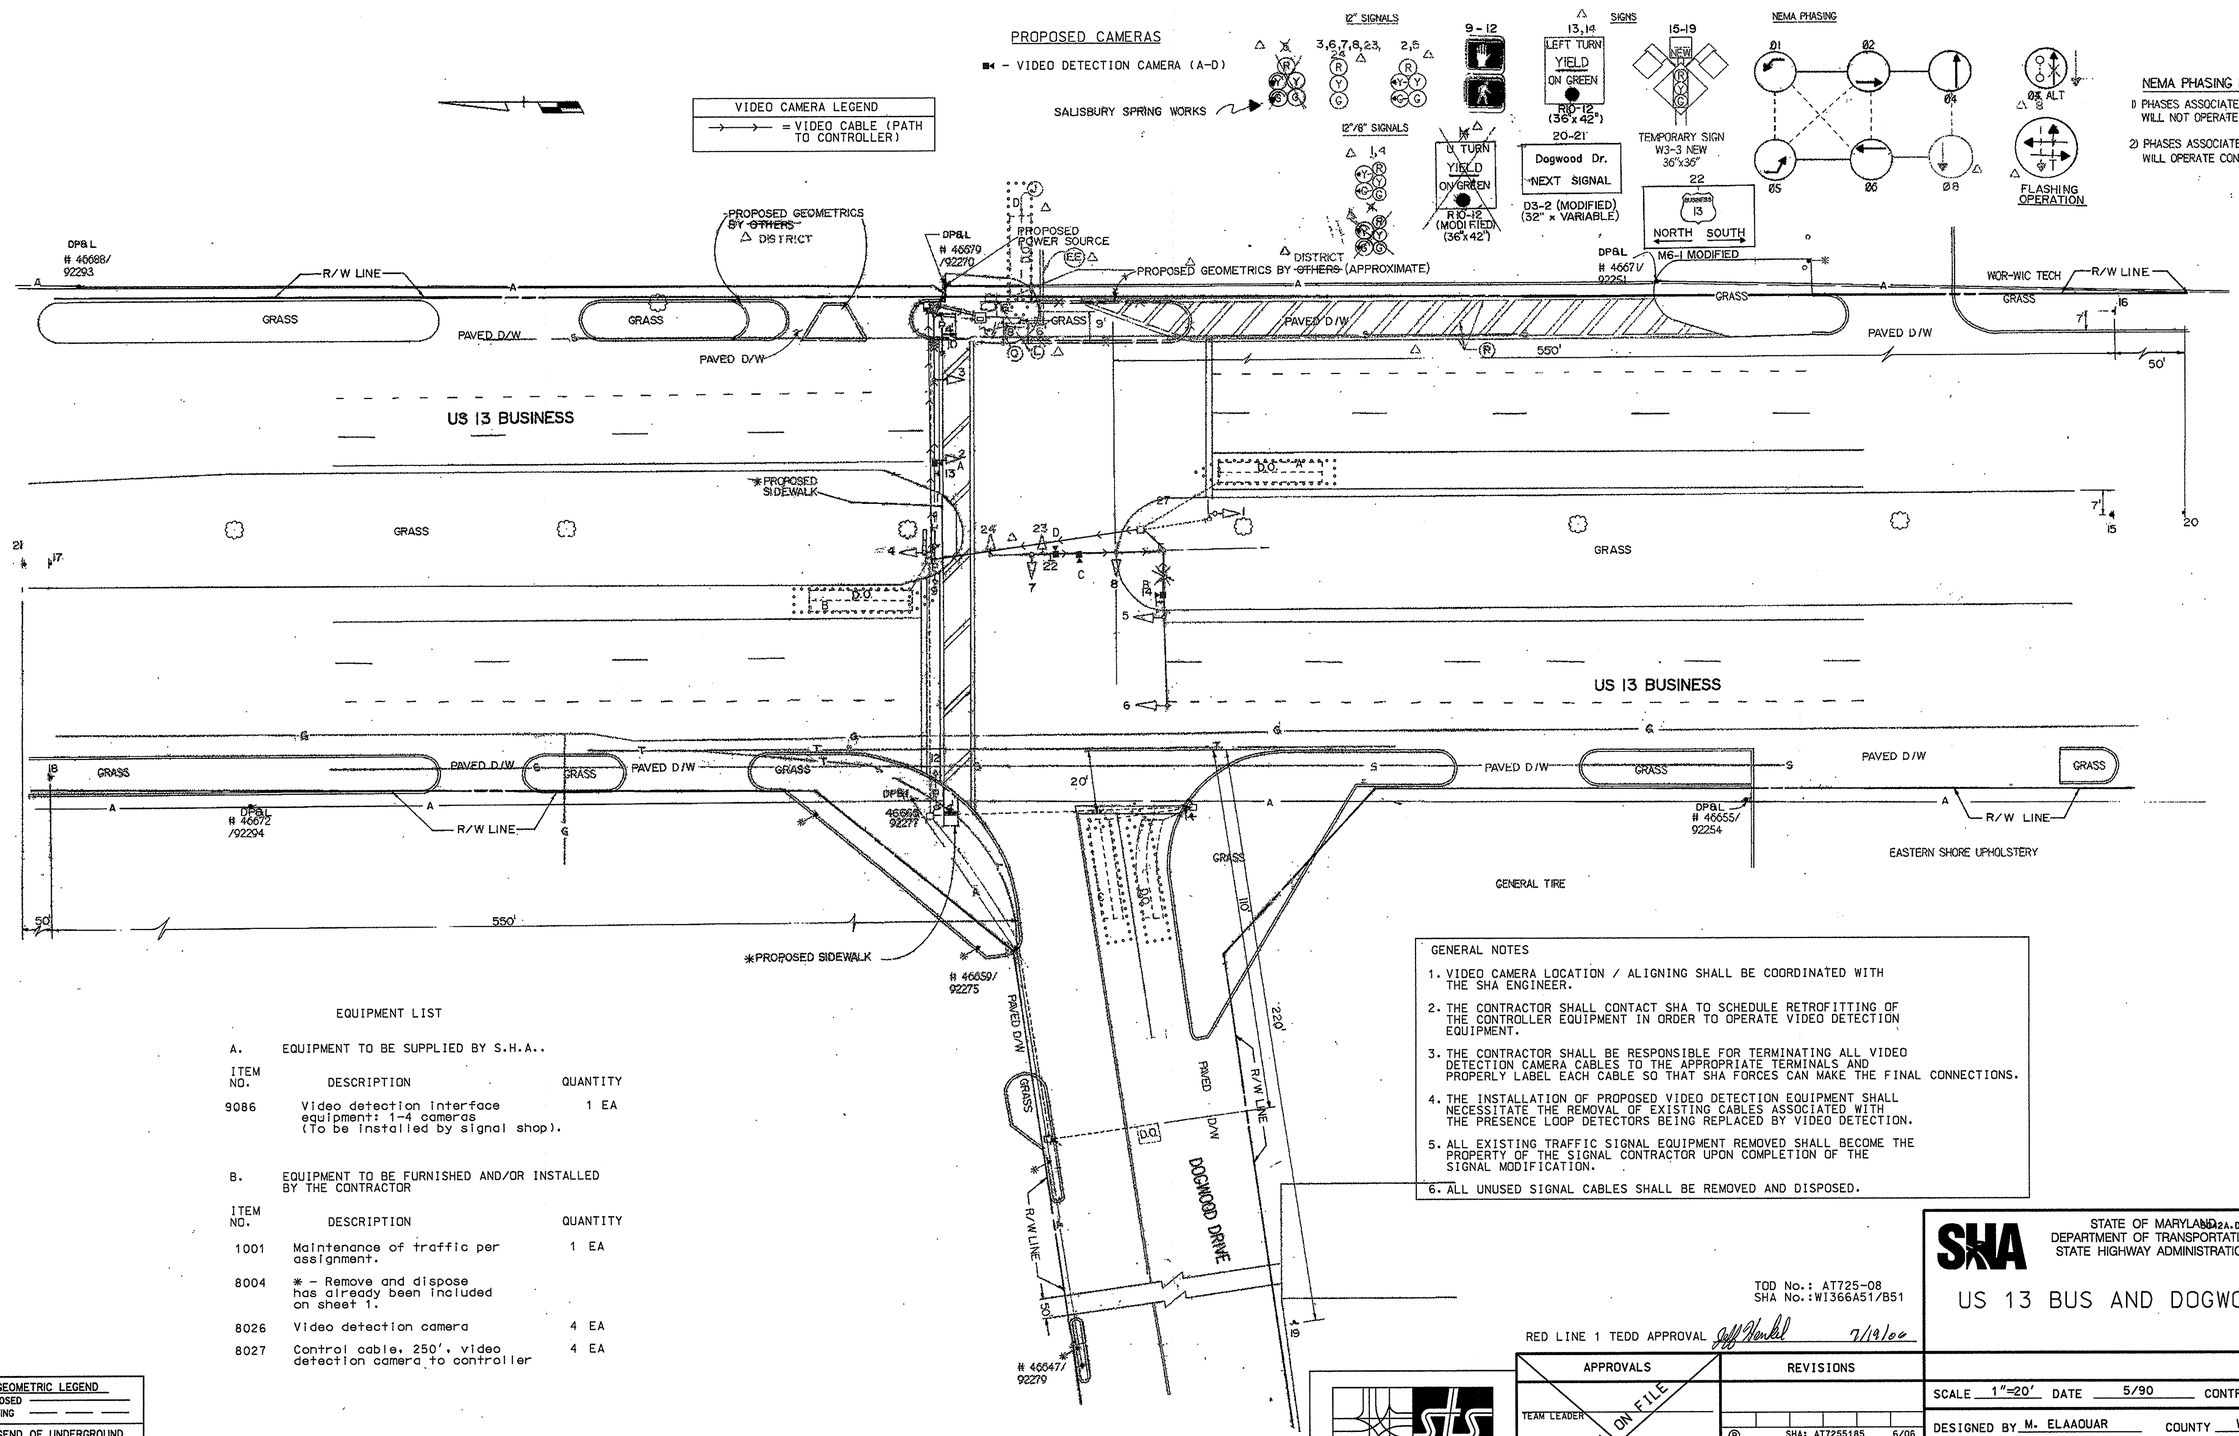

EQUIPMENT LIST

A. EQUIPMENT TO BE SUPPLIED BY S.H.A..

ITEM NO.	DESCRIPTION	QUANTITY
9086	Video detection interface equipment: 1-4 cameras (To be installed by signal shop).	1 EA

B. EQUIPMENT TO BE FURNISHED AND/OR INSTALLED BY THE CONTRACTOR

ITEM NO.	DESCRIPTION	QUANTITY
1001	Maintenance of traffic per assignment.	1 EA
8004	* - Remove and dispose has already been included on sheet 1.	
8026	Video detection camera	4 EA
8027	Control cable, 250', video detection camera to controller	4 EA

GENERAL NOTES

1. VIDEO CAMERA LOCATION / ALIGNING SHALL BE COORDINATED WITH THE SHA ENGINEER.
2. THE CONTRACTOR SHALL CONTACT SHA TO SCHEDULE RETROFITTING OF THE CONTROLLER EQUIPMENT IN ORDER TO OPERATE VIDEO DETECTION EQUIPMENT.
3. THE CONTRACTOR SHALL BE RESPONSIBLE FOR TERMINATING ALL VIDEO DETECTION CAMERA CABLES TO THE APPROPRIATE TERMINALS AND PROPERLY LABEL EACH CABLE SO THAT SHA FORCES CAN MAKE THE FINAL CONNECTIONS.
4. THE INSTALLATION OF PROPOSED VIDEO DETECTION EQUIPMENT SHALL NECESSITATE THE REMOVAL OF EXISTING CABLES ASSOCIATED WITH THE PRESENCE LOOP DETECTORS BEING REPLACED BY VIDEO DETECTION.
5. ALL EXISTING TRAFFIC SIGNAL EQUIPMENT REMOVED SHALL BECOME THE PROPERTY OF THE SIGNAL CONTRACTOR UPON COMPLETION OF THE SIGNAL MODIFICATION.
6. ALL UNUSED SIGNAL CABLES SHALL BE REMOVED AND DISPOSED.

TOD No.: AT725-08
SHA No.:WI366A51/B51

RED LINE 1 TEDD APPROVAL Jeff Henkel 7/19/06

STATE OF MARYLAND 5142A.DGN
DEPARTMENT OF TRANSPORTATION
STATE HIGHWAY ADMINISTRATION

SHA

US 13 BUS AND DOGWOOD DRIVE

STREET TRAFFIC STUDIES, LTD.
400 Crain Hwy. N.W.
Glen Burnie, MD 21061
Ph (410) 590-5500
Fax (410) 590-6637

5142B.dgn

APPROVALS	
TEAM LEADER	ORIGINAL ON FILE
ASST. DIV. CHIEF	
DIVISION CHIEF	
OFFICE DIRECTOR	

REVISIONS				
B	SHA: AT7255185 INSTALL REDLINE VIDEO DETECTION			6/06
JA	JAH	MAR	WH	WH
A	PROVIDE SIGNALIZATION FOR SALISBURY SPRING WORK ENT			7/27/90

SCALE 1"=20'	DATE 5/90	CONTRACT NO.	
DESIGNED BY M. ELAAOUAR		COUNTY WICOMICO	
DRAWN BY T. SPECA		LOGMILE 22B01303.64	
CHECKED BY EMM / D.D.		TIMS NO. H426	
F.A.P. NO.		TOD NO.	
TS NO. 2663B	DRAWING NO. 2 OF 3	SHEET NO. OF	

PLOTTED: MONDAY, JULY 17, 2006 AT 5:19:56 PM
FILE: 5142B.DGN

GEOMETRIC LEGEND	
PROPOSED	
EXISTING	

LEGEND OF UNDERGROUND AND OVERHEAD UTILITIES	
AERIAL CABLE	A A
ELECTRIC	E E
TELEPHONE	T T
GAS	G G
SEWER	S S
WATER	W W
CABLE TV	TV TV