


DRILL HOLES

DRILL HOLES

DRILL HOLES

BORDER REV. DATE: June 1, 2004

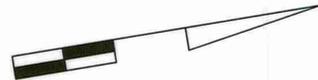

NOTE: US 13 IS ASSUMED TO RUN IN A NORTH-SOUTH DIRECTION.

EQUIPMENT LIST

A. EQUIPMENT TO BE SUPPLIED BY THE SHA


THERE IS NO EQUIPMENT TO BE SUPPLIED BY THE SHA

B. EQUIPMENT TO BE FURNISHED AND INSTALLED BY THE CONTRACTOR

ITEM NO.	DESCRIPTION	QUANTITY
8011	Schedule 80 rigid PVC conduit up to 4" - bored.	140 L.F.
8013	Schedule 80 rigid PVC conduit up to 4" - trenched.	220 L.F.
8019	Furnish and install electrical handhole.	2 EA
Neg.	12-pair communication cable jelly-filled.	2300 L.F.

C. EQUIPMENT TO BE REMOVED

All removed signal materials are to become property of the contractor.

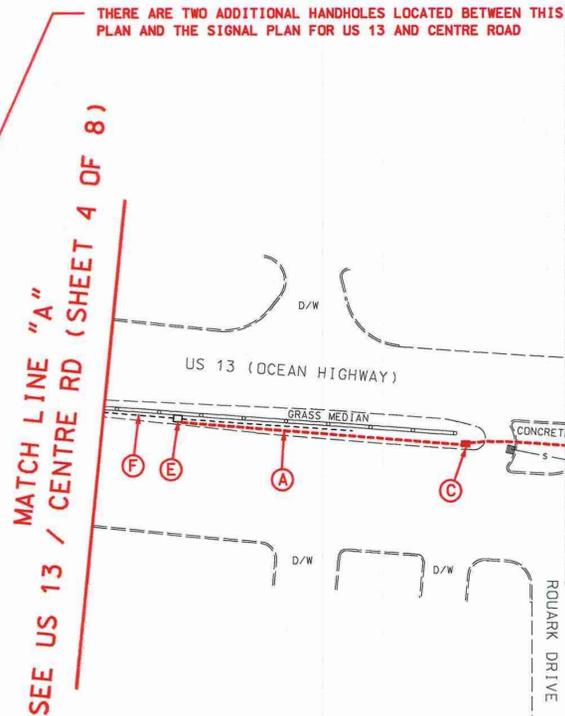

CONSTRUCTION DETAILS

- A. Install 3" polyvinyl chloride electrical conduit (Schedule 80) (trenched)
- B. Install 4" polyvinyl chloride electrical conduit (Schedule 80) (bored).
- C. Install handhole.
- D. Remove and replace existing Interconnect cable with new 12-pair communication cable (jelly-filled) from controller at US 13 and Centre Road to existing pole mounted splice cabinet.
- E. Use existing handhole.
- F. Use existing conduit.

GEOMETRIC LEGEND	
PROPOSED	---
EXISTING	---
LEGEND OF UNDERGROUND AND OVERHEAD UTILITIES	
AERIAL CABLE	—A—A—
ELECTRIC	—E—E—
TELEPHONE	—T—T—
GAS	—G—G—
SEWER	—S—S—
WATER	—W—W—
CABLE TV	—TV—TV—

TOD NO: XX356-13  
SHA NO: W1405K51  
US 13; Zion Road to Dagsboro Road

**SHA** STATE OF MARYLAND  
DEPARTMENT OF TRANSPORTATION  
STATE HIGHWAY ADMINISTRATION

US 13: CENTRE RD TO W. NAYLOR MILL RD

SALISBURY, MARYLAND

INTERCONNECT PLAN

SCALE 1" = 50' DATE 2-23-11 CONTRACT NO. XX3565168

DESIGNED BY R.R.Z. (FOR STS) COUNTY WICOMICO  
 DRAWN BY D.A.N. (FOR STS) LOGMILE  
 CHECKED BY [Signature] TMS NO.  
 F.A.P. NO. TOD NO.

TS NO. 2507X1 DRAWING NO. 5 OF 8 SHEET NO. OF

APPROVALS	REVISIONS
TEAM LEADER [Signature]	
ASSOC. DIV. CHIEF [Signature]	
DIVISION CHIEF [Signature]	
OFFICE DIRECTOR [Signature]	

PLOTTED: 4/24/11 2:23:36 PM  
FILE: #FILE#

\\s01\0001\0001\0001.dgn 2/23/2011 2:23:36 PM