DRILL HOLES

DRILL HOLES

DRILL HOLES

BORDER REV: DATE: June 1, 2004

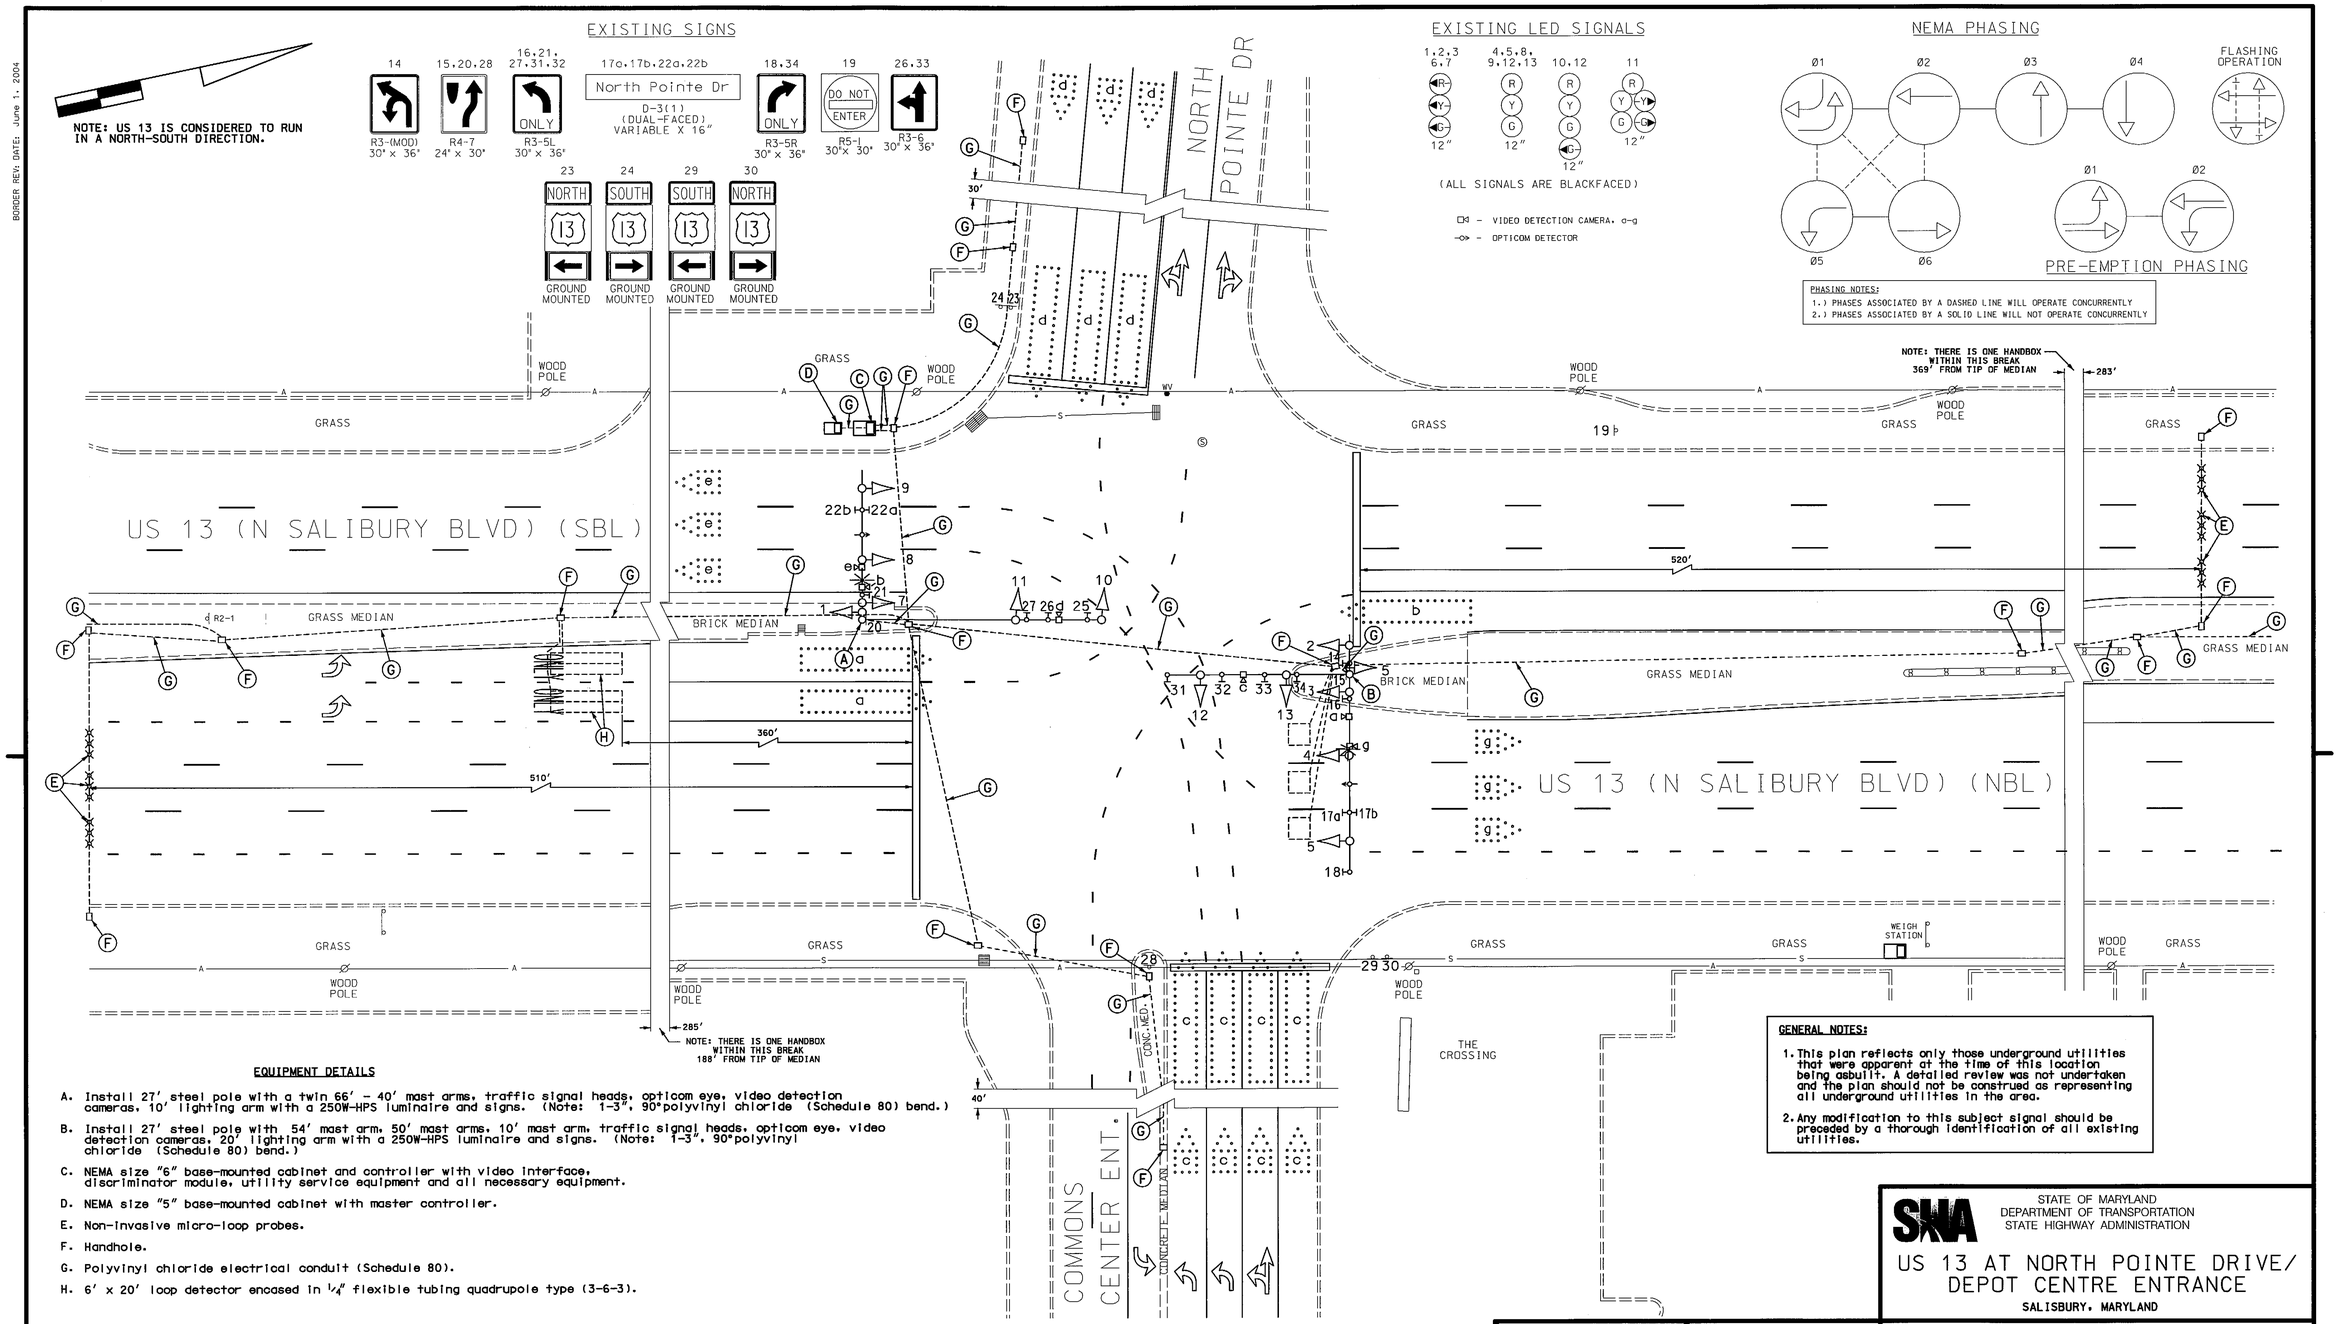

EQUIPMENT DETAILS

A. Install 27' steel pole with a twin 66' - 40' mast arms, traffic signal heads, opticom eye, video detection cameras, 10' lighting arm with a 250W-HPS luminaire and signs. (Note: 1-3", 90°polyvinyl chloride (Schedule 80) bend.)

B. Install 27' steel pole with 54' mast arm, 50' mast arms, 10' mast arm, traffic signal heads, opticom eye, video detection cameras, 20' lighting arm with a 250W-HPS luminaire and signs. (Note: 1-3", 90°polyvinyl chloride (Schedule 80) bend.)

C. NEMA size "6" base-mounted cabinet and controller with video interface, discriminator module, utility service equipment and all necessary equipment.

D. NEMA size "5" base-mounted cabinet with master controller.

E. Non-invasive micro-loop probes.

F. Handhole.

G. Polyvinyl chloride electrical conduit (Schedule 80).

H. 6' x 20' loop detector encased in 1/4" flexible tubing quadrupole type (3-6-3).

GENERAL NOTES:

1. This plan reflects only those underground utilities that were apparent at the time of this location being asbuilt. A detailed review was not undertaken and the plan should not be construed as representing all underground utilities in the area.

2. Any modification to this subject signal should be preceded by a thorough identification of all existing utilities.

GEOMETRIC LEGEND

PROPOSED
EXISTING

LEGEND OF UNDERGROUND AND OVERHEAD UTILITIES

AERIAL CABLE	—A—A—
ELECTRIC	—E—E—
TELEPHONE	—T—T—
GAS	—G—G—
SEWER	—S—S—
WATER	—W—W—
CABLE TV	—TV—TV—

STATE OF MARYLAND
DEPARTMENT OF TRANSPORTATION
STATE HIGHWAY ADMINISTRATION

US 13 AT NORTH POINTE DRIVE/ DEPOT CENTRE ENTRANCE

SALISBURY, MARYLAND

TRAFFIC SIGNAL PLAN

SCALE 1"= 20' DATE 2/23/82 CONTRACT NO.

DESIGNED BY J.H.S.III
DRAWN BY J.R.I.
CHECKED BY E.M.
F.A.P. NO.

COUNTY
LOCMILE
TIMS NO.
TOD NO.

TS NO. 3297F | DRAWING NO. 1 OF 1 | SHEET NO. OF

STREET TRAFFIC STUDIES, LTD.
400 Crain Hwy. NW.
Glen Burnie, MD 21061
Ph (410) 590-5500
Fax (410) 590-6637

5960GASBUILT.dgn T-115

APPROVALS

TEAM LEADER
ASST. DIV.
DIVISION CHIEF
OFFICE DIRECTOR

ORIGINAL ON FILE

REVISIONS

F	ASBUILT	12/9/11 TIMS NO. J615
	RRZ	
E	INSTALL VIDEO DETECTION CAMERAS, NON-INVASIVE PROBES SHA NO.: XX3565168 TIMS NO. J615	3/11/11
	RRZ	
D	INSTALL VIDEO DETECTION SHA. NO.: AT3085185	3/04
	SWA	

PLOTTED: $DATETIME$
FILE: $FILE$

12/6/2011 10:42:15 AM