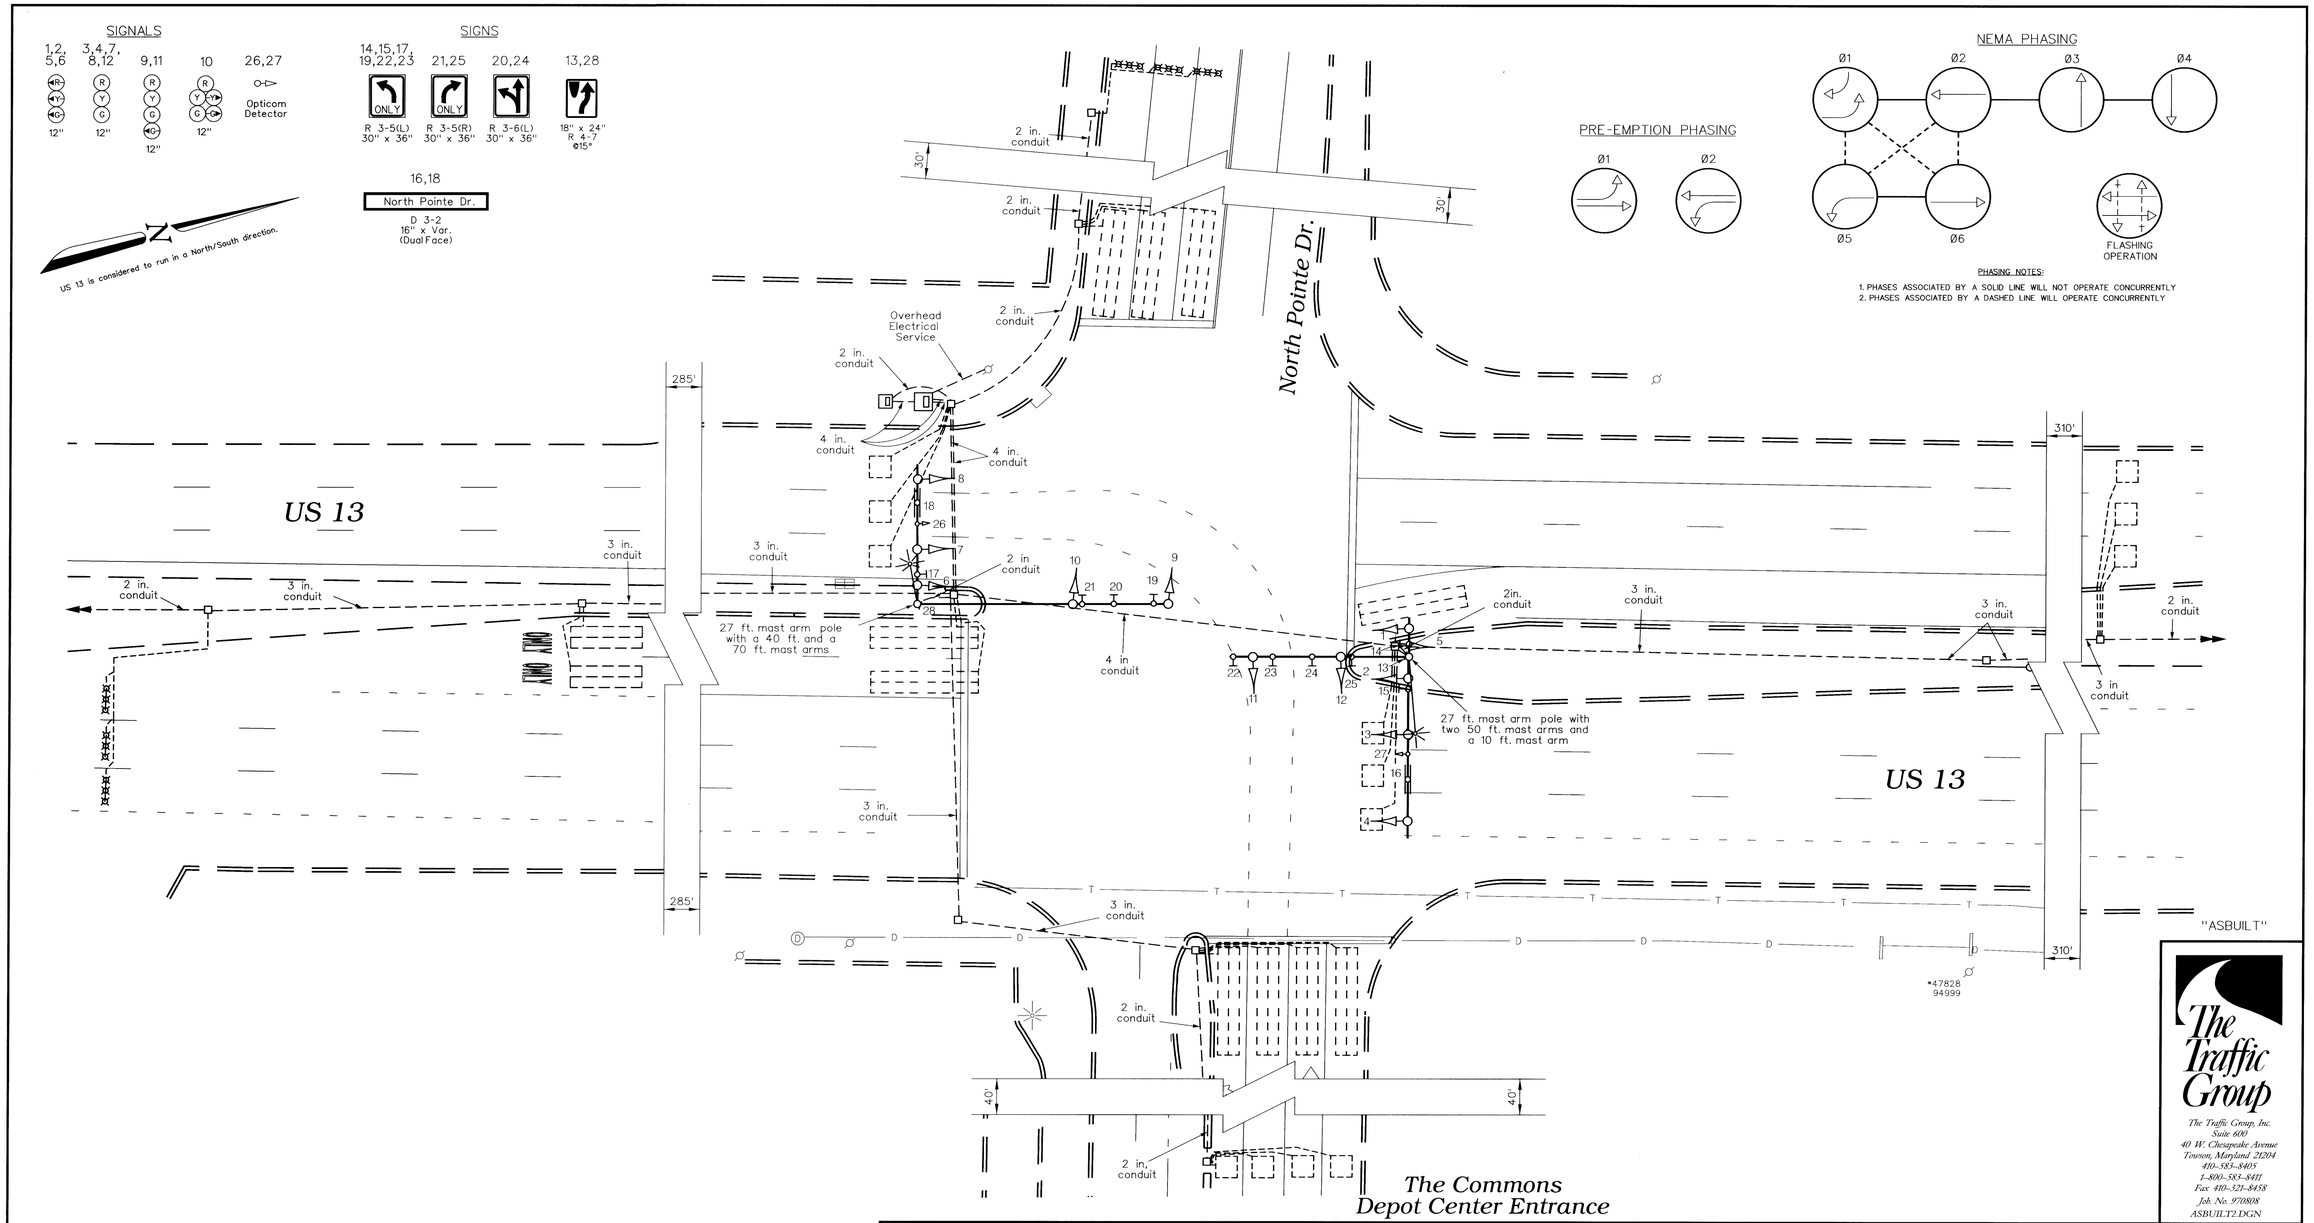

The Traffic Group

The Traffic Group, Inc.
Suite 600
40 W. Chesapeake Avenue
Towson, Maryland 21204
410-583-8405
1-800-583-8411
Fax 410-321-8458
Job. No. 970808
ASBUILT2.DGN

GEOMETRIC LEGEND

EXISTING GEOMETRICS
PROPOSED GEOMETRICS

UTILITY LEGEND

G	GAS MAIN
W	WATER MAIN
S	SEWER MAIN
E	ELECTRIC CABLES
D	STORM DRAIN
A	AERIAL CABLES
T	TELEPHONE CABLES

REVISIONS

© February 10, 1999
ASBUILT
S.H.A. No.:BW996M82
FTH

APPROVALS

ASST. DIVISION CHIEF TRAFFIC ENGINEERING DESIGN DIVISION
CHIEF, TRAFFIC ENGINEERING DESIGN DIVISION
ASST. DISTRICT ENGINEER - TRAFFIC
DIRECTOR, OFFICE OF TRAFFIC & SAFETY
ORIGINAL ON FILE

MDOT – STATE HIGHWAY ADMINISTRATION
Office of Traffic & Safety
TRAFFIC ENGINEERING DESIGN DIVISION

DRAWN BY: J.R.I.
DES. BY: J.H.S. III
CHK. BY: E.M.

(Traffic Signal Plan)
US 13 at North Pointe Drive / Depot Centre Entrance

COUNTY: WICOMICO
LOG MILE • 22001312.53

DATE: February 2, 1993
SCALE: 1" = 20'
F.A.P. NO. N/A
S.H.A. NO.

TS/STD. NO. 3297C

SHEET NO. 1 of 1