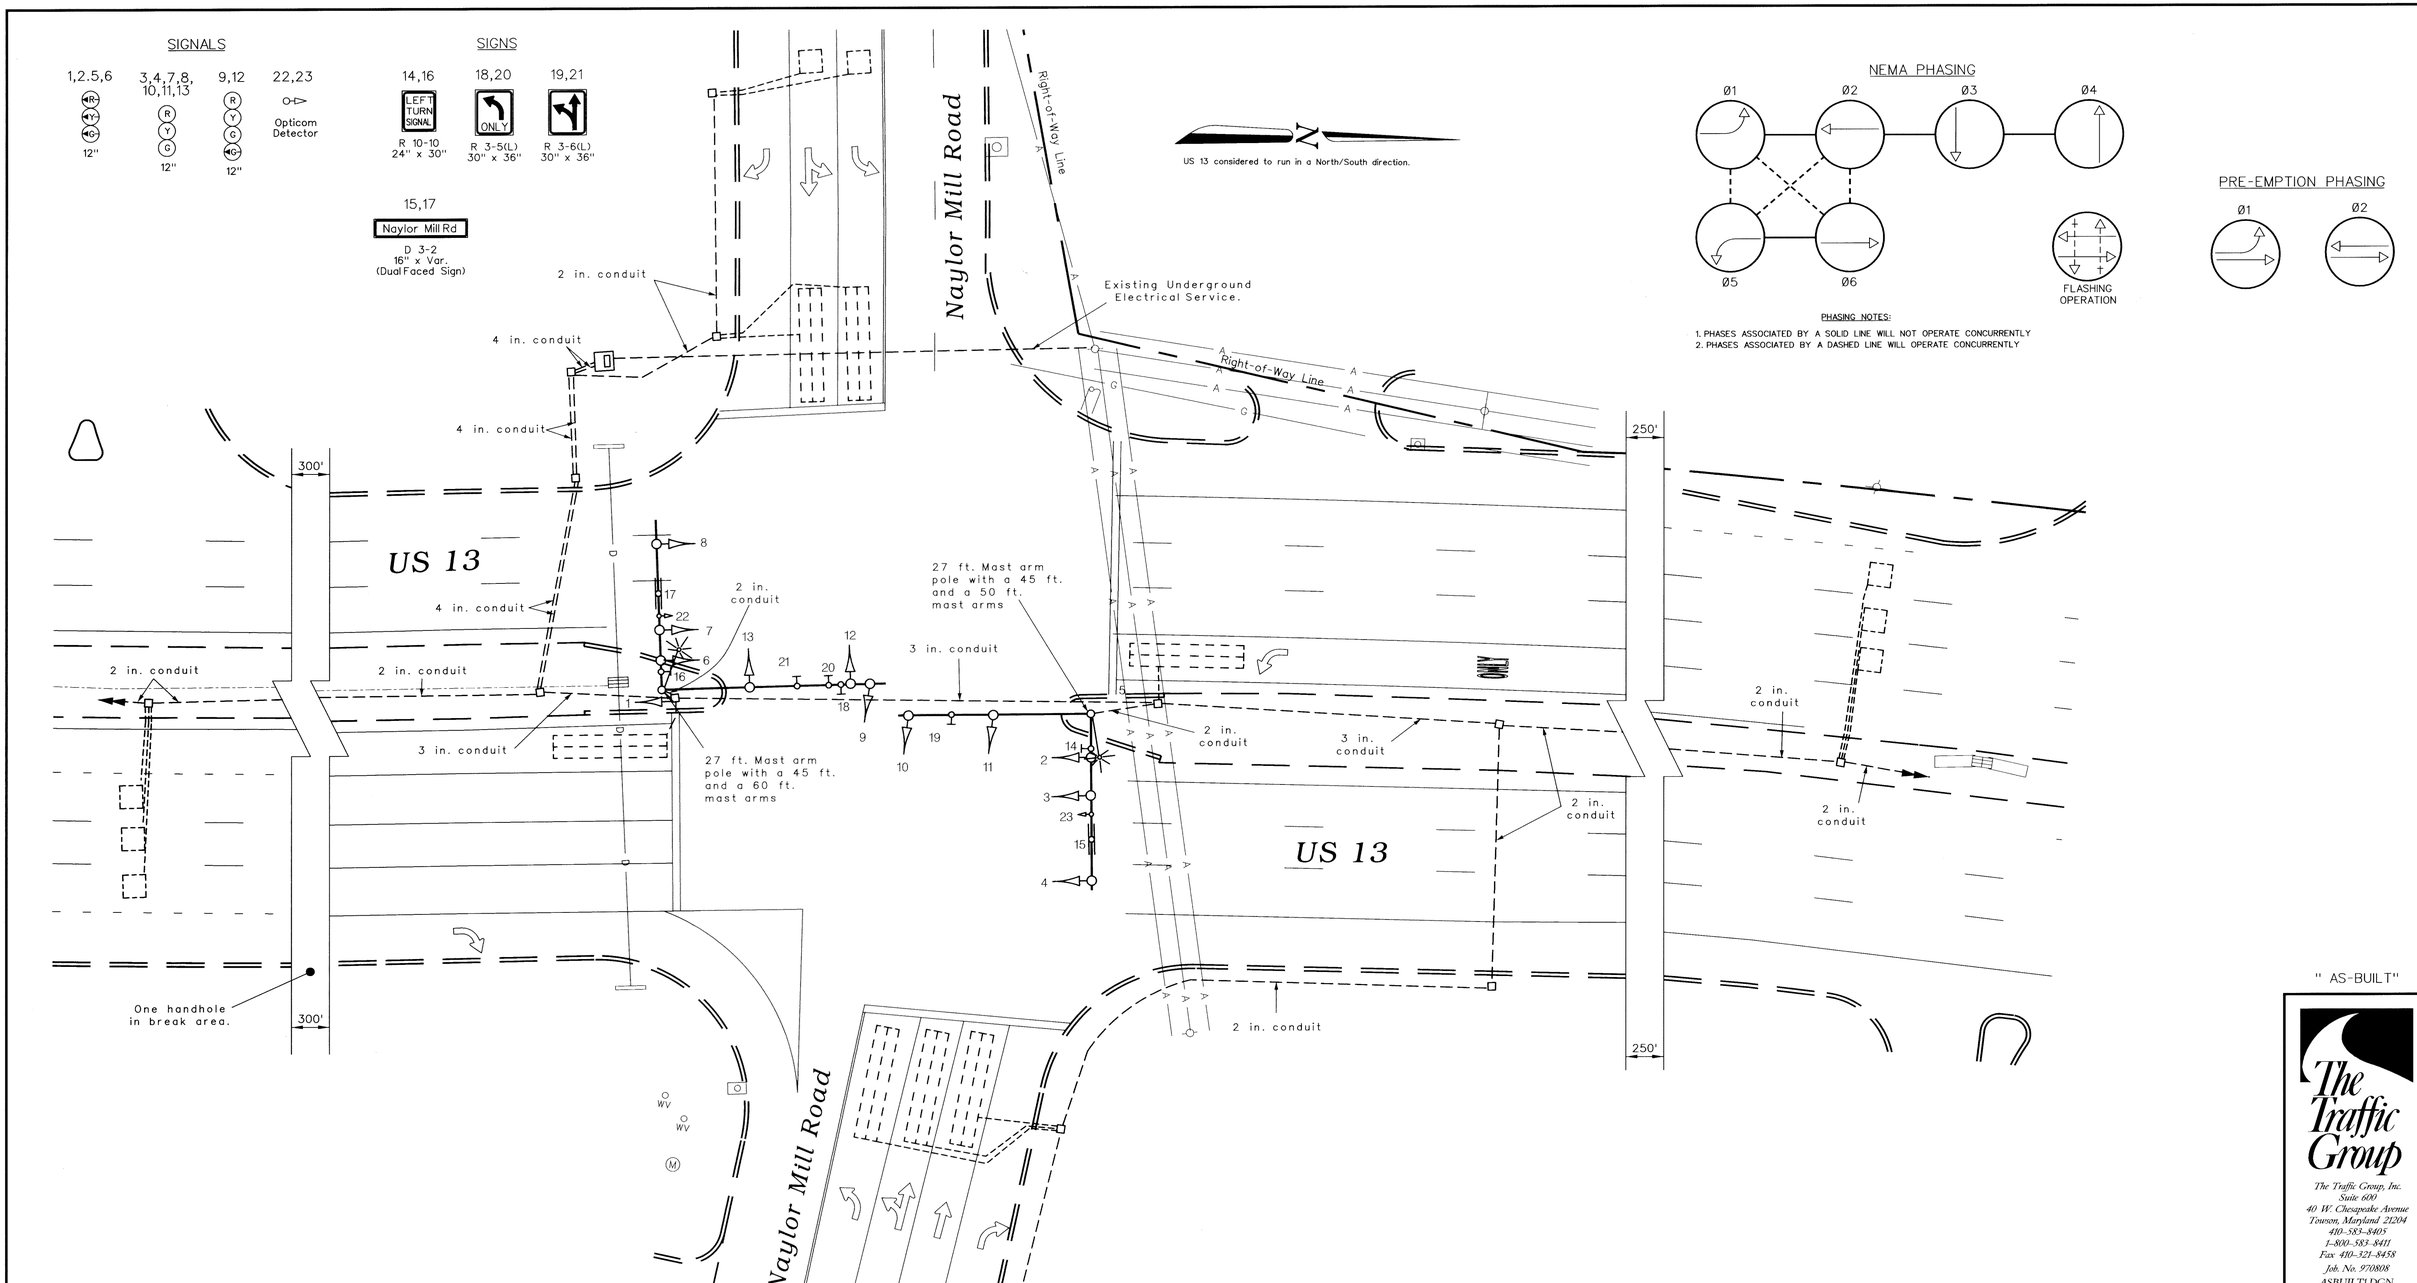

" AS-BUILT"

The Traffic Group

The Traffic Group, Inc.
Suite 600
40 W. Chesapeake Avenue
Towson, Maryland 21204
410-583-8405
1-800-583-8411
Fax 410-321-8458
Job. No. 970808
ASBUILTLDGN

GEOMETRIC LEGEND

EXISTING GEOMETRICS
PROPOSED GEOMETRICS

UTILITY LEGEND

G — G	GAS MAIN
W — W	WATER MAIN
S — S	SEWER MAIN
E — E	ELECTRIC CABLES
D — D	STORM DRAIN
A — A	AERIAL CABLES
T — T	TELEPHONE CABLES

REVISIONS

(F) AS-BUILT
S.H.A. No.:BW996M82
FJH
Febuary 10, 1999

APPROVALS

ASST. TRAFFIC ENGINEERING DESIGN DIVISION
ASST. DISTRICT ENGINEER - TRAFFIC
CHIEF, TRAFFIC ENGINEERING DESIGN DIVISION
DIRECTOR, OFFICE OF TRAFFIC & SAFETY
ORIGINAL ON FILE

MDOT - STATE HIGHWAY ADMINISTRATION
Office of Traffic & Safety
TRAFFIC ENGINEERING DESIGN DIVISION
(Traffic Signal Plan)

US 13 at Naylor Mill Road

DATE: April 4, 1977
LOG MILE • 22001312.65

DRAWN BY:		F.A.P. NO.	N/A	PLAN SHEET NO.:	SHEET NO.
CHK. BY:	B. Thompson	S.H.A. NO.	W1528-5010-185	1506F	1 of 1
SCALE:	1" = 20'	COUNTY:	wicomico		