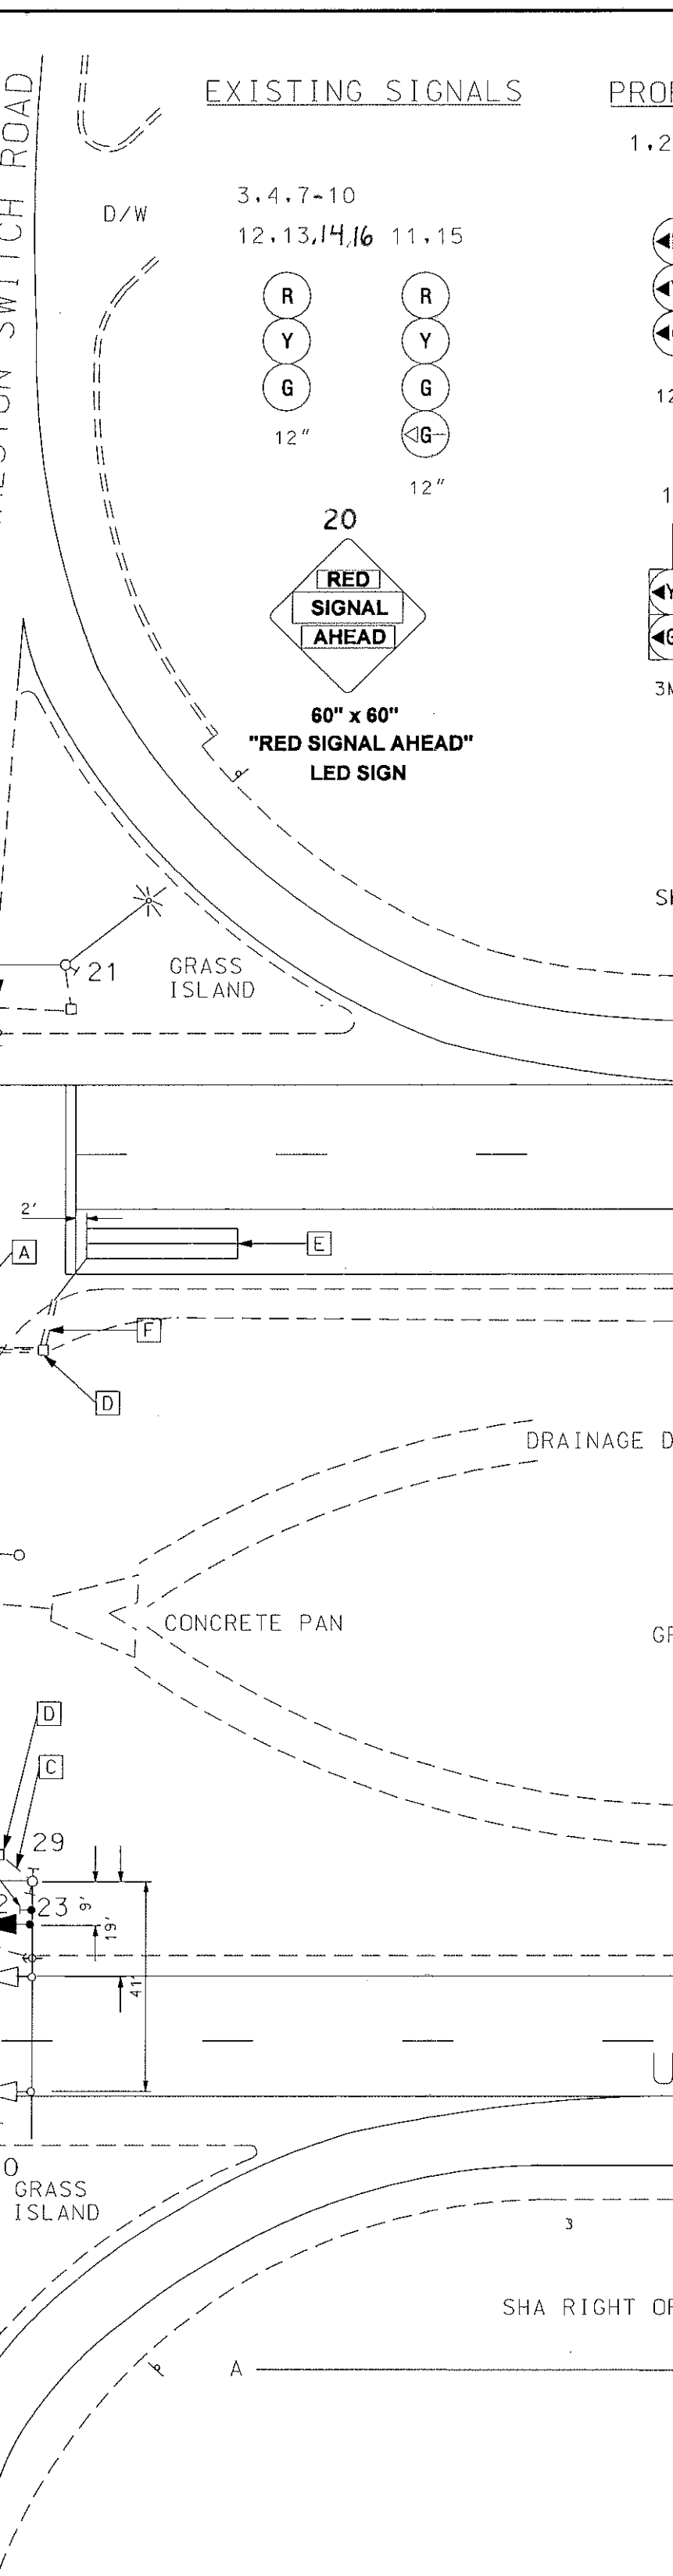


| REVISIONS | | | | | |
|---|---|---|---|---|---|
| | | | | | |
| | | | | | |
| C INSTALL EXCLUSIVE LEAD LAG PHASING ON US 50<br>TIMS # E 338 PHASE II 10/2000 | | | | | |
| J.A.H | | | | | |
| B INSTALL RED SIGNAL AHEAD LED SIGN<br>HIB<br>2-28-00 | | | | | |
| cj | | | | | |
| A ASBUILT 6-6-96<br>S.H.A. NO.: AW-774-476-185P | | | | | |
| R.R.Z. | | | | | |