



F H WA REGION NO	STATE	FED. AID PROJ. NO	SHEET NO.	TOTAL SHEETS
3	MD.		11	12


EXISTING SIGNALS

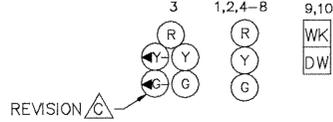



SIGNS

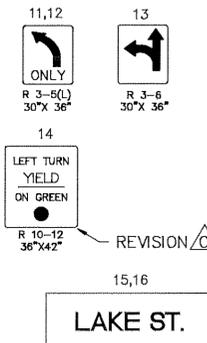

TRACK CLEARANCE Ø

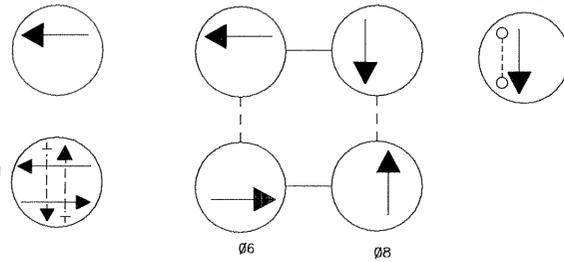


FLASHING OPERATION

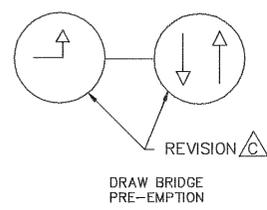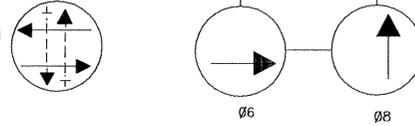

NEMA PHASING NOTES

- PHASES ASSOCIATED BY A DASHED LINE WILL OPERATE CONCURRENTLY
- PHASES ASSOCIATED BY A SOLID LINE WILL NOT OPERATE CONCURRENTLY

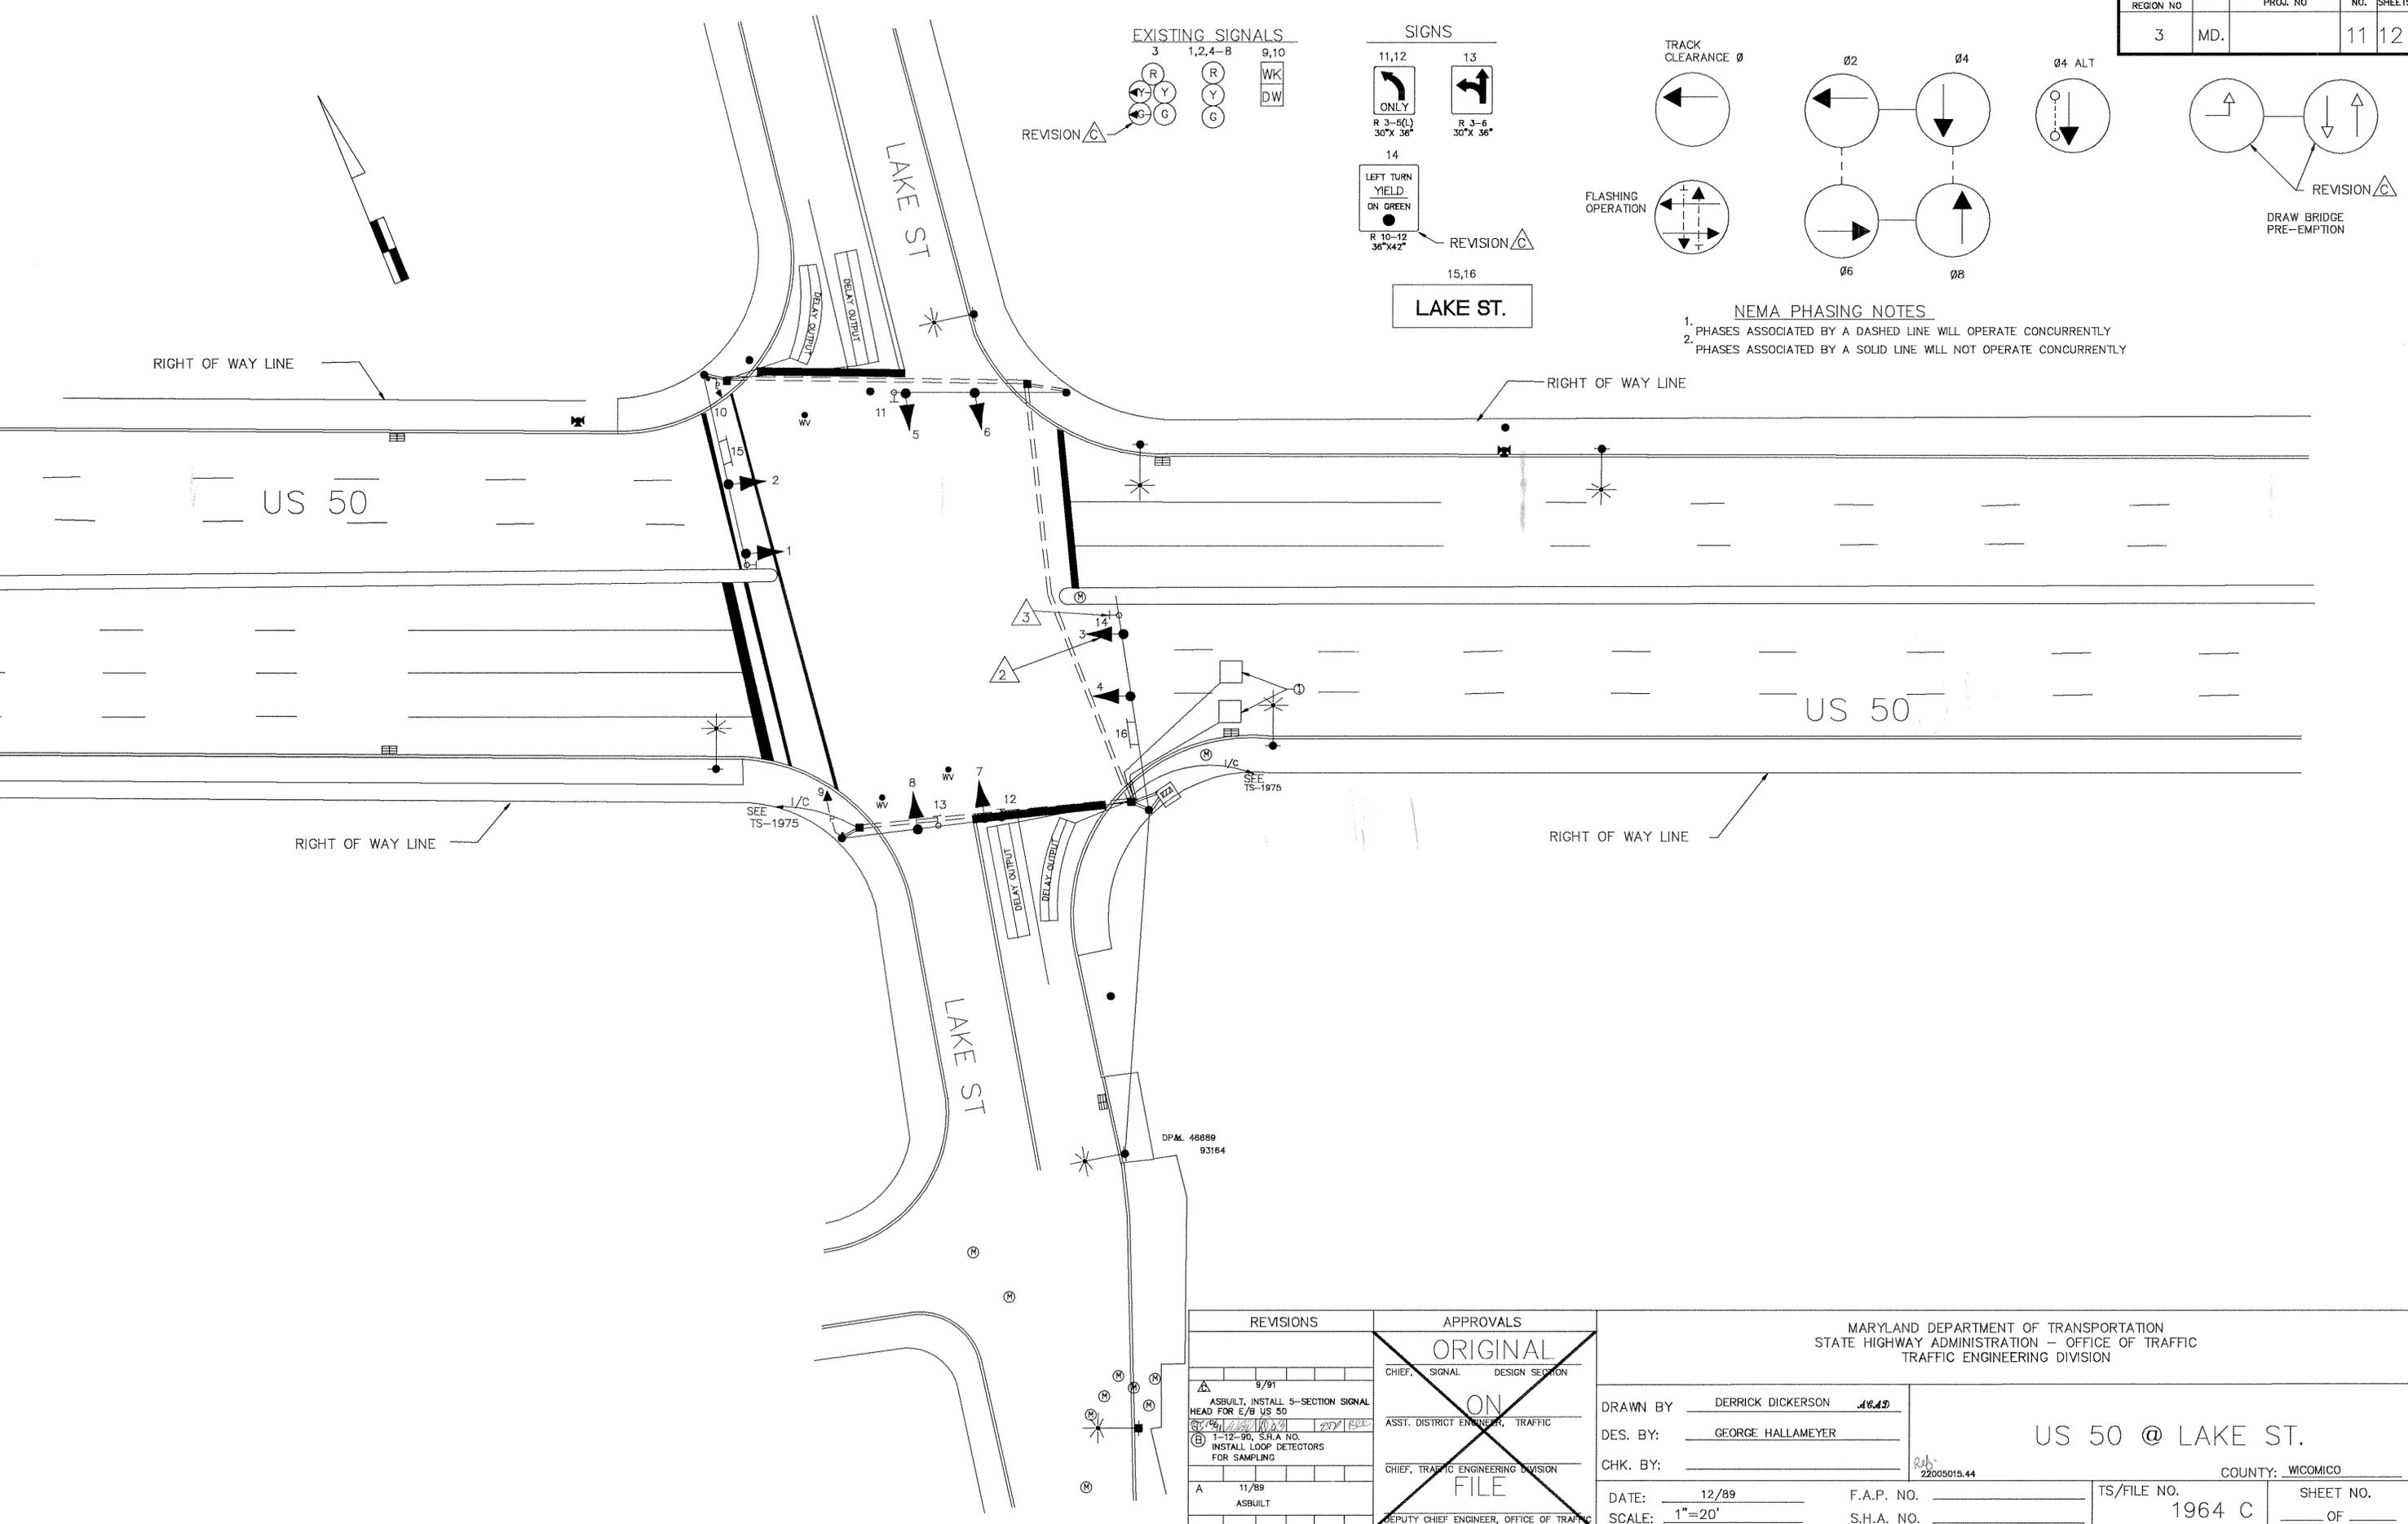

<p>REVISIONS</p> <table border="1"> <tr> <td>9/91</td> <td>ASBULT, INSTALL 5-SECTION SIGNAL HEAD FOR E/B US 50</td> </tr> <tr> <td>1-12-90</td> <td>S.H.A. NO. 2071 B02</td> </tr> <tr> <td></td> <td>INSTALL LOOP DETECTORS FOR SAMPLING</td> </tr> <tr> <td>11/89</td> <td>ASBULT</td> </tr> </table>		9/91	ASBULT, INSTALL 5-SECTION SIGNAL HEAD FOR E/B US 50	1-12-90	S.H.A. NO. 2071 B02		INSTALL LOOP DETECTORS FOR SAMPLING	11/89	ASBULT	<p>APPROVALS</p> <p>ORIGINAL</p> <p>CHIEF, SIGNAL DESIGN SECTION</p> <p>ON</p> <p>ASST. DISTRICT ENGINEER, TRAFFIC</p> <p>CHIEF, TRAFFIC ENGINEERING DIVISION</p> <p>FILE</p> <p>DEPUTY CHIEF ENGINEER, OFFICE OF TRAFFIC</p>		<p>MARYLAND DEPARTMENT OF TRANSPORTATION STATE HIGHWAY ADMINISTRATION - OFFICE OF TRAFFIC TRAFFIC ENGINEERING DIVISION</p>	
9/91	ASBULT, INSTALL 5-SECTION SIGNAL HEAD FOR E/B US 50												
1-12-90	S.H.A. NO. 2071 B02												
	INSTALL LOOP DETECTORS FOR SAMPLING												
11/89	ASBULT												
<p>DRAWN BY: DERRICK DICKERSON <i>dd</i></p> <p>DES. BY: GEORGE HALLAMEYER</p> <p>CHK. BY:</p>		<p>US 50 @ LAKE ST.</p> <p>COUNTY: WICOMICO</p>											
<p>DATE: 12/89</p> <p>SCALE: 1"=20'</p>		<p>F.A.P. NO. _____</p> <p>S.H.A. NO. _____</p>											
<p>TS/FILE NO. 1964 C</p>		<p>SHEET NO. _____ OF _____</p>											

