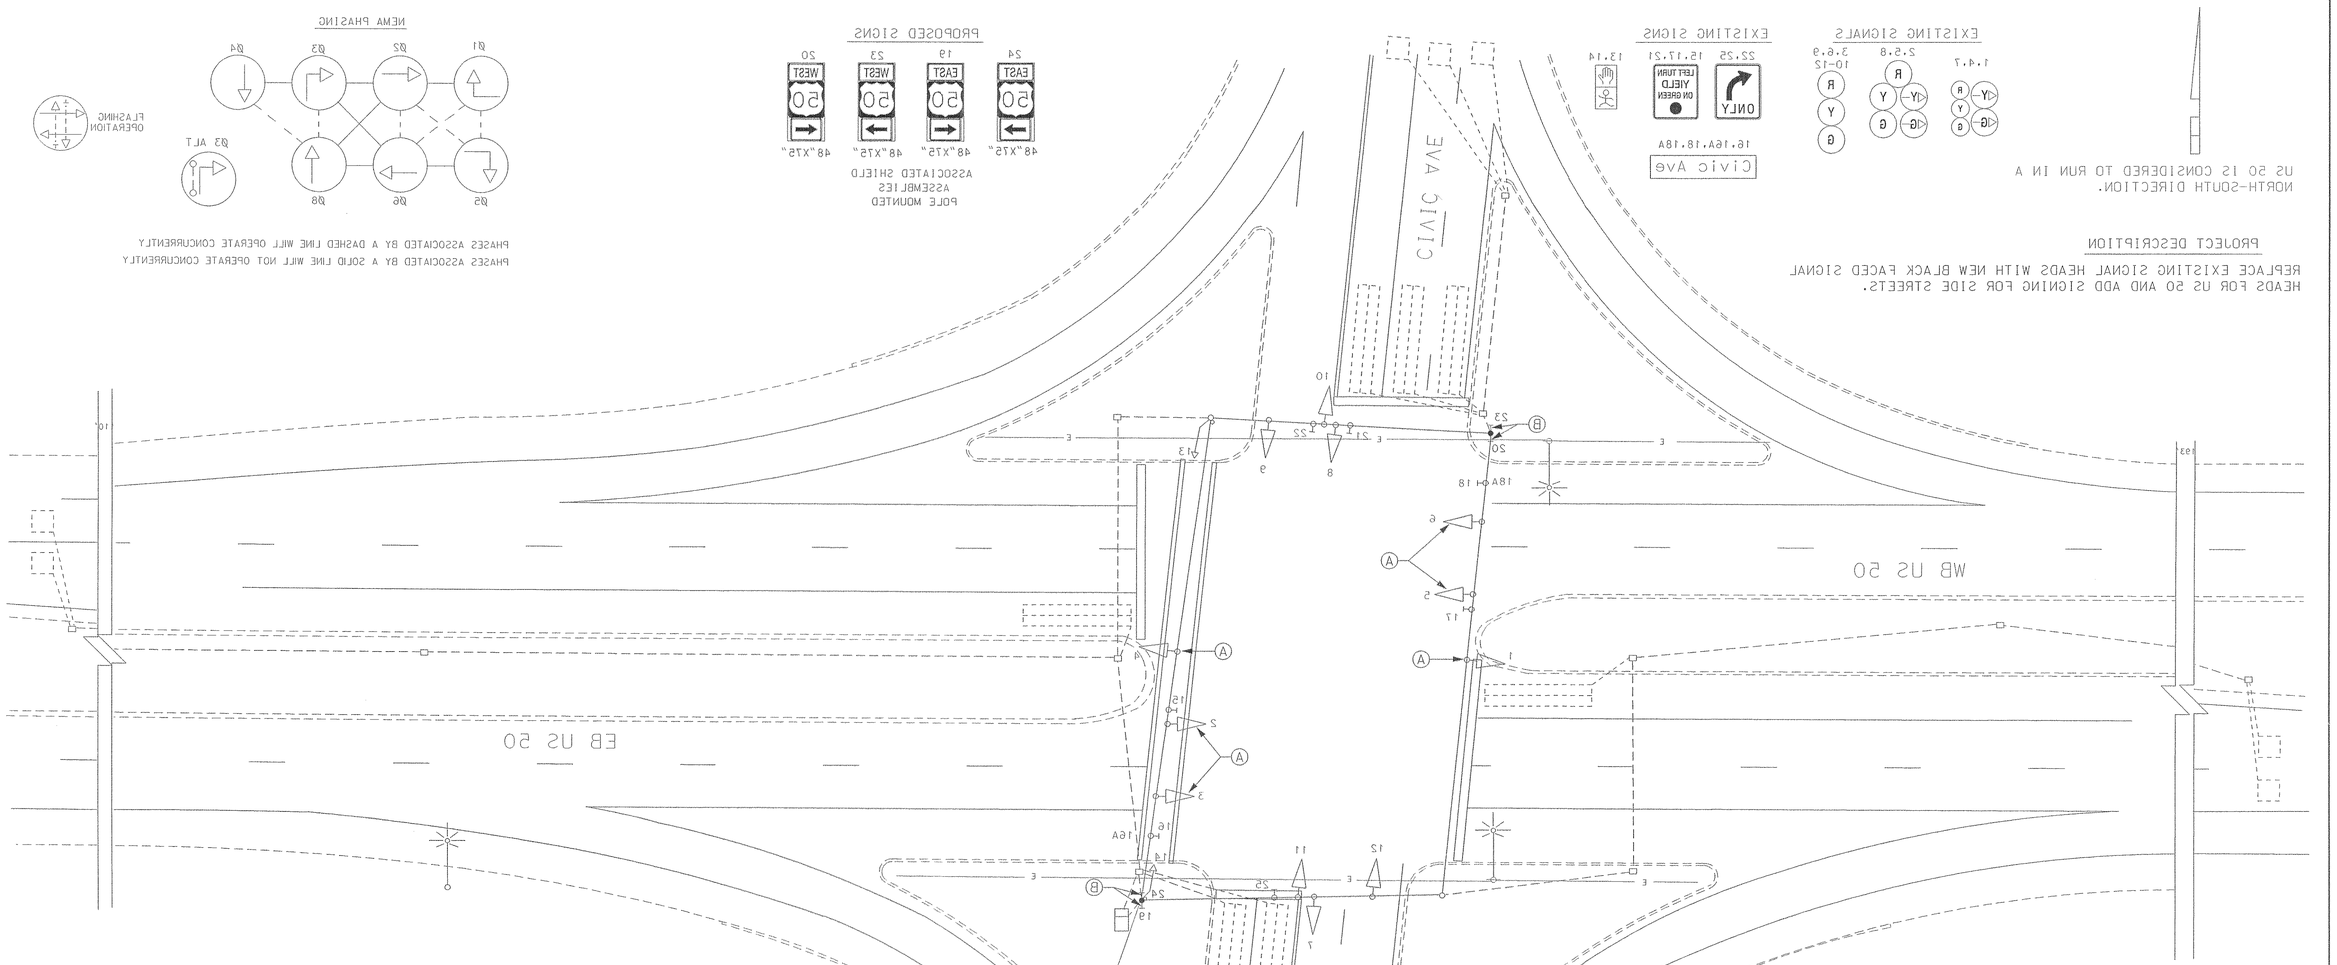

A. EQUIPMENT TO BE SUPPLIED BY THE ADMINISTRATION

QUANTITY	ITEM DESCRIPTION
100 SF	SHEET ALUMINUM SIGN AS SHOWN ABOVE (POLE MOUNTED)

B. EQUIPMENT TO BE SUPPLIED AND/OR INSTALLED BY THE CONTRACTOR

ITEM #	QUANTITY	ITEM DESCRIPTION
1001	1 EA	MAINTENANCE OF TRAFFIC
8053	100 SF	INSTALL OVERHEAD SIGN
~~8060~~	~~1 EA~~	~~REMOVE AND DISPOSE OF EXISTING EQUIPMENT PER ASSIGNMENT~~
8064	20 EA	FURNISH AND INSTALL 12" VEHICULAR TRAFFIC SIGNAL HEAD SECTION
8065	6 EA	FURNISH AND INSTALL 8" VEHICULAR TRAFFIC SIGNAL HEAD SECTION

C. EQUIPMENT TO BE RETURNED TO THE SHA

ALL EQUIPMENT THAT IS REMOVED SHALL BECOME THE PROPERTY OF THE CONTRACTOR.

MARYLAND DOT - STATE HIGHWAY ADMINISTRATION
Office of Traffic & Safety
TRAFFIC ENGINEERING DESIGN DIVISION
US 50 @ CIVIC AVE

DRAWN BY: B. THOMPSON	F.A.P. NO.	TS NO. 407-C	SHEET NO. 20 OF 24
CHECKED BY: A. BUDNINCHUK	S.H.A. NO.		
SCALE: 1:20	COUNTY: WICOMICO	T.M.S. NO. N/A	
DATE:	LOG MILE: 22005017.24		

APPROVALS

TEAM LEADER, TRAFFIC ENGINEERING DESIGN DIVISION
ASST. CHIEF TRAFFIC ENGINEERING DESIGN DIVISION
CHIEF, TRAFFIC ENGINEERING DESIGN DIVISION
DIRECTOR, TRAFFIC & SAFETY
ORIGINAL ON FILE

REVISIONS

TMZ		
A	ADD PED PHASE AND REVISE DETECTION	3/04
B	ADD US 50 EB'S, REDUT DETECTORS FOR SIDE STREET GEOMETRICS, & T/C FOR MD 350 @ CIVIC	8/02
C&S	REPLACE EXISTING SIGNAL HEADS WITH BLACK FACED HEADS FOR US 50 TIMSW EFBT	6/01