F H WA REGION NO	STATE	FED. AID PROJ. NO	SHEET NO.	TOTAL SHEETS
3	MD.		12	26

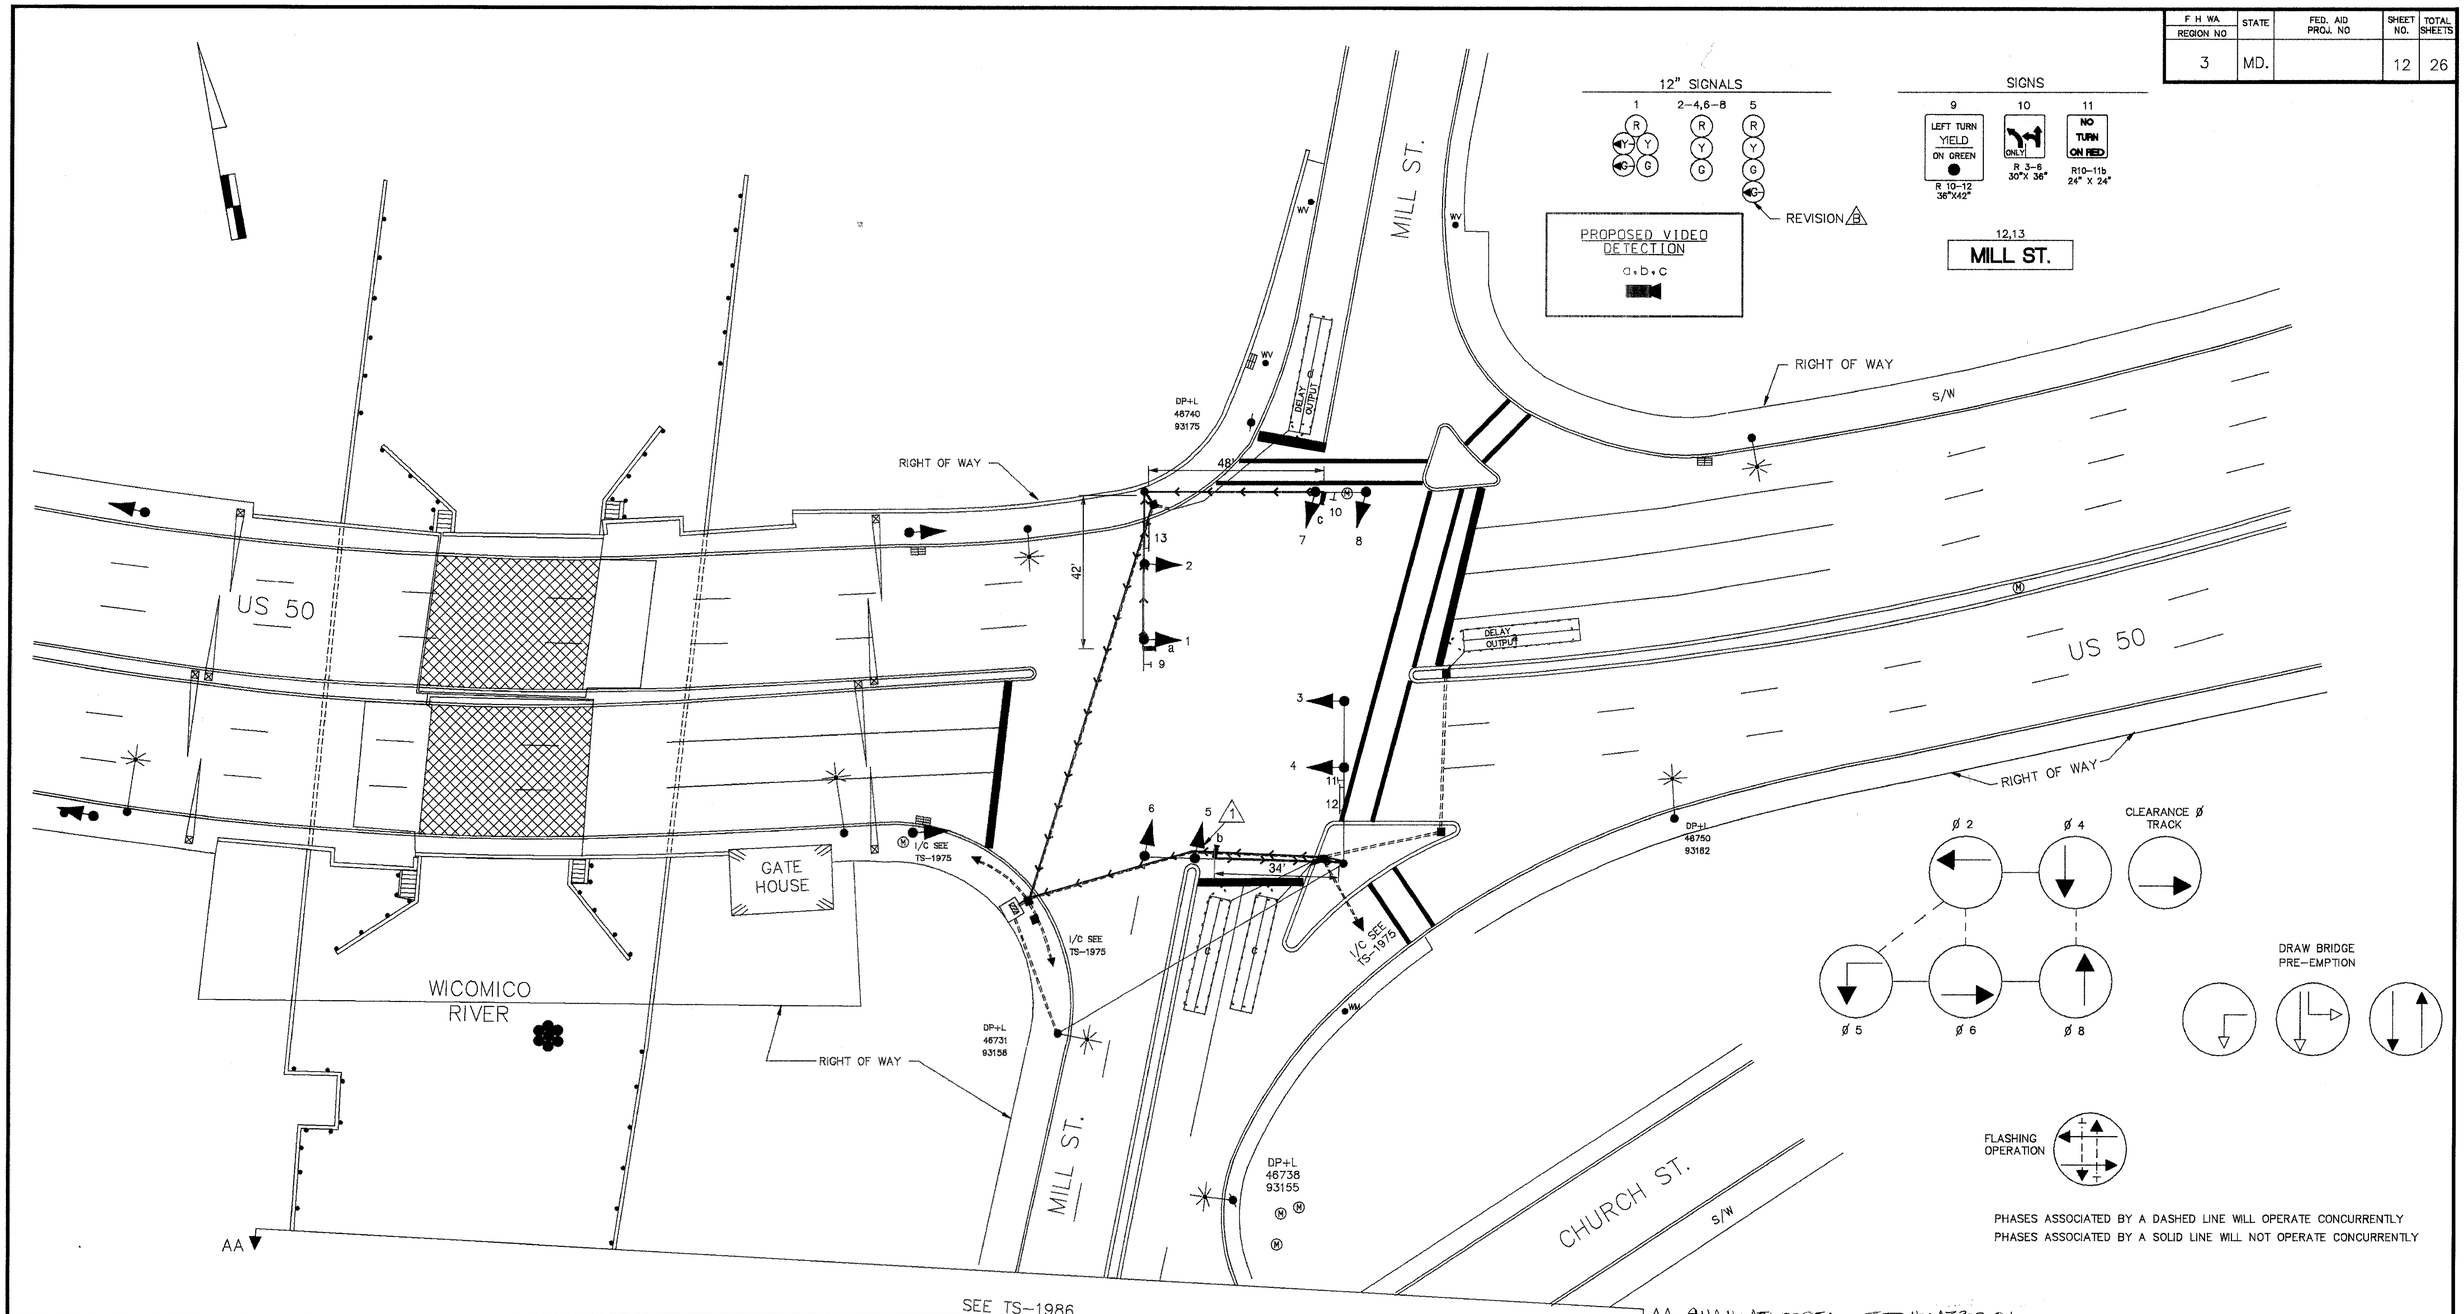

B. EQUIPMENT TO BE FURNISHED AND/OR INSTALLED BY THE CONTRACTOR.

CATEGORY CODE NO.	DESCRIPTION	UNITS	QUANTITY
8019	VIDEO DETECTION CAMERA	EA	3
8020	CONTROL CABLE, 250 FOOT VIDEO DETECTION CAMERA TO CONTROLLER	EA	3

VIDEO CAMERA LEGEND

= VIDEO CABLE (PATH TO CONTROLLER)

SABRA, WANG & ASSOCIATES, INC.
1504 JOH AVENUE
SUITE 160
BALTIMORE, MD 21227
(410) 737-6564
WWW.SABRA-WANG.COM

REVISIONS	APPROVALS
© 3/ /04 INSTALL VIDEO DETECTION SHA No. AT3085185 SWA	CHIEF, SIGNAL DESIGN SECTION
B 9/91 INSTALL 4-SECTION SIGNAL HEAD S/B MILL ST.	ASST. DISTRICT ENGINEER, TRAFFIC
A 4-10-85 ADJUST PHASING	CHIEF, TRAFFIC ENGINEERING DIVISION
TMZ DJD DAZ ETP TH	DEPUTY CHIEF ENGINEER, OFFICE OF TRAFFIC

THIS IS A REVISION TO S.H.A. CONTRACT NO. 331-502-184 THE ORIGINAL IS ON FILE

AA SHA#: AT400851 TOD#: AT308-01

MARYLAND DEPARTMENT OF TRANSPORTATION
STATE HIGHWAY ADMINISTRATION – OFFICE OF TRAFFIC
TRAFFIC ENGINEERING DIVISION

DRAWN BY STEWART P. REYNA
DES. BY:
CHK. BY:
DATE: 7-11-91
SCALE: 1"=20'

US 50 & MILL ST.

2200500000

COUNTY: WICOMICO

F.A.P. NO.
S.H.A. NO.

TS/FILE NO. 1929 ☒ C

SHEET NO. 12 OF 26

FILE: r:\02-12 2001-12\c\rcak 12\wwg\tff\wicomico\50_mill.dgn
DATE: 27-Feb-04 10:08