F H WA REGION NO	STATE	FED. AID PROJ. NO	SHEET NO.	TOTAL SHEETS
3	MD.		12	26

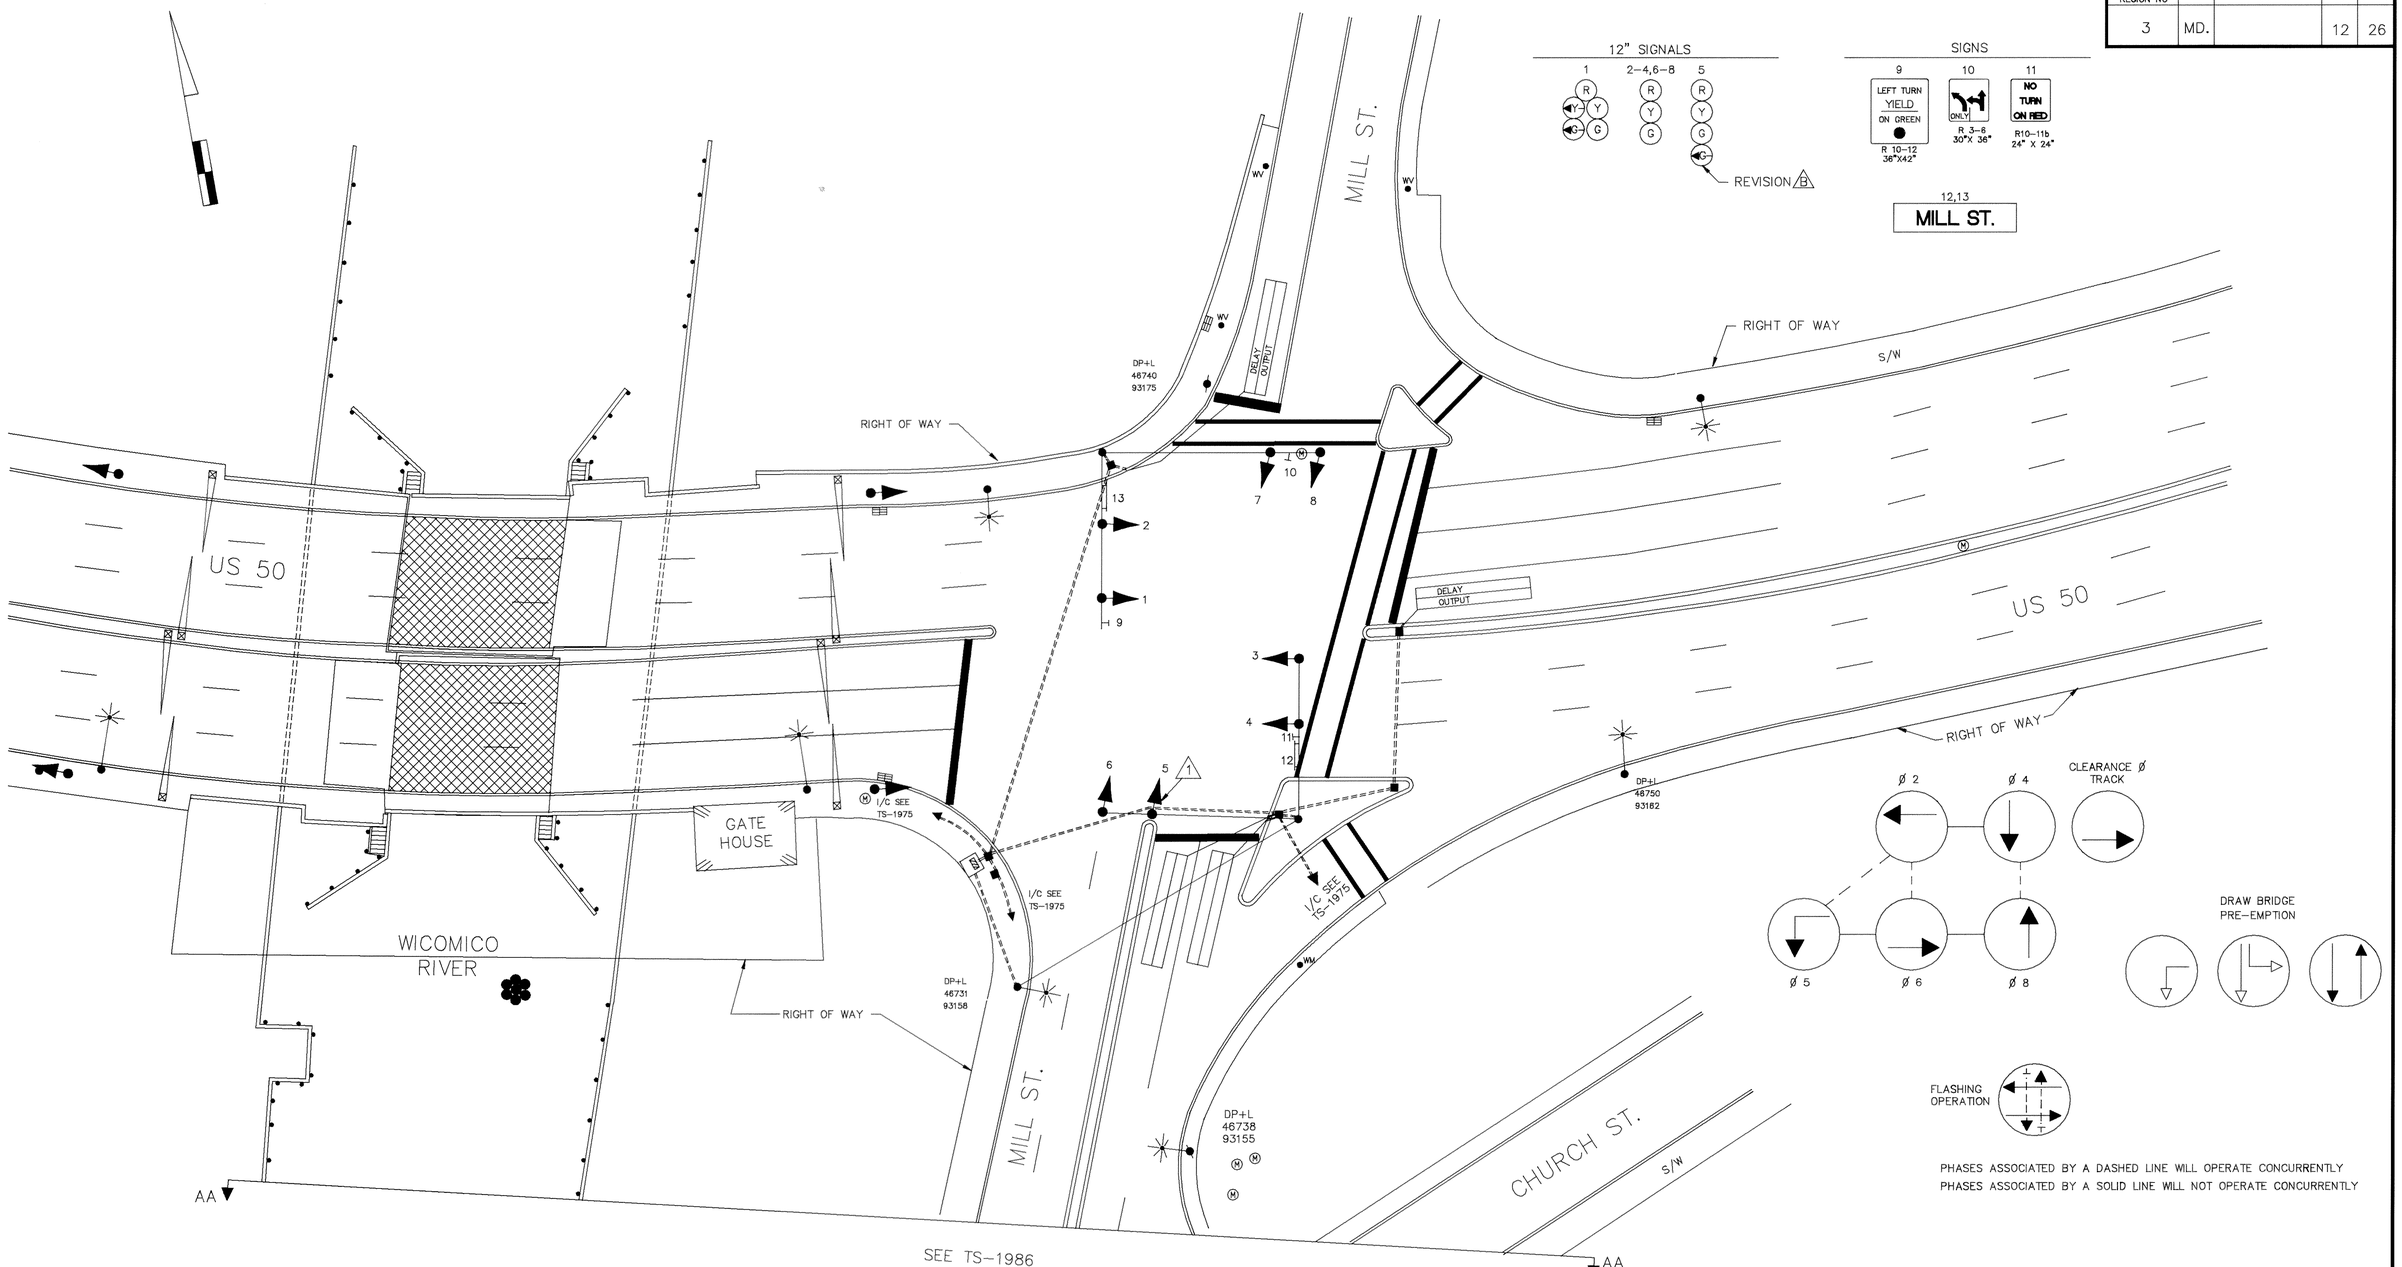

REVISIONS	APPROVALS
B 9/91 INSTALL 4-SECTION SIGNAL HEAD S/B MILL ST.	CHIEF, SIGNAL DESIGN SECTION
A 4-10-85 ADJUST PHASING	ASST. DISTRICT ENGINEER, TRAFFIC
TMZ DJD DAZ ETP TH	CHIEF, TRAFFIC ENGINEERING DIVISION
	DEPUTY CHIEF ENGINEER, OFFICE OF TRAFFIC

THIS IS A REVISION TO S.H.A. CONTRACT NO. WI-632-502-185 THE ORIGINAL IS ON FILE

MARYLAND DEPARTMENT OF TRANSPORTATION
STATE HIGHWAY ADMINISTRATION – OFFICE OF TRAFFIC
TRAFFIC ENGINEERING DIVISION

DRAWN BY STEWART P. REYNA
DES. BY:
CHK. BY:

US 50 & MILL ST.

22005000.00

COUNTY: WICOMICO

DATE: 7-11-91
SCALE: 1"=20'
F.A.P. NO.
S.H.A. NO.
TS/FILE NO. 1929 B
SHEET NO. 12 OF 26

Folder #60

22005000.00 Ref 15.54