F H WA REGION NO	STATE	FED. AID PROJ. NO	SHEET NO.	TOTAL SHEETS
3	MD.		13	26

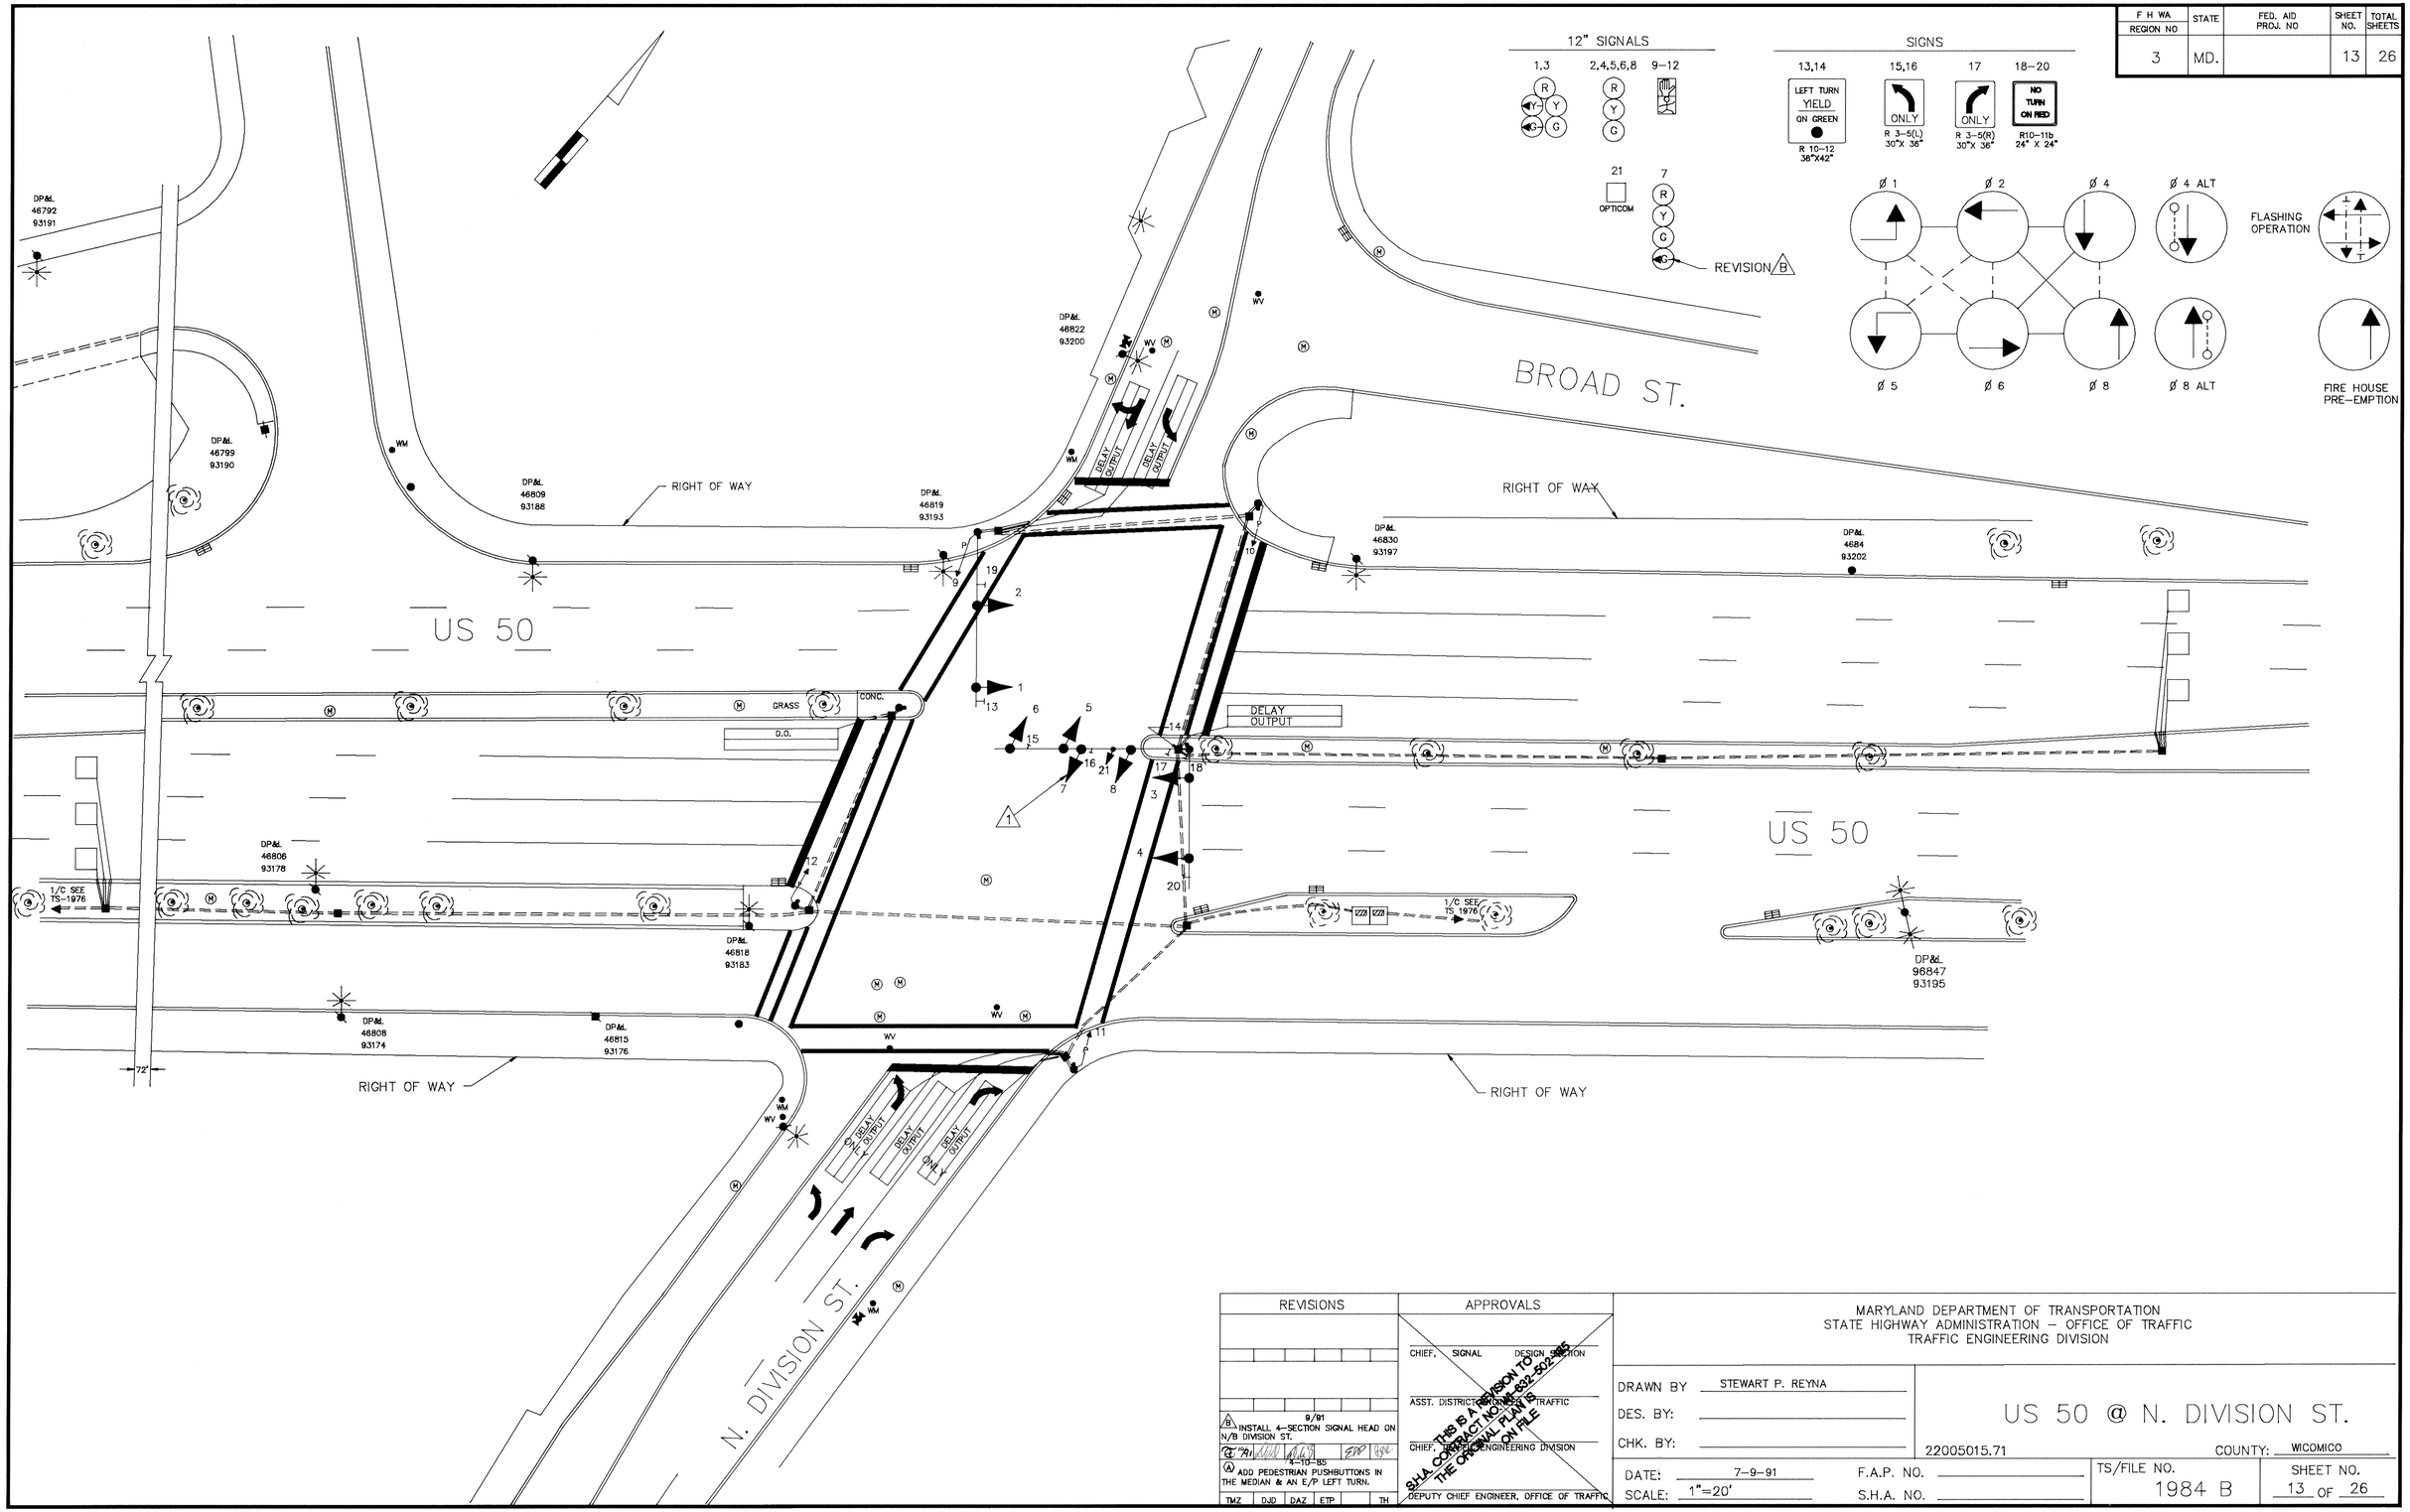

REVISIONS	APPROVALS
9/91 INSTALL 4-SECTION SIGNAL HEAD ON N/B DIVISION ST.	CHIEF, SIGNAL DESIGN SECTION
4-10-85 ADD PEDESTRIAN PUSHBUTTONS IN THE MEDIAN & AN E/P LEFT TURN.	ASST. DISTRICT ENGINEER TRAFFIC
TMZ DJD DAZ ETP TH	CHIEF, TRAFFIC ENGINEERING DIVISION
	DEPUTY CHIEF ENGINEER, OFFICE OF TRAFFIC

THIS IS A REVISION TO S.H.A. CONTRACT NO. WI-632-502-785 THE ORIGINAL PLAN IS ON FILE

MARYLAND DEPARTMENT OF TRANSPORTATION
STATE HIGHWAY ADMINISTRATION – OFFICE OF TRAFFIC
TRAFFIC ENGINEERING DIVISION

DRAWN BY STEWART P. REYNA
DES. BY:
CHK. BY:

US 50 @ N. DIVISION ST.

22005015.71

COUNTY: WICOMICO

DATE: 7-9-91
SCALE: 1"=20'
F.A.P. NO.
S.H.A. NO.

TS/FILE NO. 1984 B

SHEET NO. 13 OF 26

F#60

22005015.71