F.H.W.A. REGION NO.	STATE	FED. AID PROJ. NO.	SHEET NO.	TOTAL SHEETS
3	MD		1	1

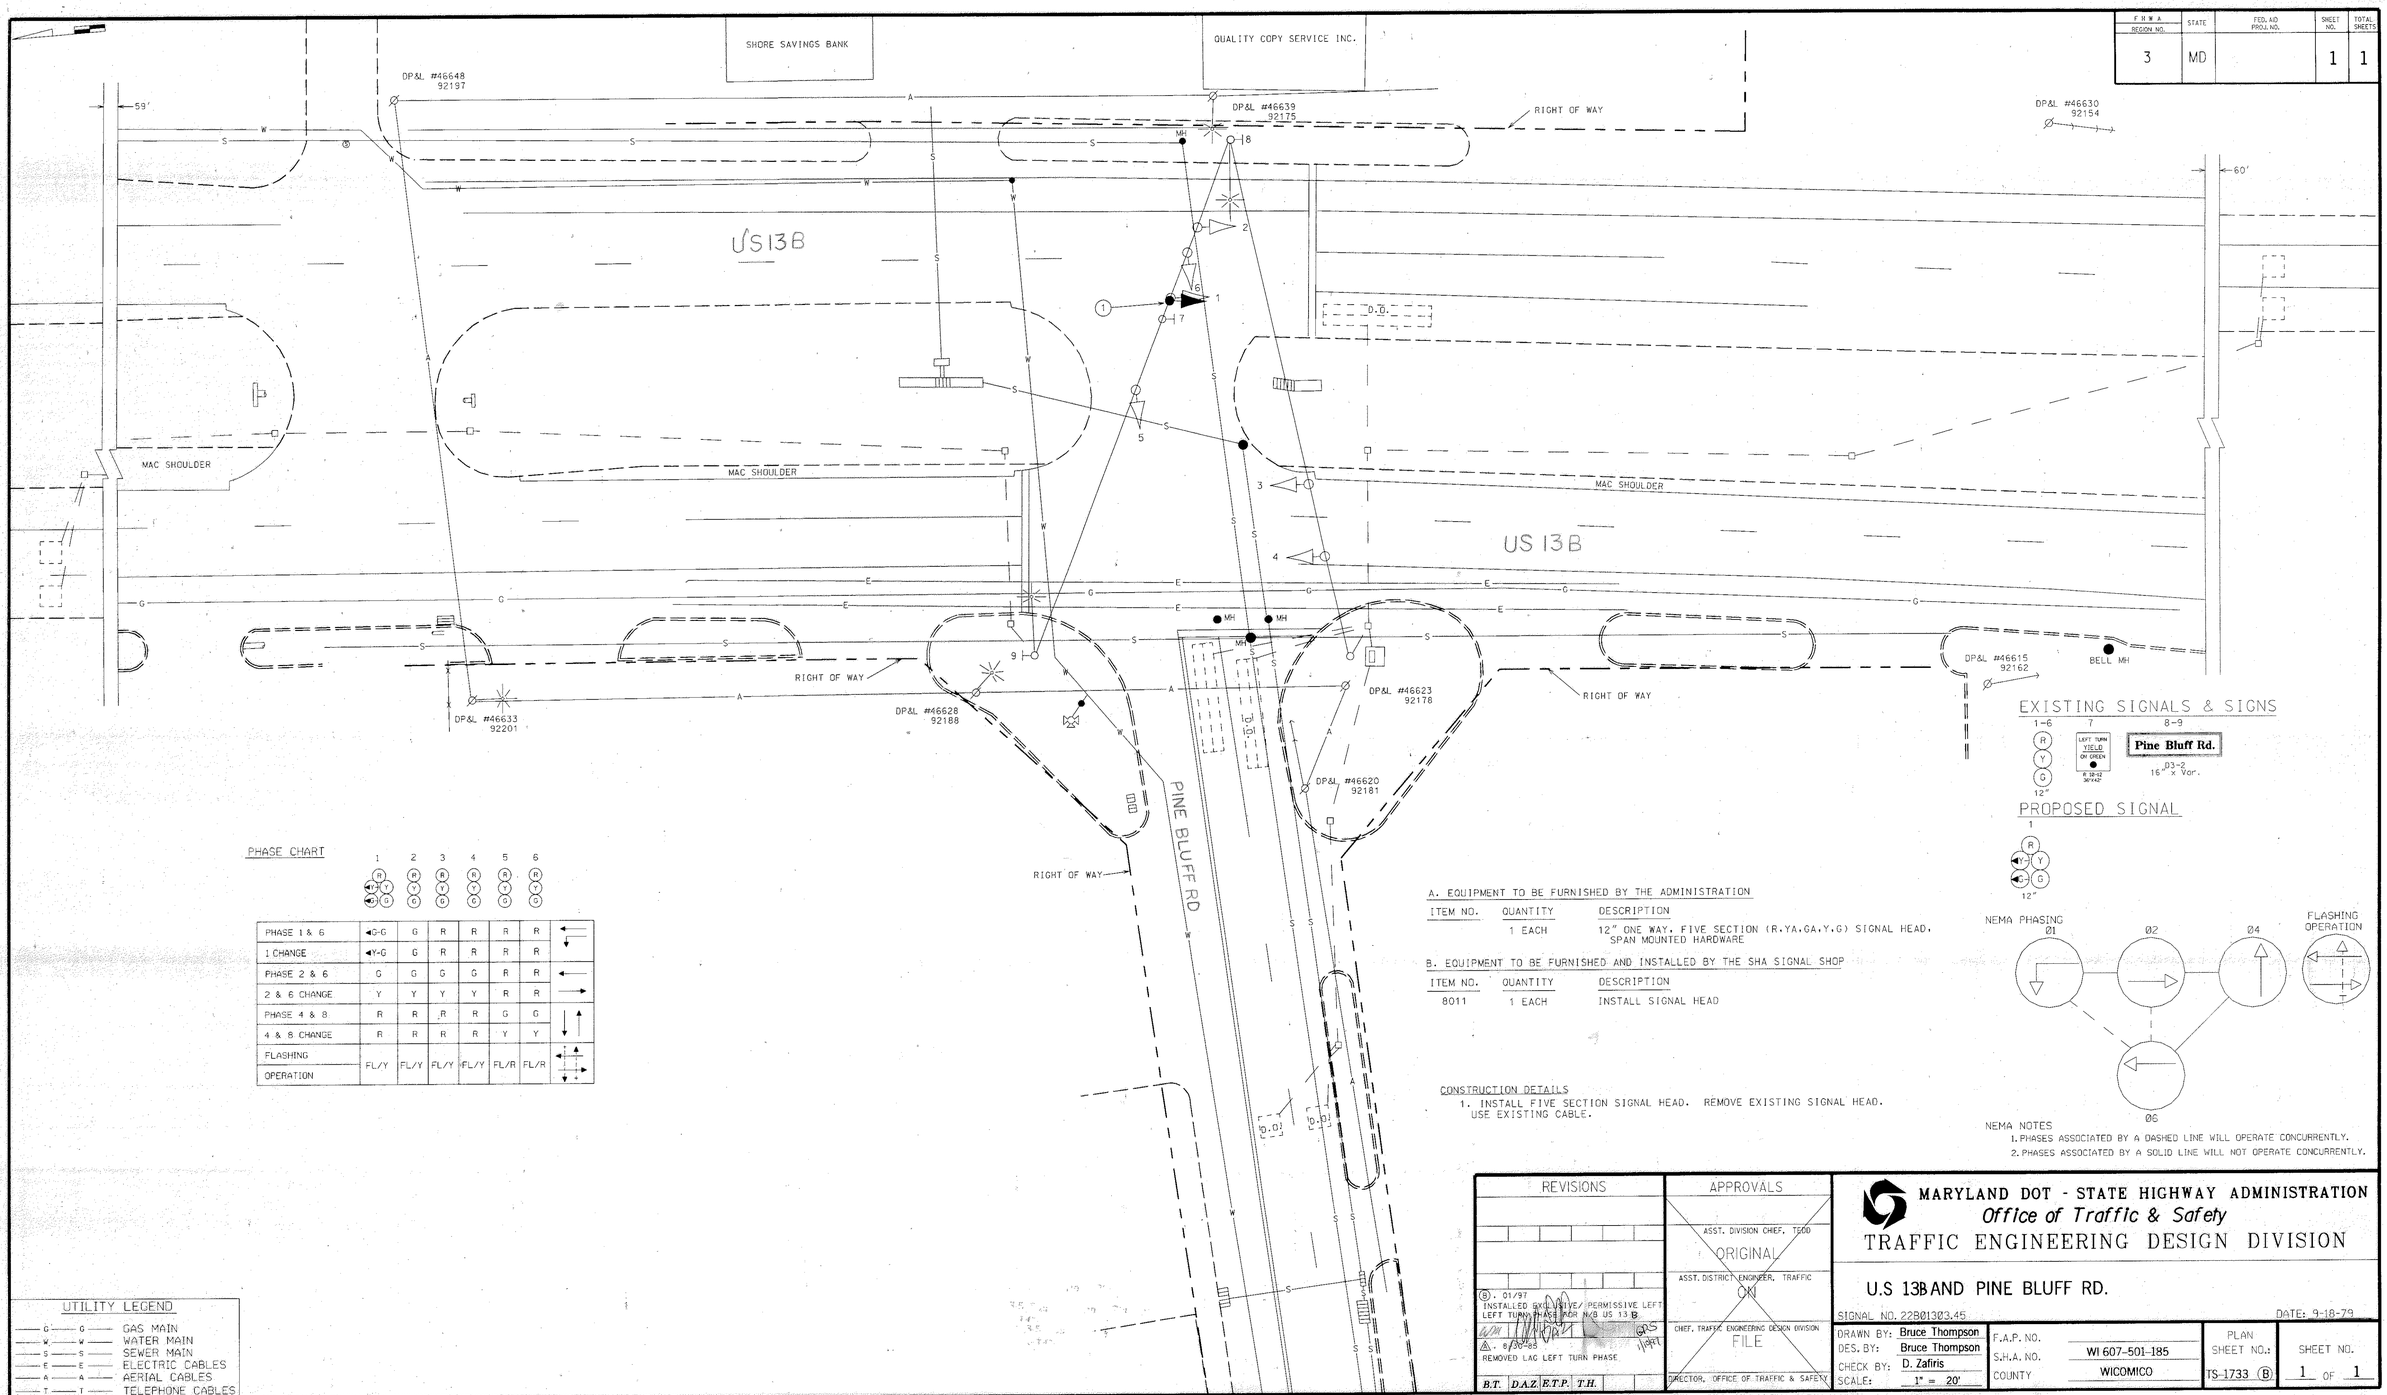

PHASE CHART

	1	2	3	4	5	6
PHASE 1 & 6	G-G	G	R	R	R	R
1 CHANGE	Y-G	G	R	R	R	R
PHASE 2 & 6	G	G	G	G	R	R
2 & 6 CHANGE	Y	Y	Y	Y	R	R
PHASE 4 & 8	R	R	R	R	G	G
4 & 8 CHANGE	R	R	R	R	Y	Y
FLASHING OPERATION	FL/Y	FL/Y	FL/Y	FL/Y	FL/R	FL/R

A. EQUIPMENT TO BE FURNISHED BY THE ADMINISTRATION

ITEM NO.	QUANTITY	DESCRIPTION
	1 EACH	12" ONE WAY, FIVE SECTION (R,YA,GA,Y,G) SIGNAL HEAD, SPAN MOUNTED HARDWARE

B. EQUIPMENT TO BE FURNISHED AND INSTALLED BY THE SHA SIGNAL SHOP

ITEM NO.	QUANTITY	DESCRIPTION
8011	1 EACH	INSTALL SIGNAL HEAD

CONSTRUCTION DETAILS

1. INSTALL FIVE SECTION SIGNAL HEAD. REMOVE EXISTING SIGNAL HEAD. USE EXISTING CABLE.

NEMA NOTES

1. PHASES ASSOCIATED BY A DASHED LINE WILL OPERATE CONCURRENTLY.
2. PHASES ASSOCIATED BY A SOLID LINE WILL NOT OPERATE CONCURRENTLY.

UTILITY LEGEND

- G — GAS MAIN
- W — WATER MAIN
- S — SEWER MAIN
- E — ELECTRIC CABLES
- A — AERIAL CABLES
- T — TELEPHONE CABLES

REVISIONS	APPROVALS
Ⓑ. 01/97 INSTALLED EXCLUSIVE/ PERMISSIVE LEFT LEFT TURN PHASE FOR N/B US 13 B	ASST. DIVISION CHIEF, TSDD: ORIGINAL
Ⓐ. 8/30/88 REMOVED LAG LEFT TURN PHASE	ASST. DISTRICT ENGINEER, TRAFFIC: CKI
B.T. D.A.Z. E.T.P. T.H.	CHIEF, TRAFFIC ENGINEERING DESIGN DIVISION: FILE
	DIRECTOR, OFFICE OF TRAFFIC & SAFETY

MARYLAND DOT - STATE HIGHWAY ADMINISTRATION
Office of Traffic & Safety
TRAFFIC ENGINEERING DESIGN DIVISION

U.S 13B AND PINE BLUFF RD.

SIGNAL NO. 22B01303.45 DATE: 9-18-79

DRAWN BY: Bruce Thompson	F.A.P. NO.		PLAN SHEET NO.	SHEET NO.
DES. BY: Bruce Thompson	S.H.A. NO.	WI 607-501-185	TS-1733 Ⓑ	1 OF 1
CHECK BY: D. Zafiris	COUNTY	WICOMICO		
SCALE: 1" = 20'				

Log Mile 22B01303.45

I:\sgnl\ha4072a\ul3pln.dgn Jan. 07, 1997 15:22:58