K&E BALTIMORE 17 0153 PHOENIX 10-75 MC 4156

F.H.W.A. REGION NO.	STATE	FED. AID PROJ. NO.	SHEET NO.	TOTAL SHEETS
3	MD.		2	10

NOTE: ~~INTERCONNECT CABLE WILL BE ATTACHED TO ROAD SIDE FACE OF WOOD POLES.~~

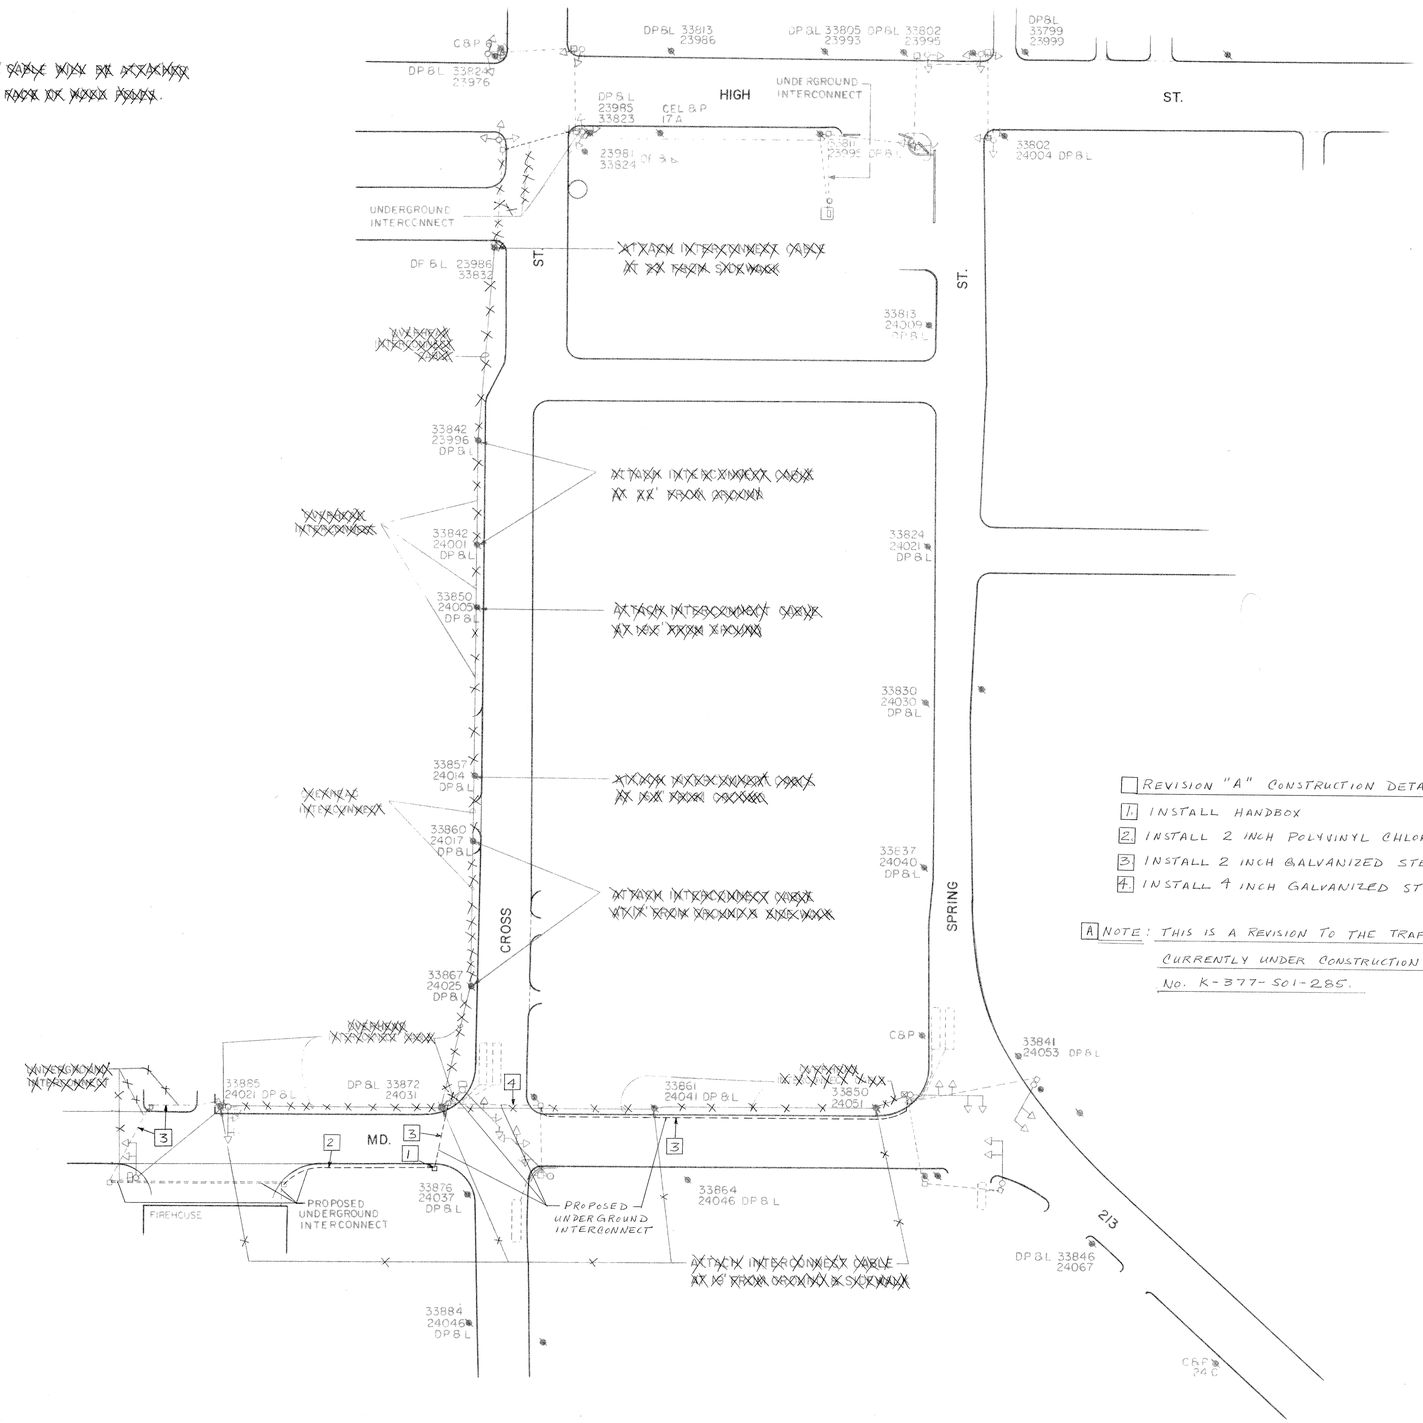

REVISION "A" CONSTRUCTION DETAILS

1. INSTALL HANDBOX
2. INSTALL 2 INCH POLYVINYL CHLORIDE ELECTRICAL CONDUIT
3. INSTALL 2 INCH GALVANIZED STEEL ELECTRICAL CONDUIT
4. INSTALL 4 INCH GALVANIZED STEEL ELECTRICAL CONDUIT

A NOTE: THIS IS A REVISION TO THE TRAFFIC SIGNAL PROJECT CURRENTLY UNDER CONSTRUCTION UNDER CONTRACT No. K-377-501-285.

APPROVAL: REGIONAL TRAFFIC ENGINEER

APPROVAL: CHIEF-BUREAU OF TRAFFIC ENGINEERING 6/7/82

APPROVAL: ASS'T. CHIEF ENGINEER TRAFFIC 6-8-82

A 11-16-82 ELIM. ALL OH INTERC. INSTALL UNDERGROUND INTERC. FOR COORD. & PRE-EMPT ALONG MD 213

DJD 11/17/82 TH 11/17/82

REVISIONS

STATE OF MARYLAND
DEPARTMENT OF TRANSPORTATION
STATE HIGHWAY ADMINISTRATION

TRAFFIC DIVISION – BUREAU OF TRAFFIC ENGINEERING

SIGNAL INTERCONNECT ROUTE

SCALE 1"=50'-0" DATE 9-12-79 CONTRACT NO. K-377-501-285

DRAWN BY: L. PARKER COUNTY: KENT

DESIGNED BY: K. KEITT SIGNAL NO.:

CHECKED BY: 6/7/82

DRAWING NO. TS-1678 A

14000000.01