REGION NO.	STATE	FED. AID PROJ. NO.	SHEET NO.	TOTAL SHEETS
3	MD			

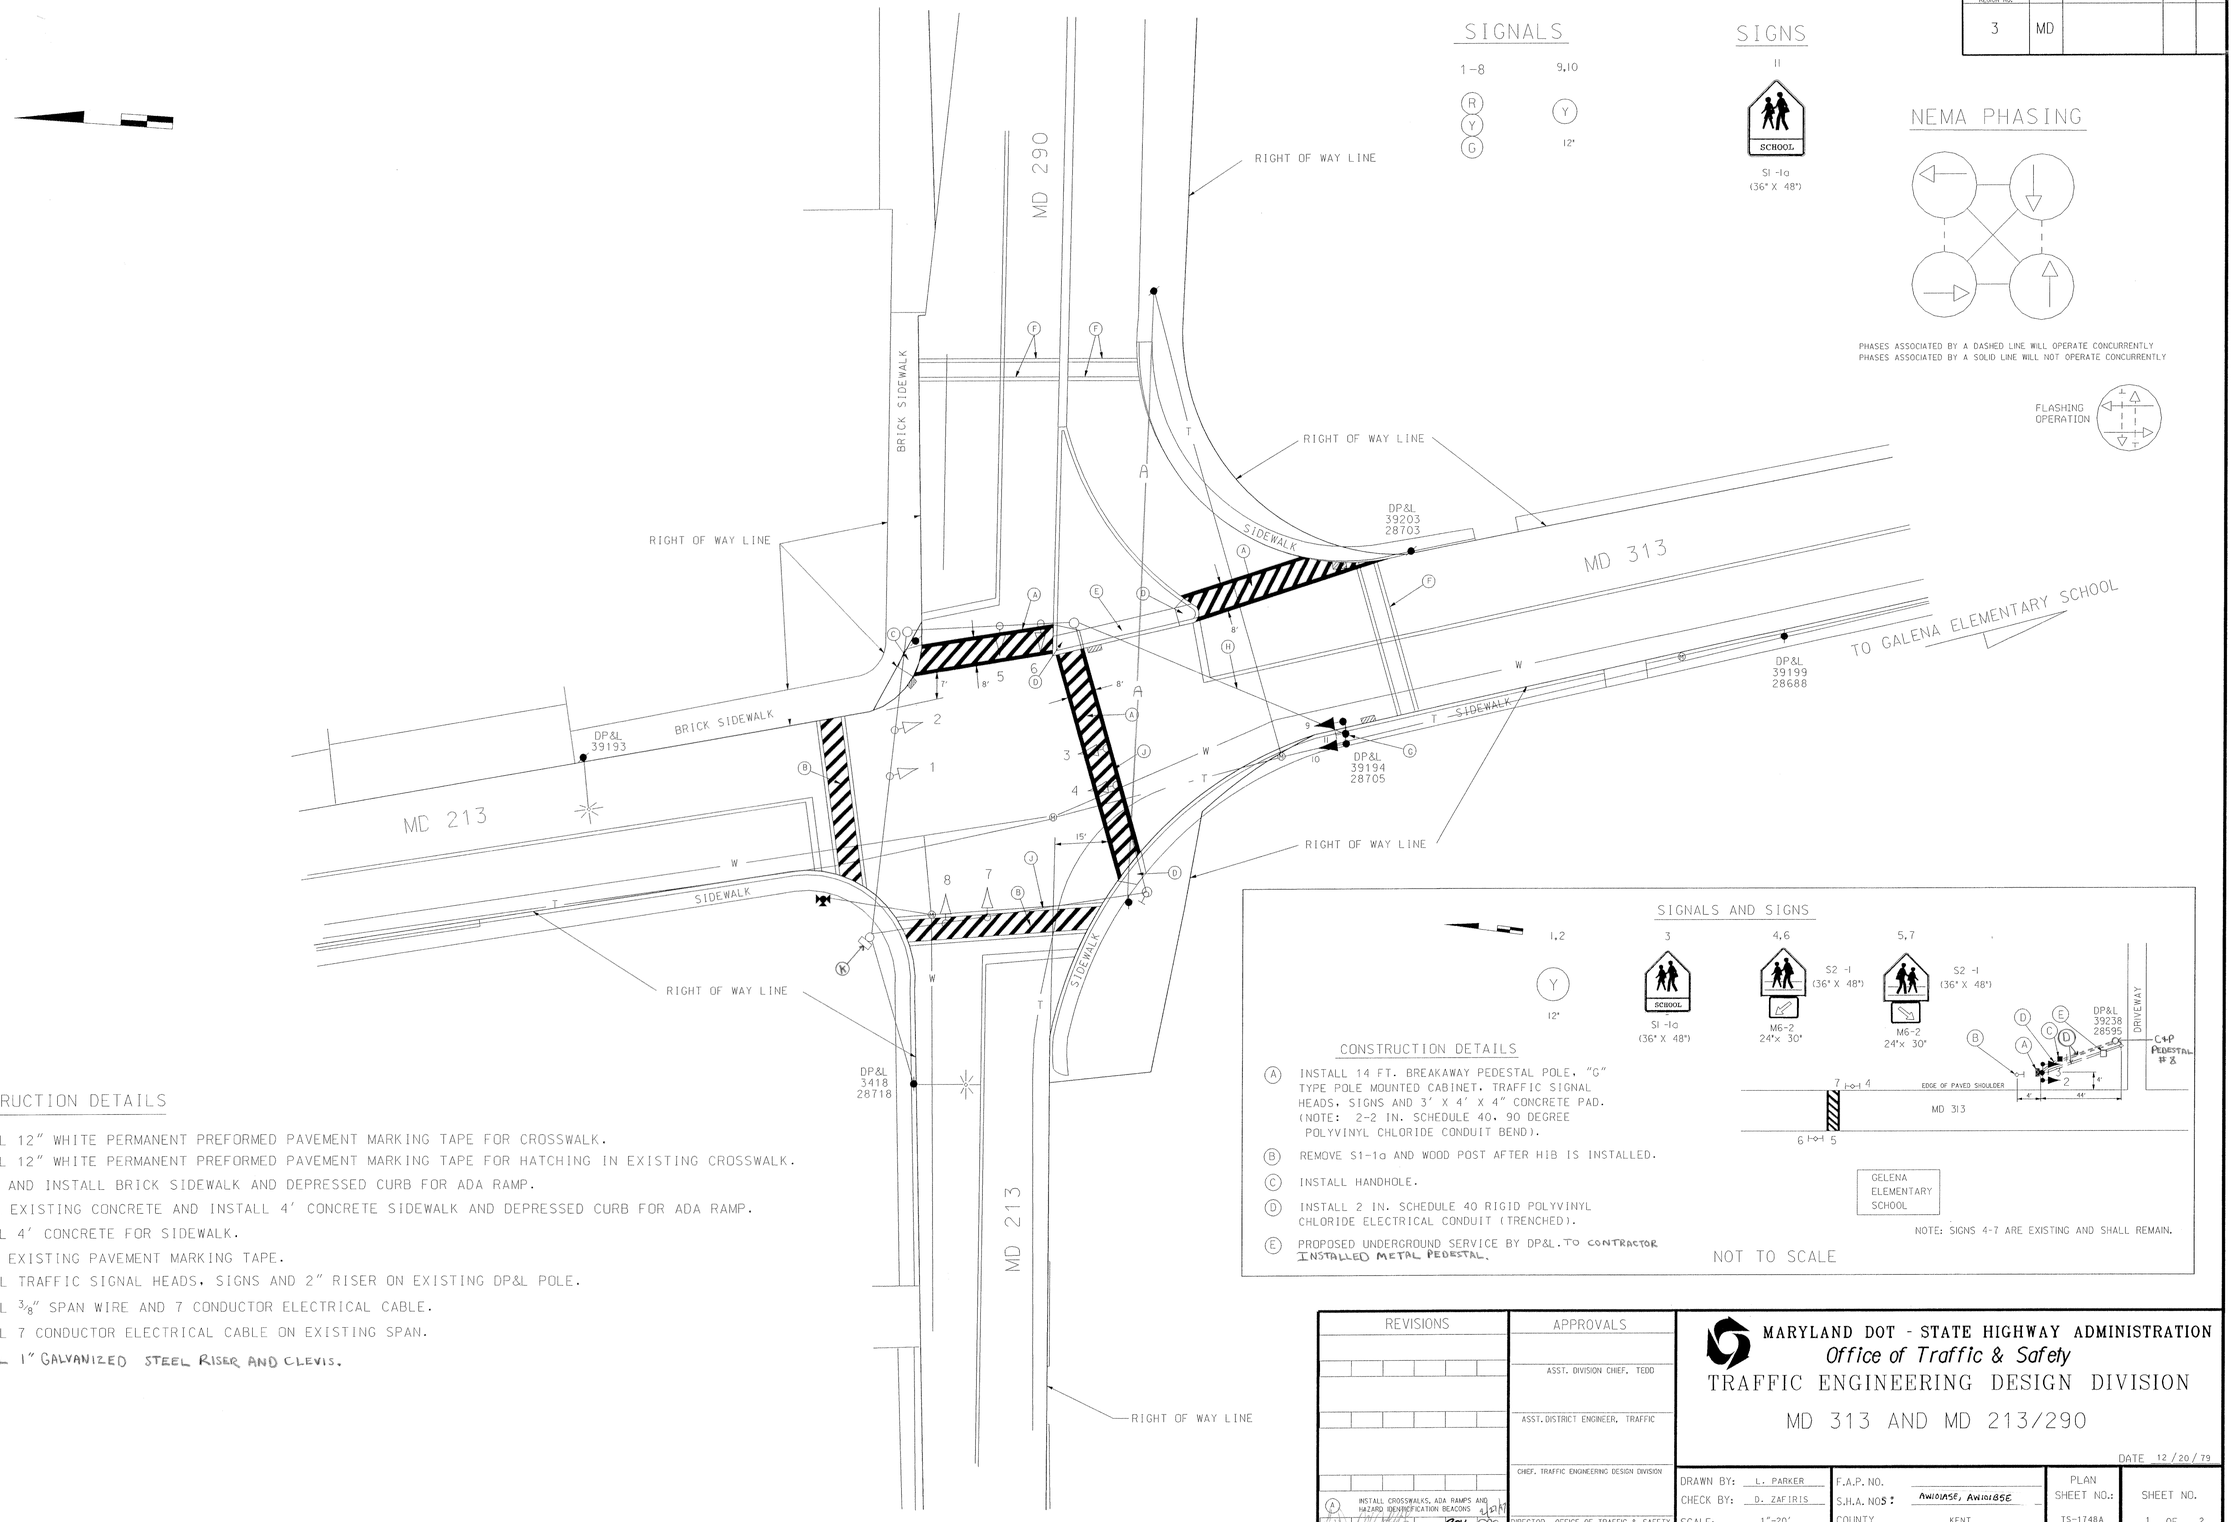

CONSTRUCTION DETAILS

- (A) INSTALL 12" WHITE PERMANENT PREFORMED PAVEMENT MARKING TAPE FOR CROSSWALK.
- (B) INSTALL 12" WHITE PERMANENT PREFORMED PAVEMENT MARKING TAPE FOR HATCHING IN EXISTING CROSSWALK.
- (C) REMOVE AND INSTALL BRICK SIDEWALK AND DEPRESSED CURB FOR ADA RAMP.
- (D) REMOVE EXISTING CONCRETE AND INSTALL 4' CONCRETE SIDEWALK AND DEPRESSED CURB FOR ADA RAMP.
- (E) INSTALL 4' CONCRETE FOR SIDEWALK.
- (F) REMOVE EXISTING PAVEMENT MARKING TAPE.
- (G) INSTALL TRAFFIC SIGNAL HEADS, SIGNS AND 2" RISER ON EXISTING DP&L POLE.
- (H) INSTALL 3/8" SPAN WIRE AND 7 CONDUCTOR ELECTRICAL CABLE.
- (J) INSTALL 7 CONDUCTOR ELECTRICAL CABLE ON EXISTING SPAN.
- (K) INSTALL 1" GALVANIZED STEEL RISER AND CLEVIS.

SIGNALS AND SIGNS

NOTE: SIGNS 4-7 ARE EXISTING AND SHALL REMAIN.

NOT TO SCALE

CONSTRUCTION DETAILS

- (A) INSTALL 14 FT. BREAKAWAY PEDESTAL POLE, "G" TYPE POLE MOUNTED CABINET, TRAFFIC SIGNAL HEADS, SIGNS AND 3' X 4' X 4" CONCRETE PAD. (NOTE: 2-2 IN. SCHEDULE 40, 90 DEGREE POLYVINYL CHLORIDE CONDUIT BEND).
- (B) REMOVE S1-1a AND WOOD POST AFTER HIB IS INSTALLED.
- (C) INSTALL HANDHOLE.
- (D) INSTALL 2 IN. SCHEDULE 40 RIGID POLYVINYL CHLORIDE ELECTRICAL CONDUIT (TRENCHED).
- (E) PROPOSED UNDERGROUND SERVICE BY DP&L. TO CONTRACTOR INSTALLED METAL PEDESTAL.

REVISIONS	APPROVALS
	ASST. DIVISION CHIEF, TEDD
	ASST. DISTRICT ENGINEER, TRAFFIC
	CHIEF, TRAFFIC ENGINEERING DESIGN DIVISION
(A) INSTALL CROSSWALKS, ADA RAMPS AND HAZARD IDENTIFICATION BEACONS 4/27/97 BEK GRS	DIRECTOR, OFFICE OF TRAFFIC & SAFETY

MARYLAND DOT - STATE HIGHWAY ADMINISTRATION
Office of Traffic & Safety
TRAFFIC ENGINEERING DESIGN DIVISION

MD 313 AND MD 213/290

DATE 12/20/79

DRAWN BY: L. PARKER	F.A.P. NO.		PLAN SHEET NO.:	SHEET NO.
CHECK BY: D. ZAFIRIS	S.H.A. NOS:	AW101A5E, AW101B5E	TS-1748A	1 OF 2
SCALE: 1"=20'	COUNTY	KENT		

Log M.le: 140 & 1316.12

I:\sgnl\ha9058a\m313ss01.dgn Feb. 27, 1997 14:21:43