F H WA REGION NO	STATE	FED. AID PROJ. NO	SHEET NO.	TOTAL SHEETS
3	MD.			

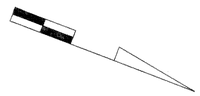

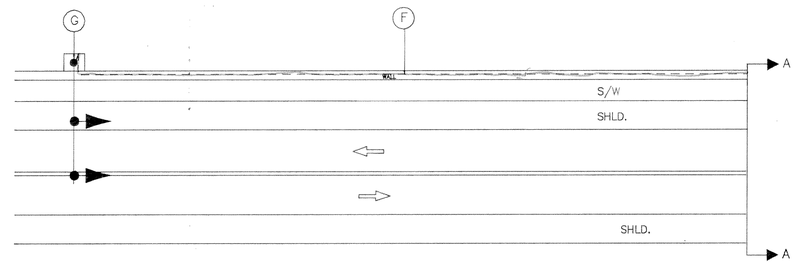

SIGNALS
1,2
Y

SIGN
3

DRAWBRIDGE
PREPARE
TO STOP
132" X 72"

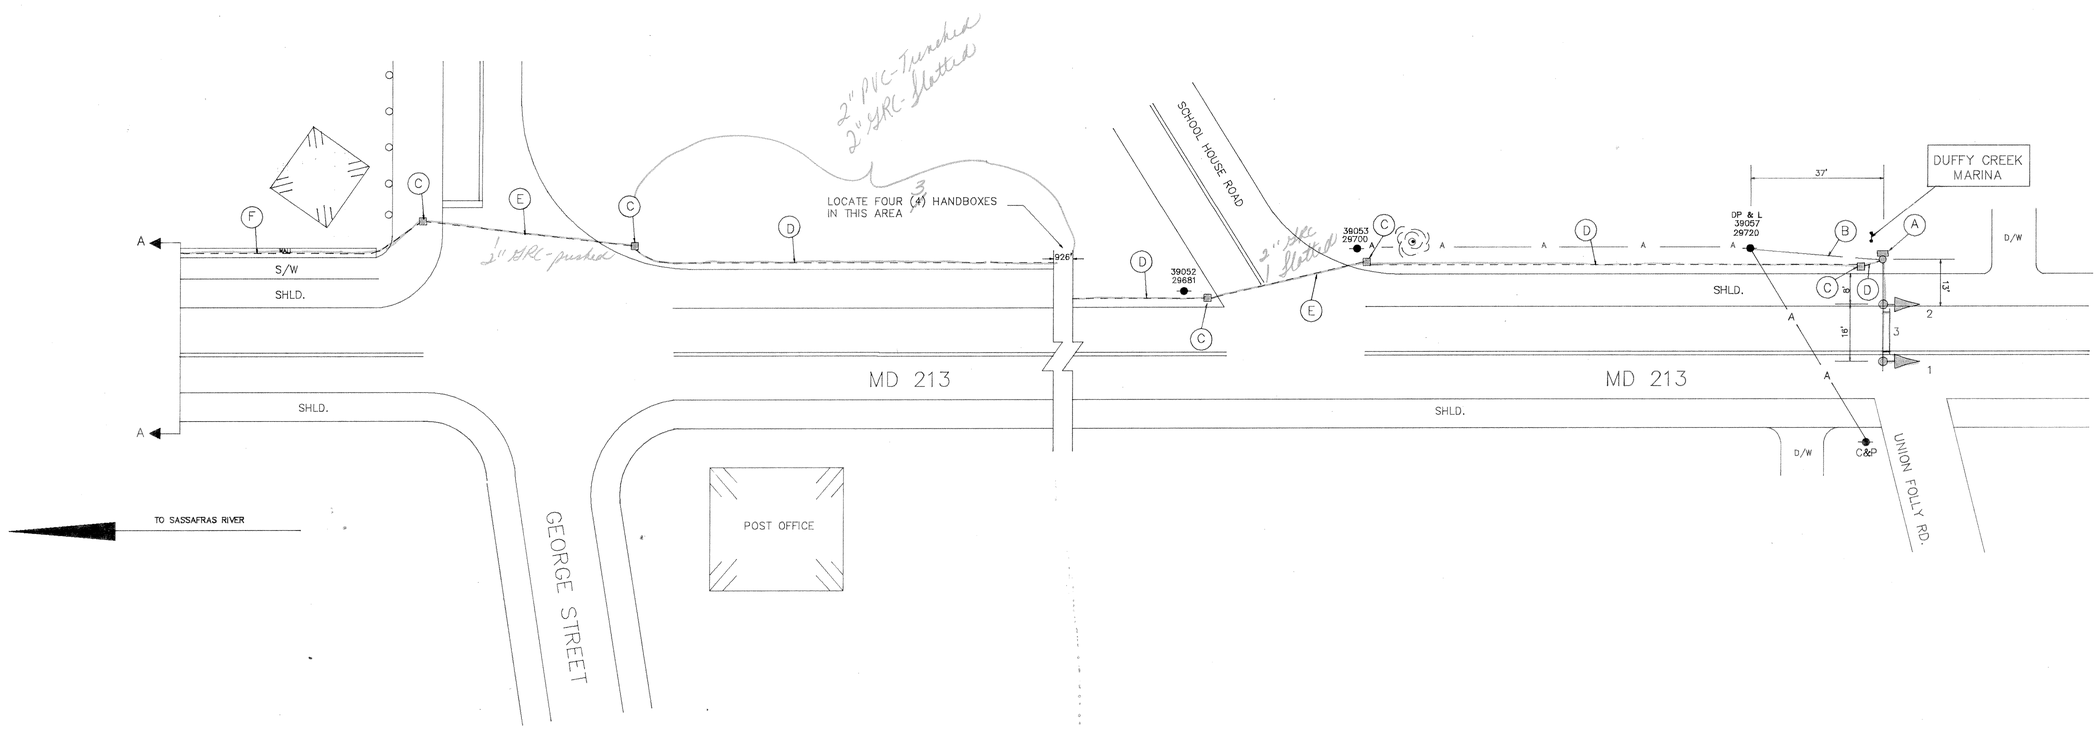

UTILITY LEGEND

—— G —— G ——	GAS MAIN
—— W —— W ——	WATER MAIN
—— S —— S ——	SEWER MAIN
—— E —— E ——	ELECTRIC CABLES
—— A —— A ——	AERIAL CABLES

REVISIONS	APPROVALS
	CHIEF, SIGNAL DESIGN SECTION
	ASST. DISTRICT ENGINEER, TRAFFIC
	CHIEF, BUREAU OF TRAFFIC ENGINEERING 1-30-87
	DEPUTY CHIEF ENGINEER, OFFICE OF TRAFFIC

MARYLAND DEPARTMENT OF TRANSPORTATION
STATE HIGHWAY ADMINISTRATION – OFFICE OF TRAFFIC
BUREAU OF TRAFFIC ENGINEERING

DRAWN BY CECELIA ALSTON/B. THOMPSON
DES. BY: CECELIA ALSTON/B. THOMPSON
CHK. BY: 11-30-87

MD 213 OVER SASSAFRAS RIVER BRIDGE
NO. 14006 SOUTHBOUND H.I.B.

COUNTY: CECIL/KENT

DATE: 10/28/87
SCALE: 1"=20'

F.A.P. NO.
S.H.A. NO. ~~355-25012002~~ ~~01-2-88~~

TS/FILE NO. 344 X1

SHEET NO. ___ OF ___

14021317.87