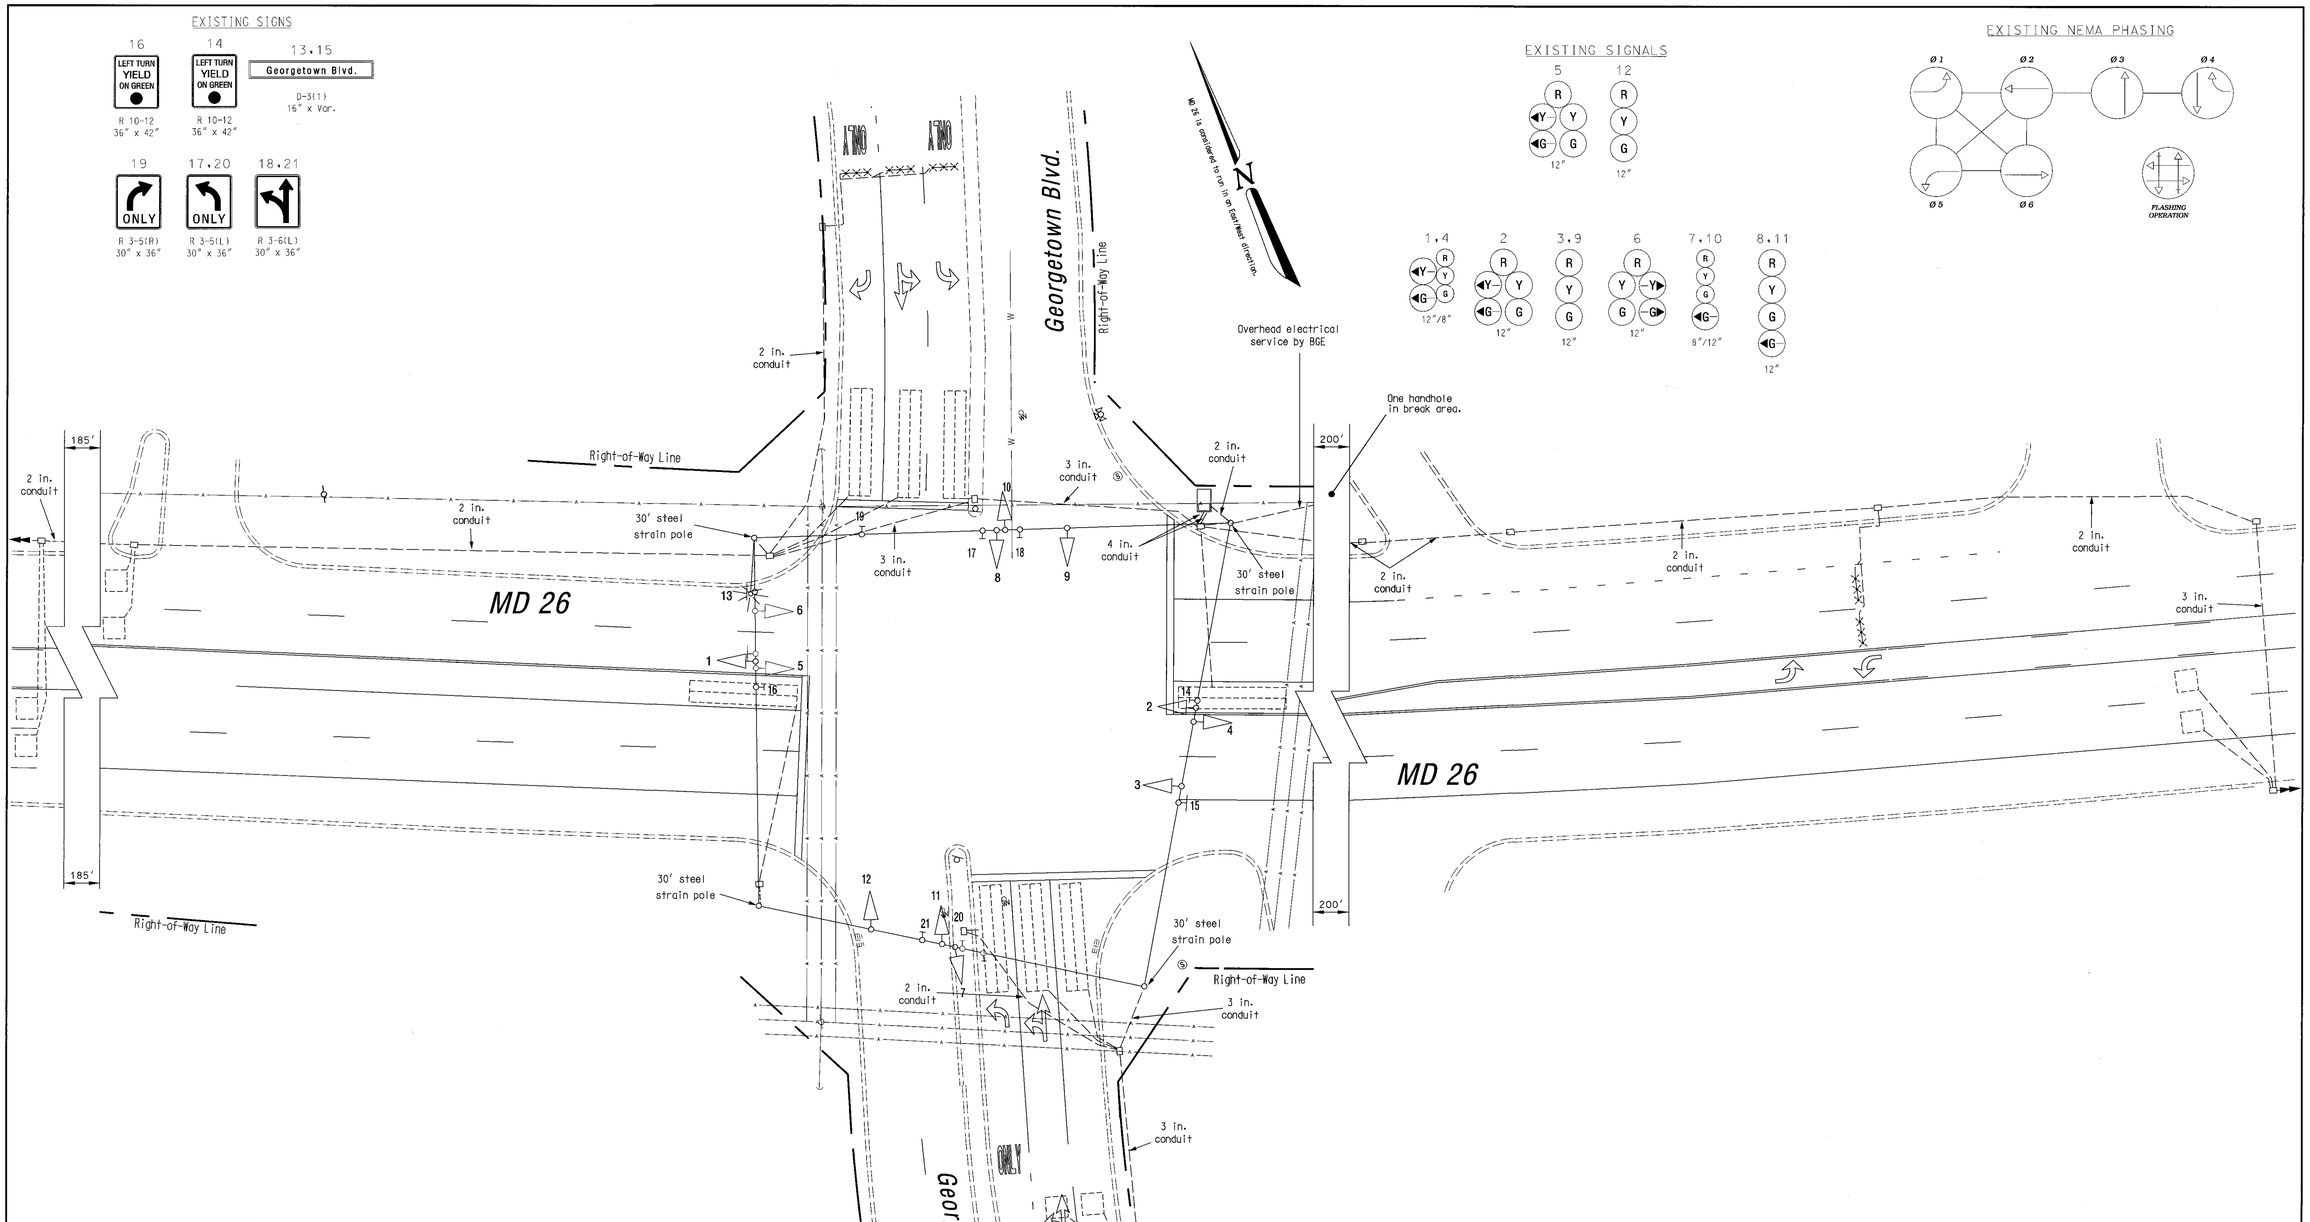

GEOMETRIC LEGEND

EXISTING GEOMETRICS

PROPOSED GEOMETRICS

UTILITY LEGEND

G	GAS MAIN
W	WATER MAIN
S	SEWER MAIN
E	ELECTRIC CABLES
D	STORM DRAIN
A	AERIAL CABLES
T	TELEPHONE CABLES

"As Built"

The Traffic Group

The Traffic Group, Inc.
410-931-6600
Fax 410-931-6601

REVISIONS

November 3, 2000
"As Built"
S.H.A. No.:BW996MB2
md

APPROVALS

ORIGINAL ON FILE

TEAM LEADER, TRAFFIC ENGINEERING DESIGN DIVISION

ASST. CHIEF TRAFFIC ENGINEERING DESIGN DIVISION

CHIEF, TRAFFIC ENGINEERING DESIGN DIVISION

DIRECTOR, TRAFFIC & SAFETY

MARYLAND DOT - STATE HIGHWAY ADMINISTRATION

Office of Traffic & Safety

TRAFFIC ENGINEERING DESIGN DIVISION

(Traffic Signal Plan)

MD 26 at Georgetown Blvd.

DRAWN BY: J. Boling	F.A.P. NO. N/A	TS NO. 1722D	SHEET NO.
CHECKED BY: J. Boling	S.H.A. NO. BW 452-801-712		
SCALE: 1" = 20'	COUNTY: Carroll	T.I.M.S. NO. E-075	1 OF 1
DATE:	LOG MILE:		

I:\1997\97170A\des\asbuilt3.dgn 04 JAN 2002