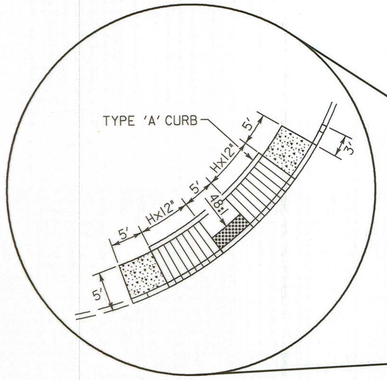

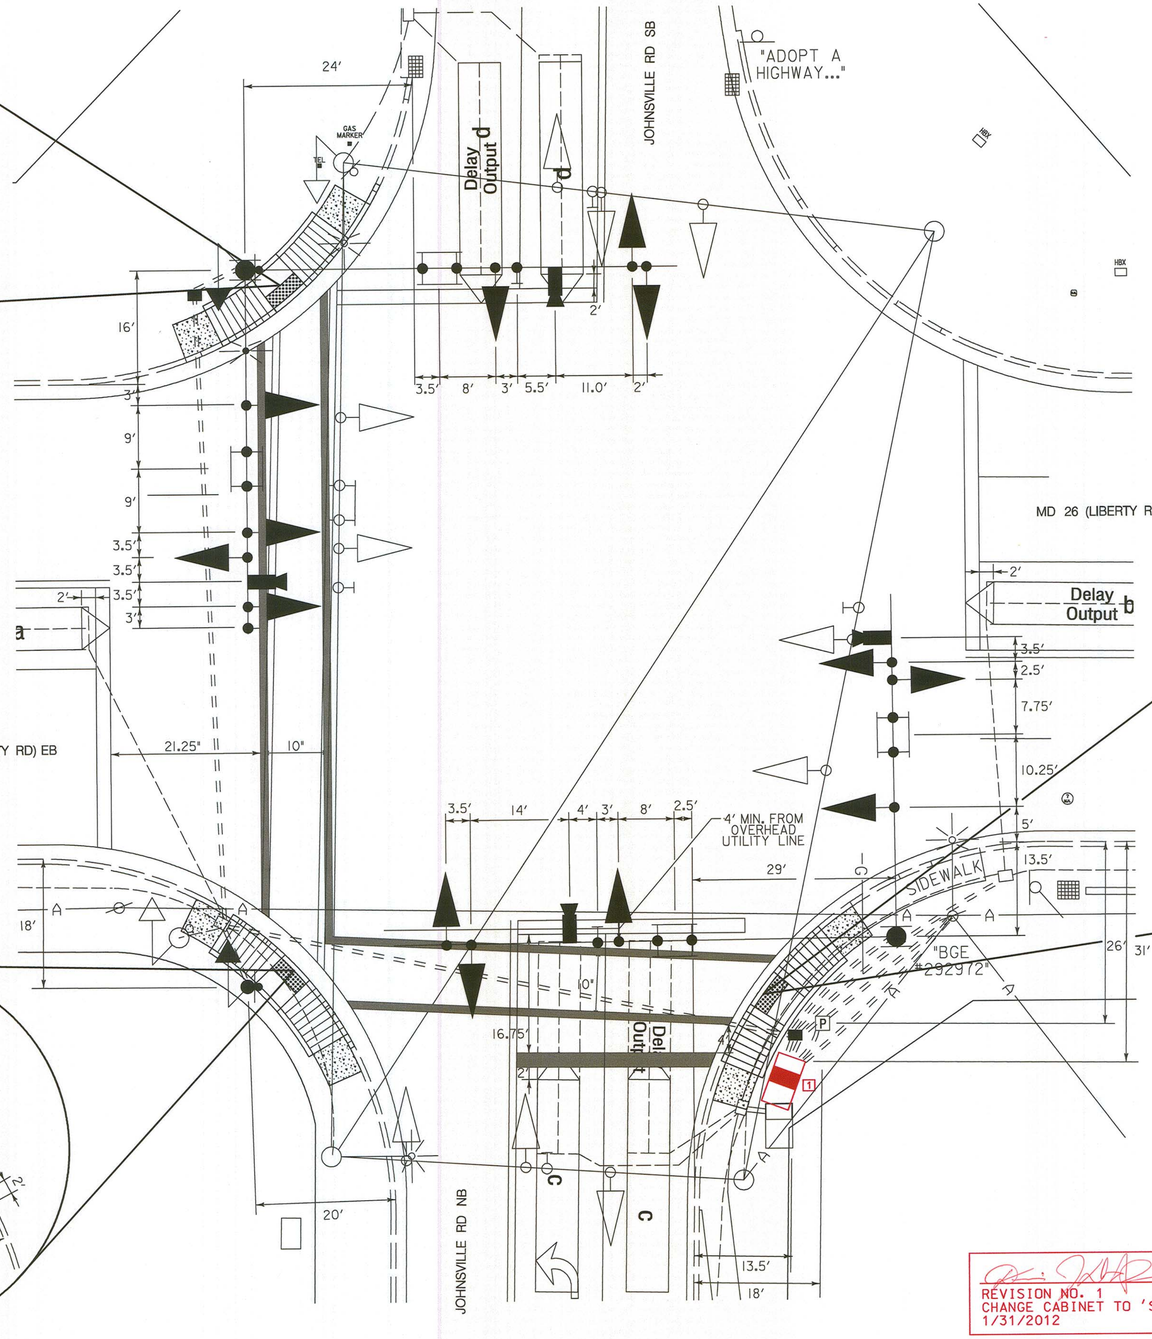

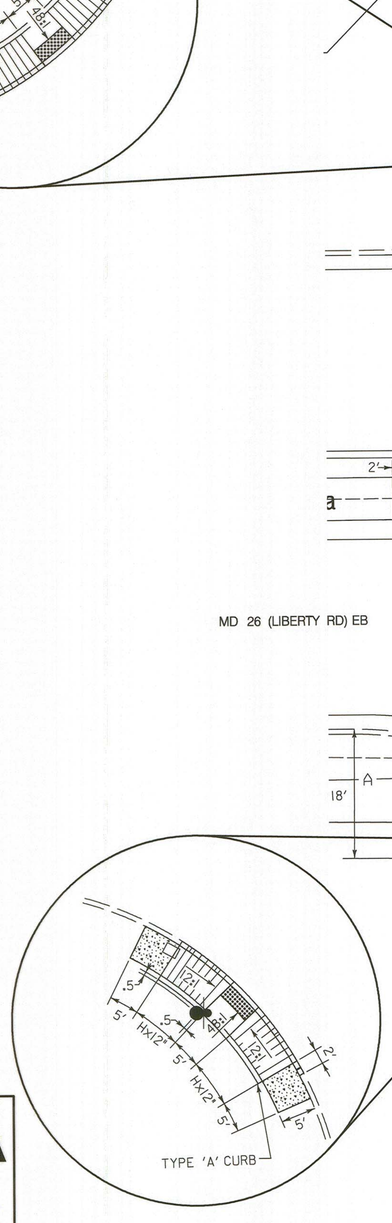

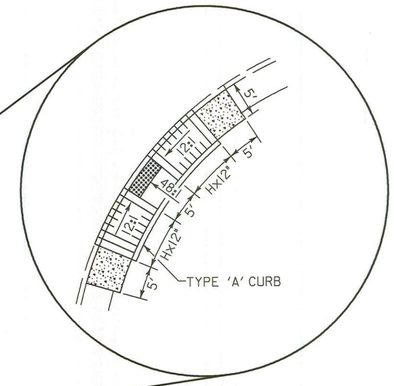

NOTE: H = HEIGHT OF CURB

REVISION NO. 1
CHANGE CABINET TO 'S' SIZE
1/31/2012

WHITMAN, REQUARDT & ASSOCIATES, LLP
801 South Caroline Street, Baltimore, Maryland 21231

STATE OF MARYLAND
DEPARTMENT OF TRANSPORTATION
STATE HIGHWAY ADMINISTRATION
OFFICE OF TRAFFIC & SAFETY
TRAFFIC ENGINEERING DESIGN DIVISION

MD 26 (Liberty Road) & Johnsville Road
Eldersburg, MD

GENERAL INFORMATION SHEET

SCALE 1" = 10' ADVERTISED DATE 04/26/2011 CONTRACT NO. XX6505185

DESIGNED BY L.WAESCHE
DRAWN BY L.WAESCHE
CHECKED BY N.LEARY
F.A.P. NO.

COUNTY Carroll
LOGMILE 06002609.48
TIMS NO. K643
TOD NO.

TS NO. 2036 | DRAWING TSP-2 OF 3 | SHEET NO. 2 OF 3

PLOTTED: Tuesday, January 31, 2012 AT 08:13 AM
FILE: N:\31869-119\CADD\Redline 1\RL1_pSG-P002_Johnsville.dgn

BY: lwaesche