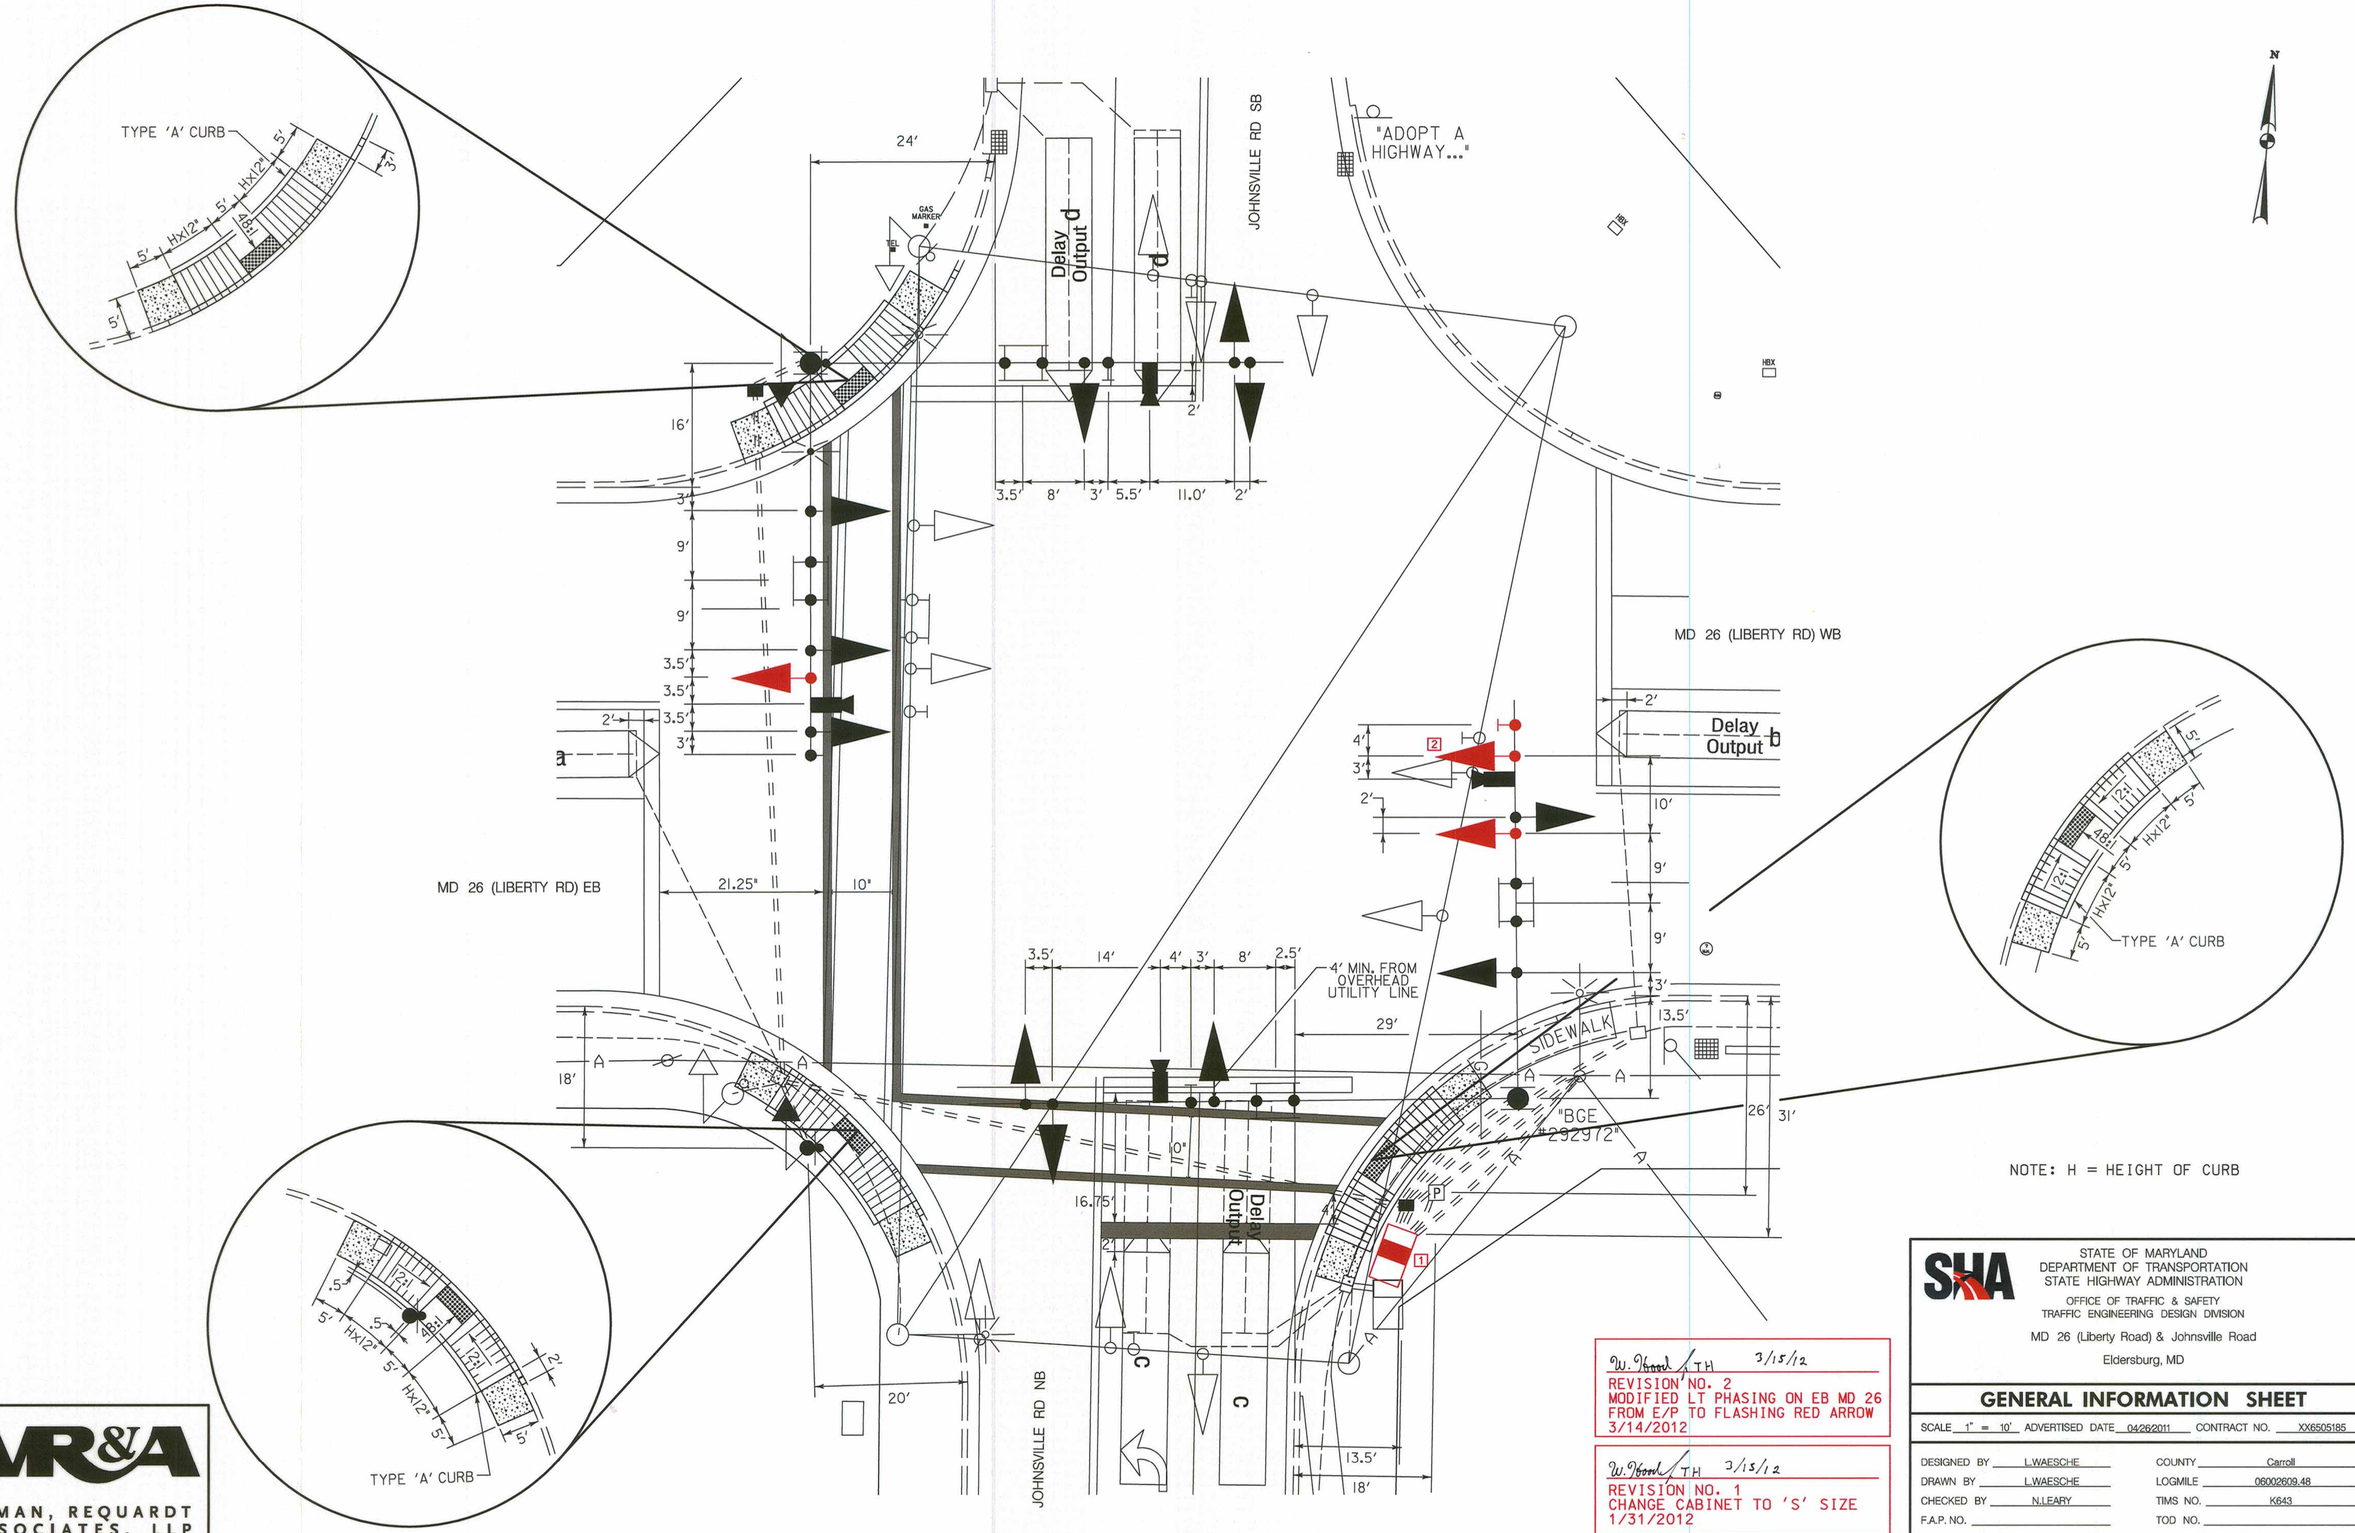

NOTE: H = HEIGHT OF CURB

W. Wood / TH 3/15/12
REVISION NO. 2
MODIFIED LT PHASING ON EB MD 26 FROM E/P TO FLASHING RED ARROW
3/14/2012

W. Wood / TH 3/15/12
REVISION NO. 1
CHANGE CABINET TO 'S' SIZE
1/31/2012

STATE OF MARYLAND
DEPARTMENT OF TRANSPORTATION
STATE HIGHWAY ADMINISTRATION

OFFICE OF TRAFFIC & SAFETY
TRAFFIC ENGINEERING DESIGN DIVISION

MD 26 (Liberty Road) & Johnsville Road

Eldersburg, MD

GENERAL INFORMATION SHEET

SCALE 1" = 10' ADVERTISED DATE 04/26/2011 CONTRACT NO. XX6505185

DESIGNED BY	L.WAESCHE	COUNTY	Carroll
DRAWN BY	L.WAESCHE	LOGMILE	06002609.48
CHECKED BY	N.LEARY	TIMS NO.	K643
F.A.P. NO.		TOD NO.	

TS NO. 2036	DRAWING TSP-2 OF 3	SHEET NO. 2 OF 3

WHITMAN, REQUARDT & ASSOCIATES, LLP
801 South Caroline Street, Baltimore, Maryland 21231

BY: sbloss

PLOTTED: March 14, 2012
FILE: N:\31669-119\CADD\Redline 2\pSG-P002_Johnsville-RL2.dgn