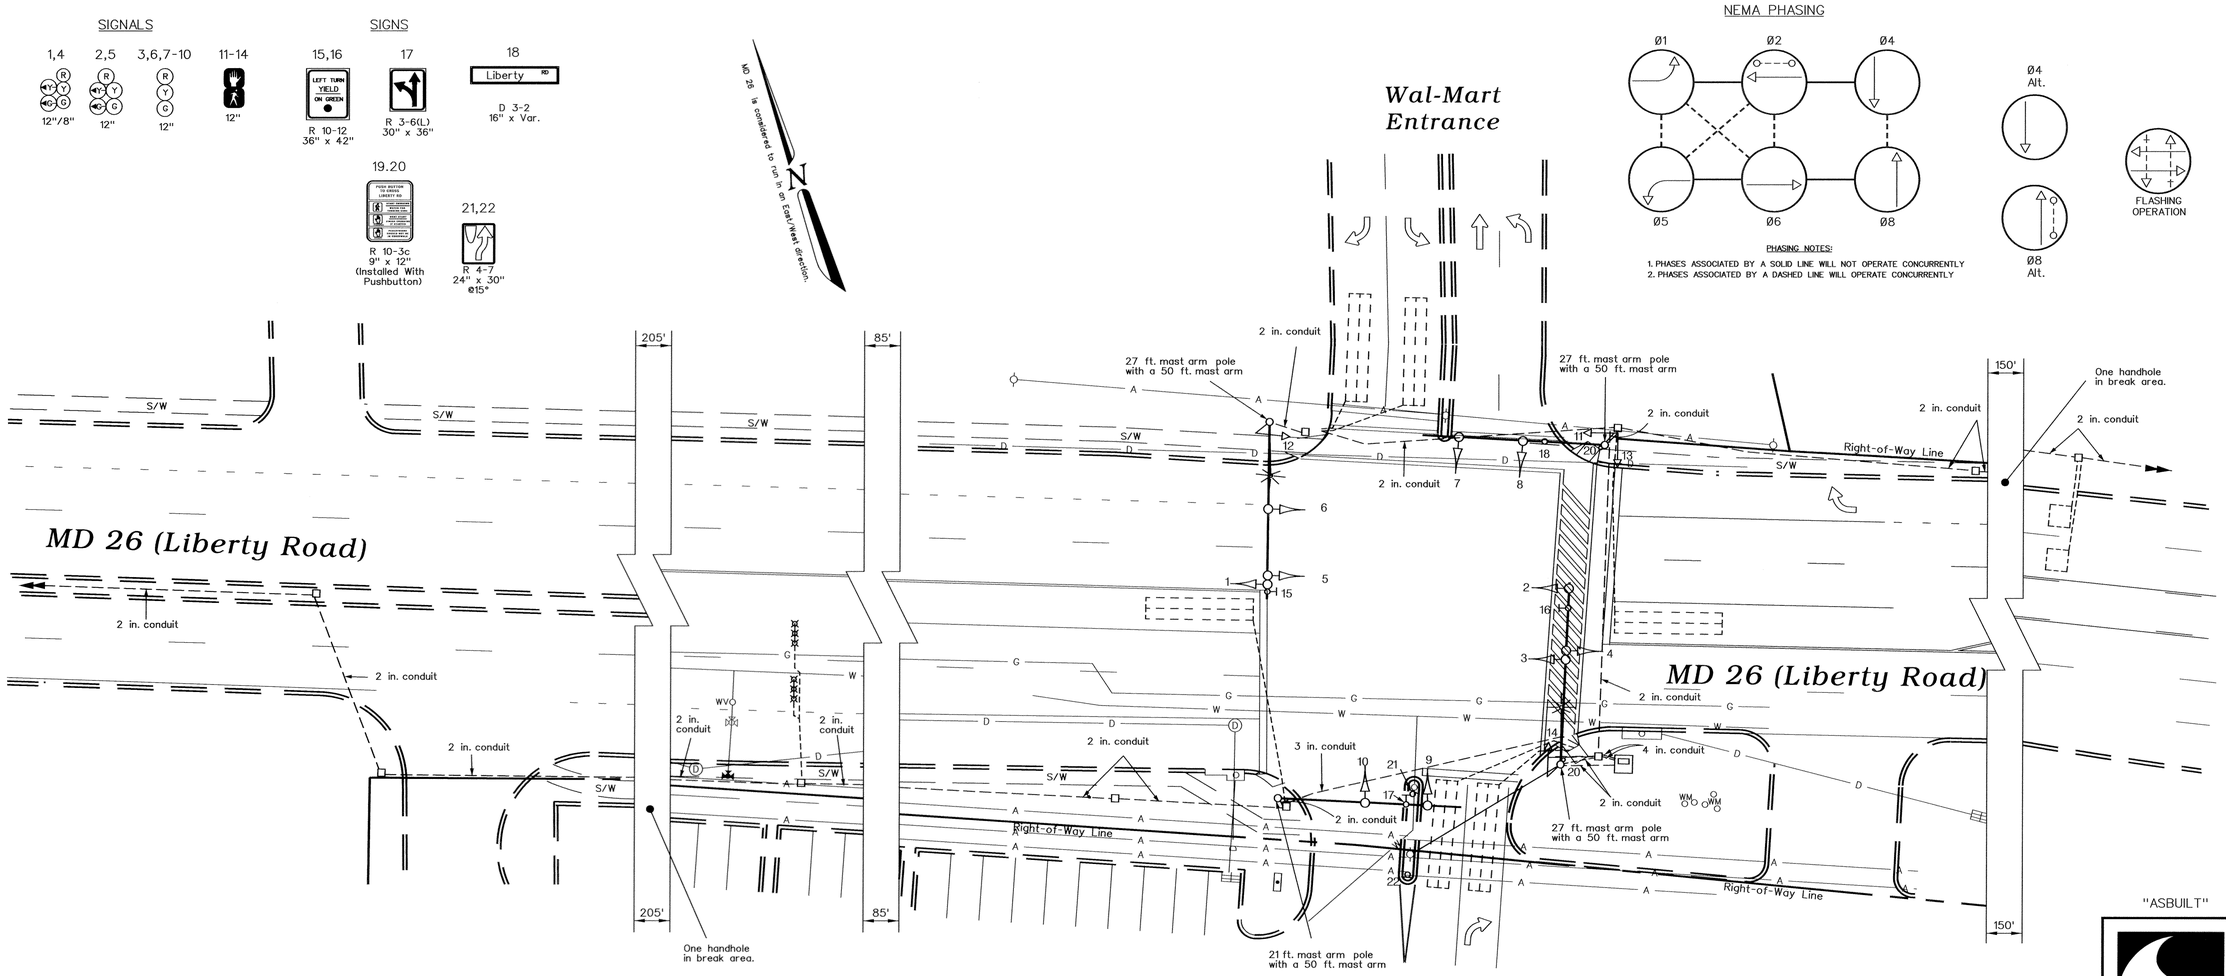

"ASBUILT"

The Traffic Group

The Traffic Group, Inc.
Suite 600
40 W. Chesapeake Avenue
Towson, Maryland 21204
410-583-8405
1-800-583-8411
Fax 410-321-8458
Job No.980311
ASBUILT.DGN

GEOMETRIC LEGEND

EXISTING GEOMETRICS
PROPOSED GEOMETRICS

UTILITY LEGEND

G	G	GAS MAIN
W	W	WATER MAIN
S	S	SEWER MAIN
E	E	ELECTRIC CABLES
D	D	STORM DRAIN
A	A	AERIAL CABLES
T	T	TELEPHONE CABLES

REVISIONS

© ASBUILT August 20, 1999
S.H.A. No.: BW996M82
FHI

APPROVALS

ORIGINAL ON FILE

ASST. TRAFFIC ENGINEERING DESIGN DIVISION
ASST. DISTRICT ENGINEER - TRAFFIC
CHIEF, TRAFFIC ENGINEERING DESIGN DIVISION
DIRECTOR, OFFICE OF TRAFFIC & SAFETY

MDOT – STATE HIGHWAY ADMINISTRATION
Office of Traffic & Safety
TRAFFIC ENGINEERING DESIGN DIVISION
(Traffic Signal Plan)

MD 26 at Wal-Mart/ Eldersburg Square Entrances

DATE: January 12, 1996
LOG MILE • 0600261.24

DRAWN BY:	R.V.B.	F.A.P. NO.	N/A	PLAN SHEET NO.:	SHEET NO.
CHK. BY:	M.T.R.	S.H.A. NO.	BW 831-802-712	3562C	1 of 1
SCALE:	1" = 20'	COUNTY:	Carroll		

E:\980311\wa*asbuilt.dgn 24 AUG 1998