F.H.W.A. REGION NO.	STATE	FED. AID PROJ. NO.	SHEET NO.	TOTAL SHEETS
3	MD.		7	16

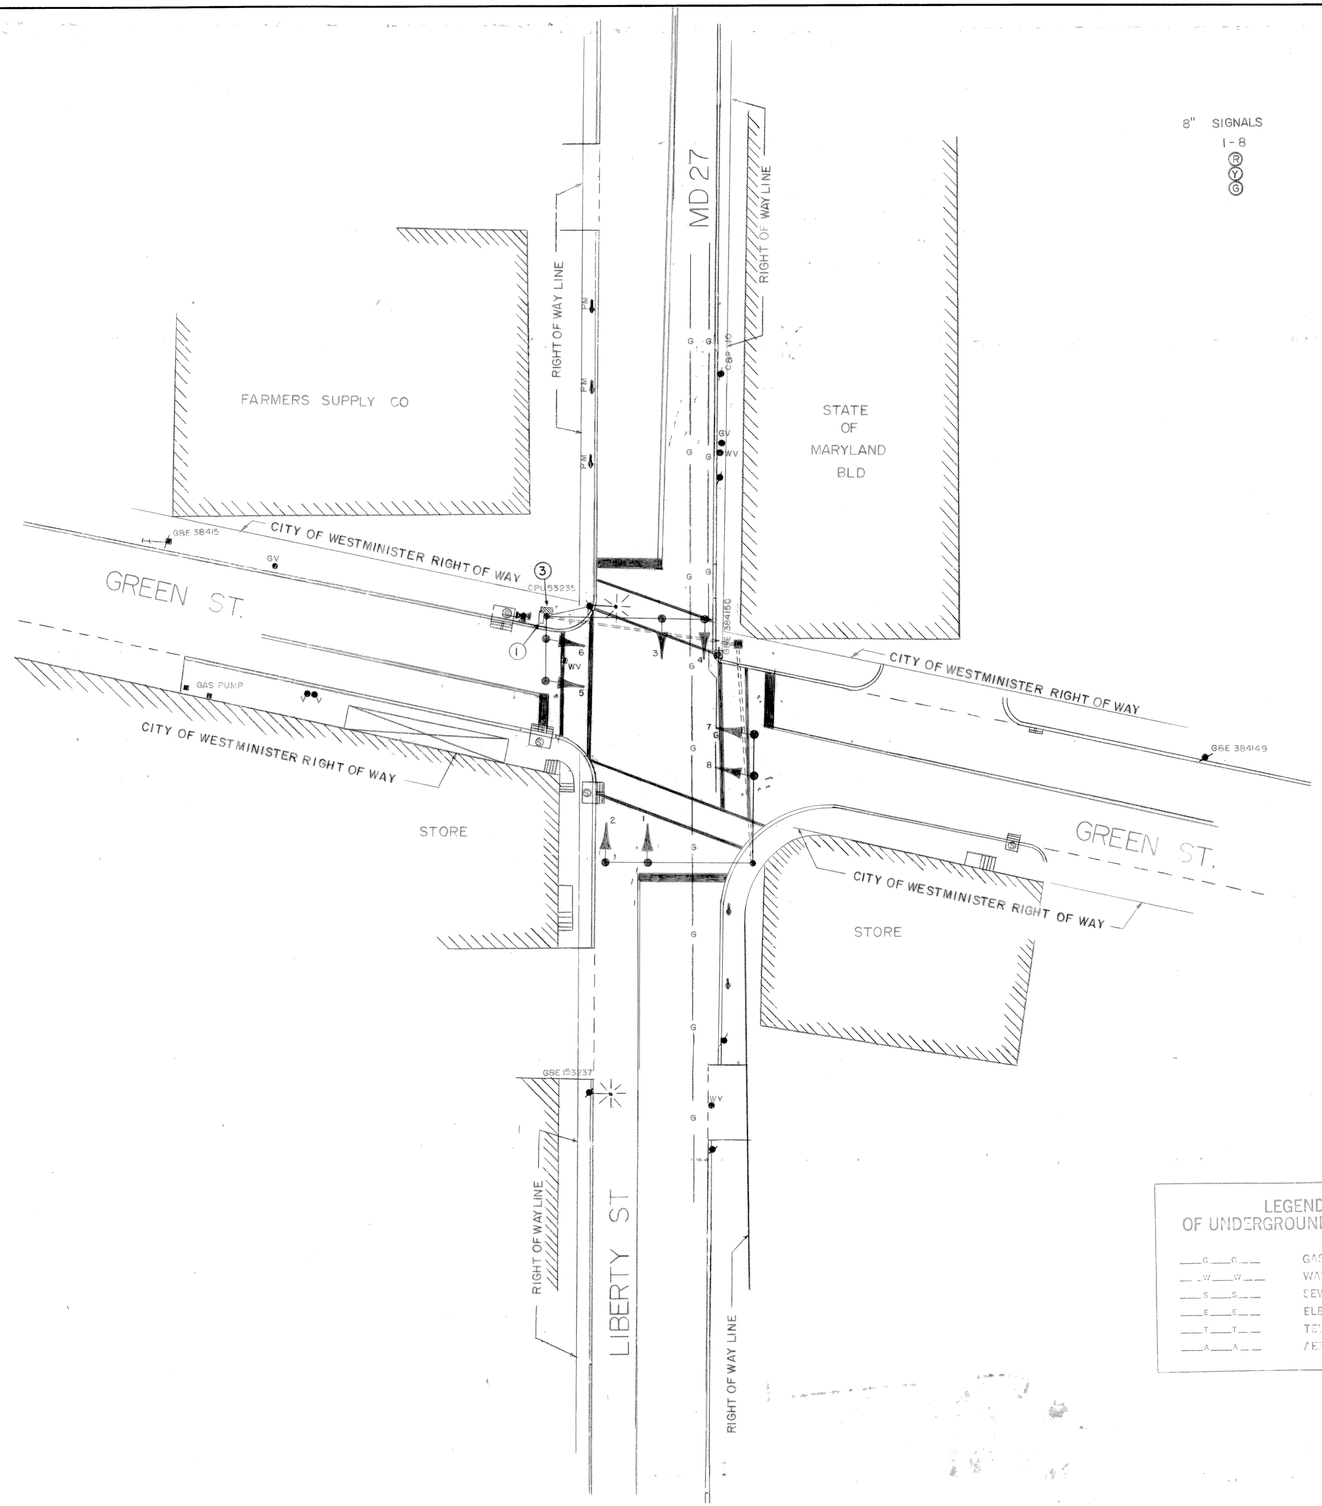

8" SIGNALS
1-8
R
Y
G

PHASE 1

PHASE 2

FLASHING OPERATION

APPROVAL: REGIONAL TRAFFIC ENGINEER

APPROVAL: CHIEF-BUREAU OF TRAFFIC ENGINEERING

APPROVAL: ASS'T. CHIEF ENGINEER TRAFFIC

B 11-6-81 REPLACE EXISTING I/C WITH TIME BASE COORDINATION

A AUG. 11, 1981 AS BUILT

REVISIONS

STATE OF MARYLAND
DEPARTMENT OF TRANSPORTATION
STATE HIGHWAY ADMINISTRATION

TRAFFIC DIVISION – BUREAU OF TRAFFIC ENGINEERING

MD27 (LIBERTY ST) & GREEN ST.

SCALE 1" = 20' DATE 9-20-72 CONTRACT NO. AW-629-503-785

DRAWN BY: JOHN BOLING COUNTY: CARROLL

DESIGNED BY: William S. Nicholson SIGNAL NO.: 06010

CHECKED BY:

DRAWING NO. TS-1116 B

BRUNING 44.511 19927