F.H.W.A. REGION NO.	STATE	FED. AID PROJ. NO.	SHEET NO.	TOTAL SHEETS
3	MD.		4	7

NOTE

(1) CONSTRUCTION LEADERS FOR REVISION F ARE SHOWN AS NUMBERS

12" SIGNALS

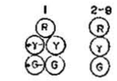

YIELD
WHEN TURNING
ON GREEN

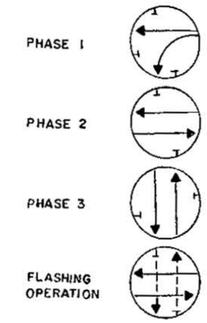

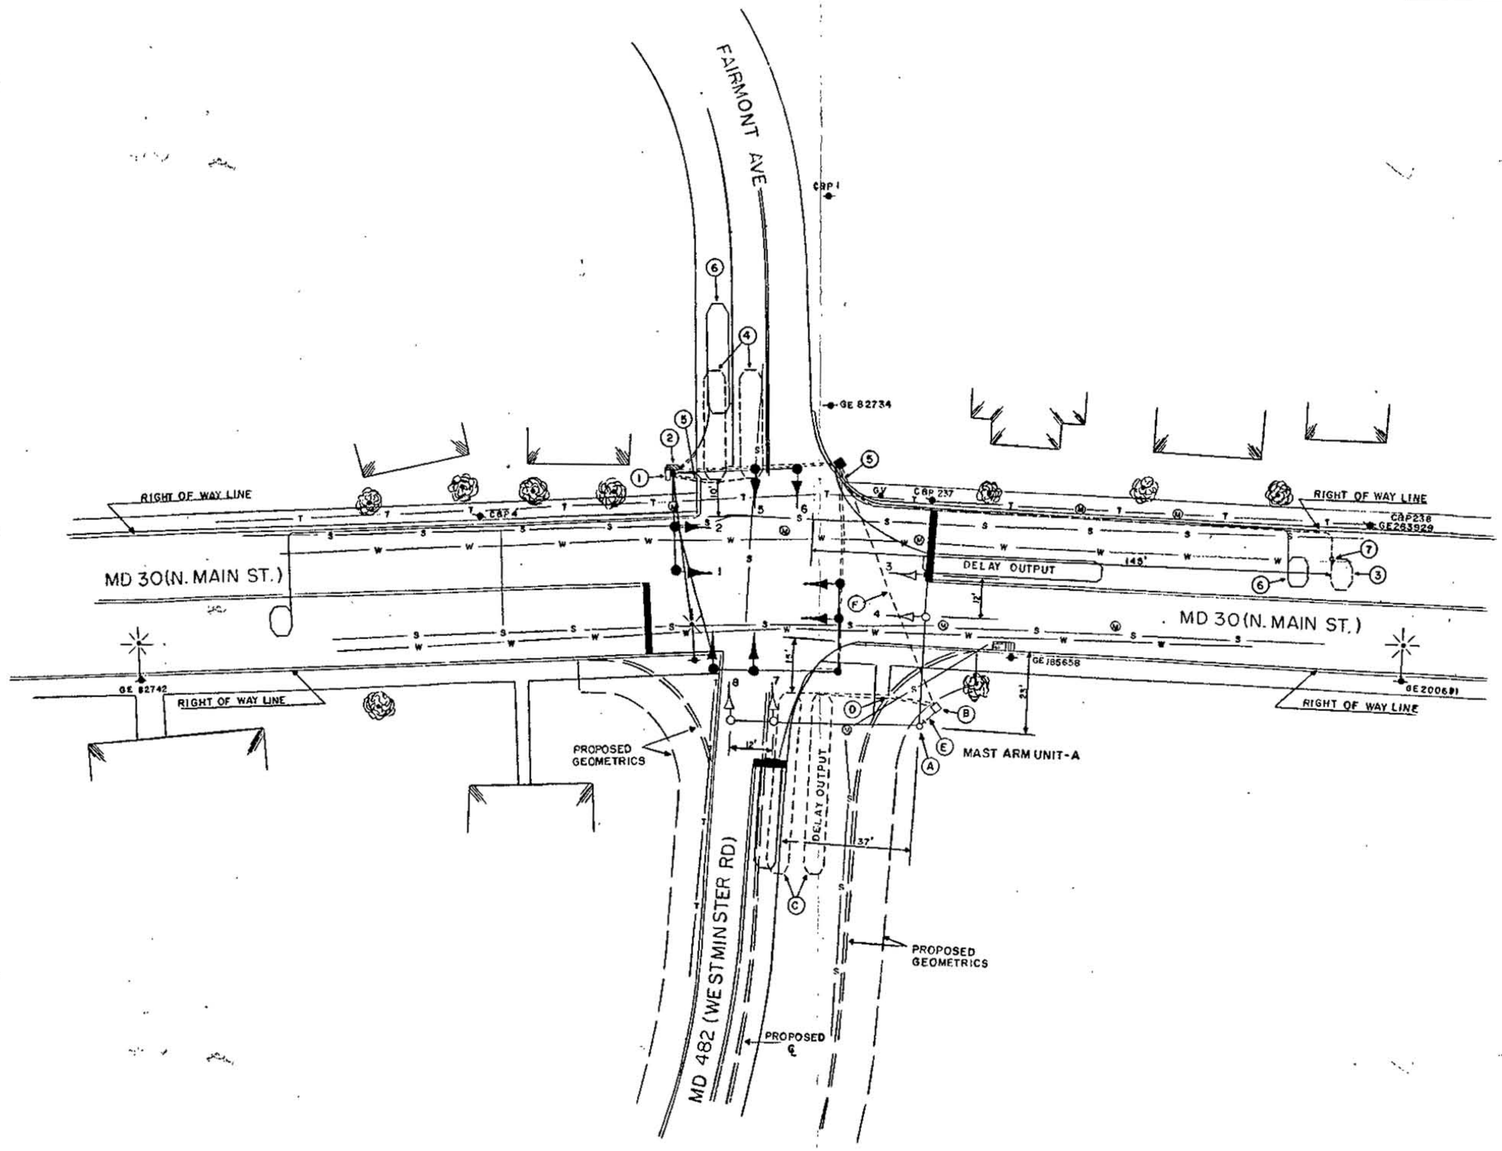

APPROVAL: CHIEF SIGNAL DESIGN SECTION	
APPROVAL: REGIONAL TRAFFIC ENGINEER	
APPROVAL: CHIEF-BUREAU OF TRAFFIC ENGINEERING	(F) 4-1-82 ADDED NEW CONTROLLER, TIME BASE COORDINATION AND POLE MOUNTED CAB. JG
APPROVAL: ASS'T. CHIEF ENGINEER TRAFFIC	(E) 1-7-82 REDRAWN TO INCLUDE PROP. GEOM. & RELOC. SIG. EQUIP. SHA NO. CL-477-201-771 EMM
	REVISIONS

STATE OF MARYLAND
DEPARTMENT OF TRANSPORTATION
STATE HIGHWAY ADMINISTRATION

TRAFFIC DIVISION – BUREAU OF TRAFFIC ENGINEERING

MD 30 AT MD 482 & FAIRMONT AVE.

SCALE 1" = 20' DATE 1-7-82 CONTRACT NO. AW-629-505-785

DRAWN BY: EMMILESKY COUNTY: CARROLL

DESIGNED BY: J.H. 7/16/82 SIGNAL NO.: 06016

CHECKED BY:

DRAWING NO. TS-1020F

06003002.69