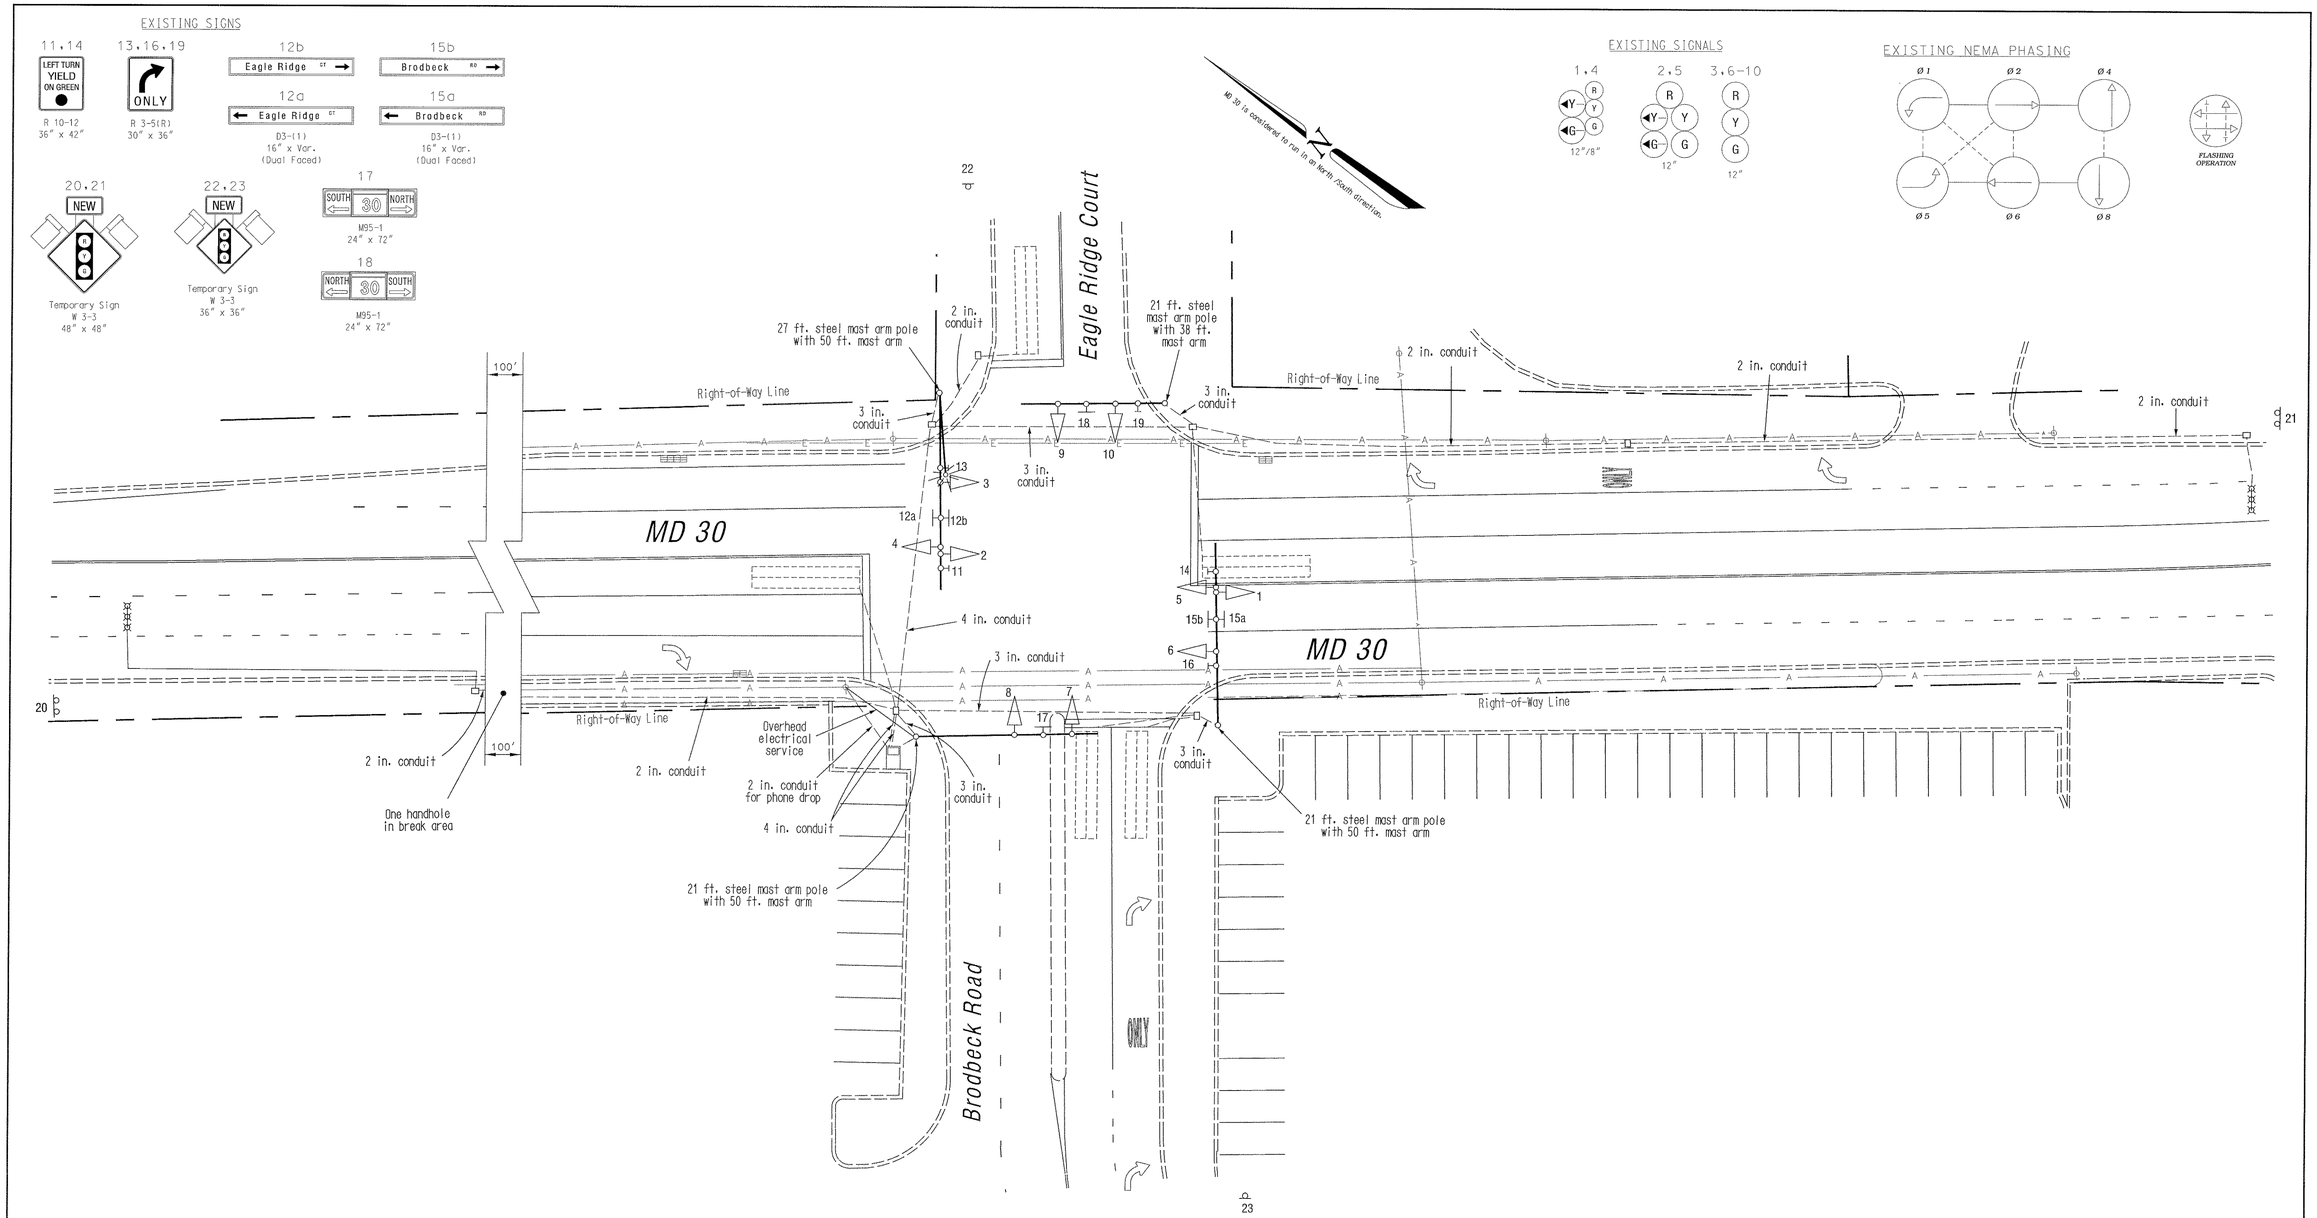

GEOMETRIC LEGEND

EXISTING GEOMETRICS

PROPOSED GEOMETRICS

UTILITY LEGEND

G	GAS MAIN
W	WATER MAIN
S	SEWER MAIN
E	ELECTRIC CABLES
D	STORM DRAIN
A	AERIAL CABLES
T	TELEPHONE CABLES

"ASBUILT"

The Traffic Group

The Traffic Group, Inc.
410-931-6600
Fax 410-931-6601

REVISIONS

September 25, 2000

AS-BUILT
S.H.A. No.:BW996M82

FJH

APPROVALS

TEAM LEADER, TRAFFIC ENGINEERING DESIGN DIVISION

ASST. CHIEF TRAFFIC ENGINEERING DESIGN DIVISION

CHIEF, TRAFFIC ENGINEERING DESIGN DIVISION

DIRECTOR, TRAFFIC & SAFETY

ORIGINAL ON FILE

MARYLAND DOT - STATE HIGHWAY ADMINISTRATION

Office of Traffic & Safety

TRAFFIC ENGINEERING DESIGN DIVISION

(Traffic Signal Plan)

MD 30 at Eagle Ridge Ct./Brodbeck Road

DRAWN BY:	Frank Hoeckel	F.A.P. NO.	N/A	TS NO.	3989
CHECKED BY:		S.H.A. NO.			
SCALE:	1" = 20'	COUNTY:	Carroll	T.I.M.S. NO.	D720
DATE:	March 28, 2000	LOG MILE:	06003004.53		

SHEET NO. 1 OF 1

f:\1998\980710\des\asbuilt.dgn 02 OCT 2000