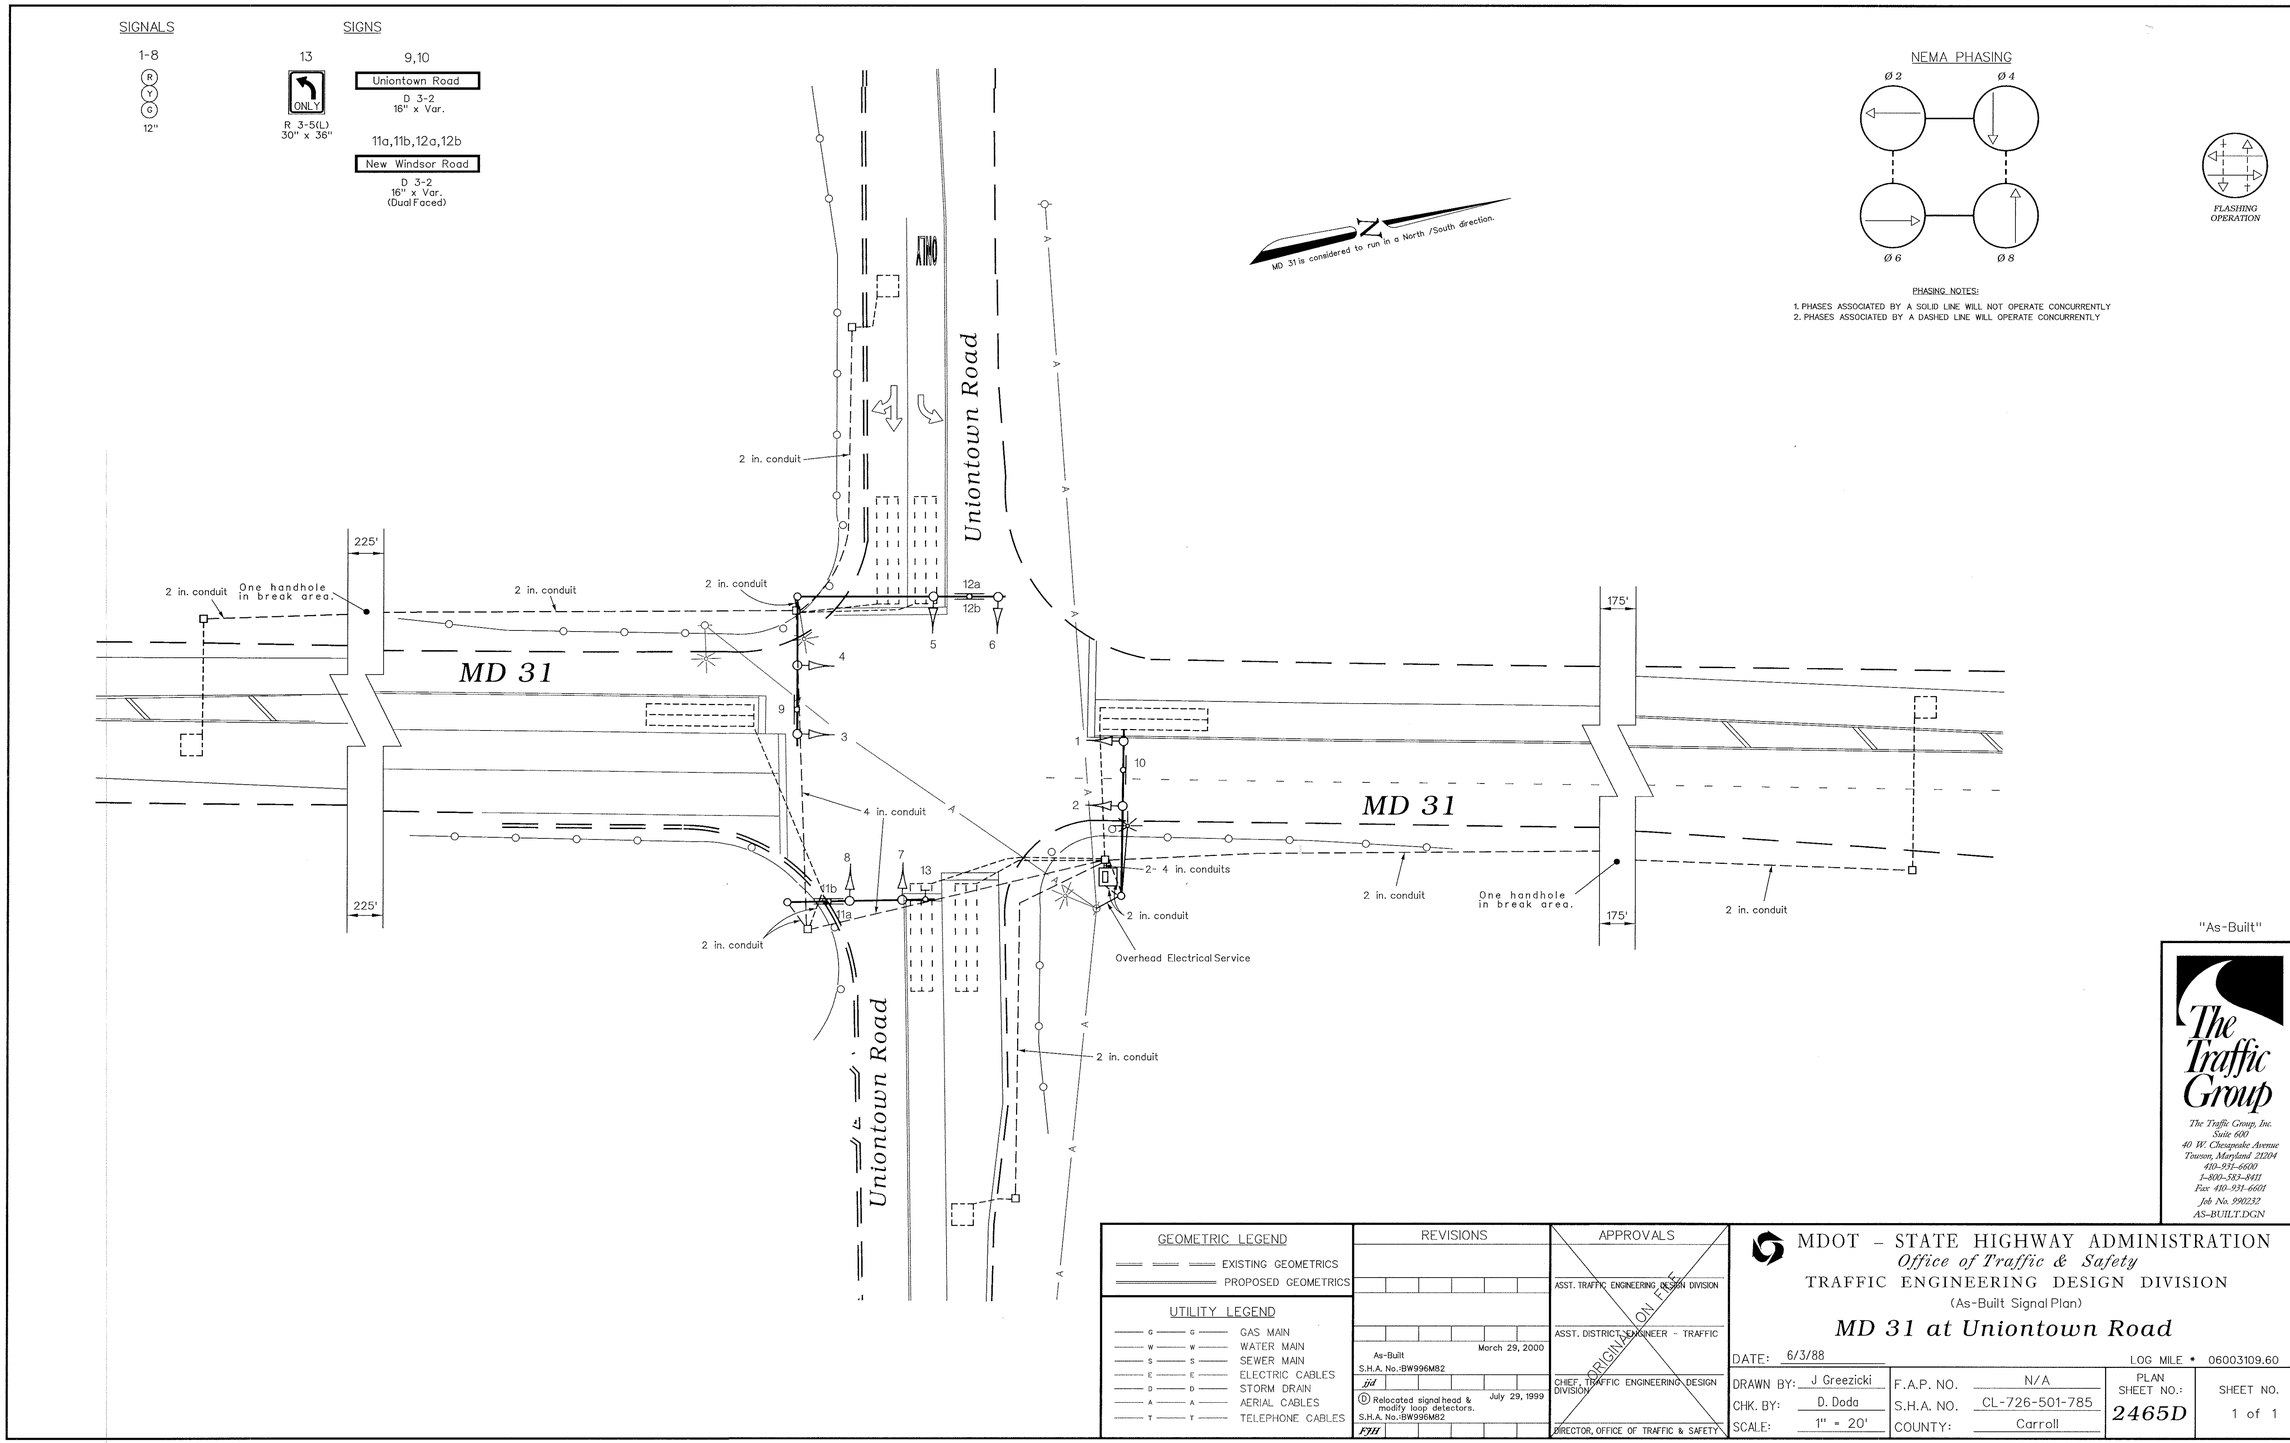
SIGNALS
1-8
R
Y
G
12"
13
ONLY
R 3-5(L)
30" x 36"
SIGNS
9,10
Uniontown Road
D 3-2
16" x Var.
11a,11b,12a,12b
New Windsor Road
D 3-2
16" x Var.
(Dual Faced)
NEMA PHASING
Ø 2
Ø 4
Ø 6
Ø 8
FLASHING OPERATION
PHASING NOTES:
1. PHASES ASSOCIATED BY A SOLID LINE WILL NOT OPERATE CONCURRENTLY
2. PHASES ASSOCIATED BY A DASHED LINE WILL OPERATE CONCURRENTLY
MD 31 is considered to run in a North /South direction.
Uniontown Road
MD 31
225'
175'
2 in. conduit
One handhole in break area.
4 in. conduit
2- 4 in. conduits
Overhead Electrical Service
"As-Built"
The Traffic Group
The Traffic Group, Inc.
Suite 600
40 W. Chesapeake Avenue
Towson, Maryland 21204
410-931-6600
1-800-583-8411
Fax 410-931-6601
Job No. 990232
AS-BUILT.DGN
GEOMETRIC LEGEND
EXISTING GEOMETRICS
PROPOSED GEOMETRICS
UTILITY LEGEND
GAS MAIN
WATER MAIN
SEWER MAIN
ELECTRIC CABLES
STORM DRAIN
AERIAL CABLES
TELEPHONE CABLES
REVISIONS
As-Built
March 29, 2000
S.H.A. No.:BW996M82
jjd
Relocated signal head & modify loop detectors.
July 29, 1999
S.H.A. No.:BW996M82
FJH
APPROVALS
ASST. TRAFFIC ENGINEERING DESIGN DIVISION
ASST. DISTRICT ENGINEER - TRAFFIC
CHIEF, TRAFFIC ENGINEERING DESIGN DIVISION
DIRECTOR, OFFICE OF TRAFFIC & SAFETY
ORIGINAL ON FILE
MDOT - STATE HIGHWAY ADMINISTRATION
Office of Traffic & Safety
TRAFFIC ENGINEERING DESIGN DIVISION
(As-Built Signal Plan)
MD 31 at Uniontown Road
DATE: 6/3/88
LOG MILE • 06003109.60
DRAWN BY: J Greezicki
CHK. BY: D. Doda
SCALE: 1" = 20'
F.A.P. NO. N/A
S.H.A. NO. CL-726-501-785
COUNTY: Carroll
PLAN SHEET NO.: 2465D
SHEET NO. 1 of 1