K&E 19 1153 6-81 MC 2647•

F.H.W.A. REGION NO.	STATE	FED. AID PROJ. NO.	SHEET NO.	TOTAL SHEETS
3	MD.		3	16

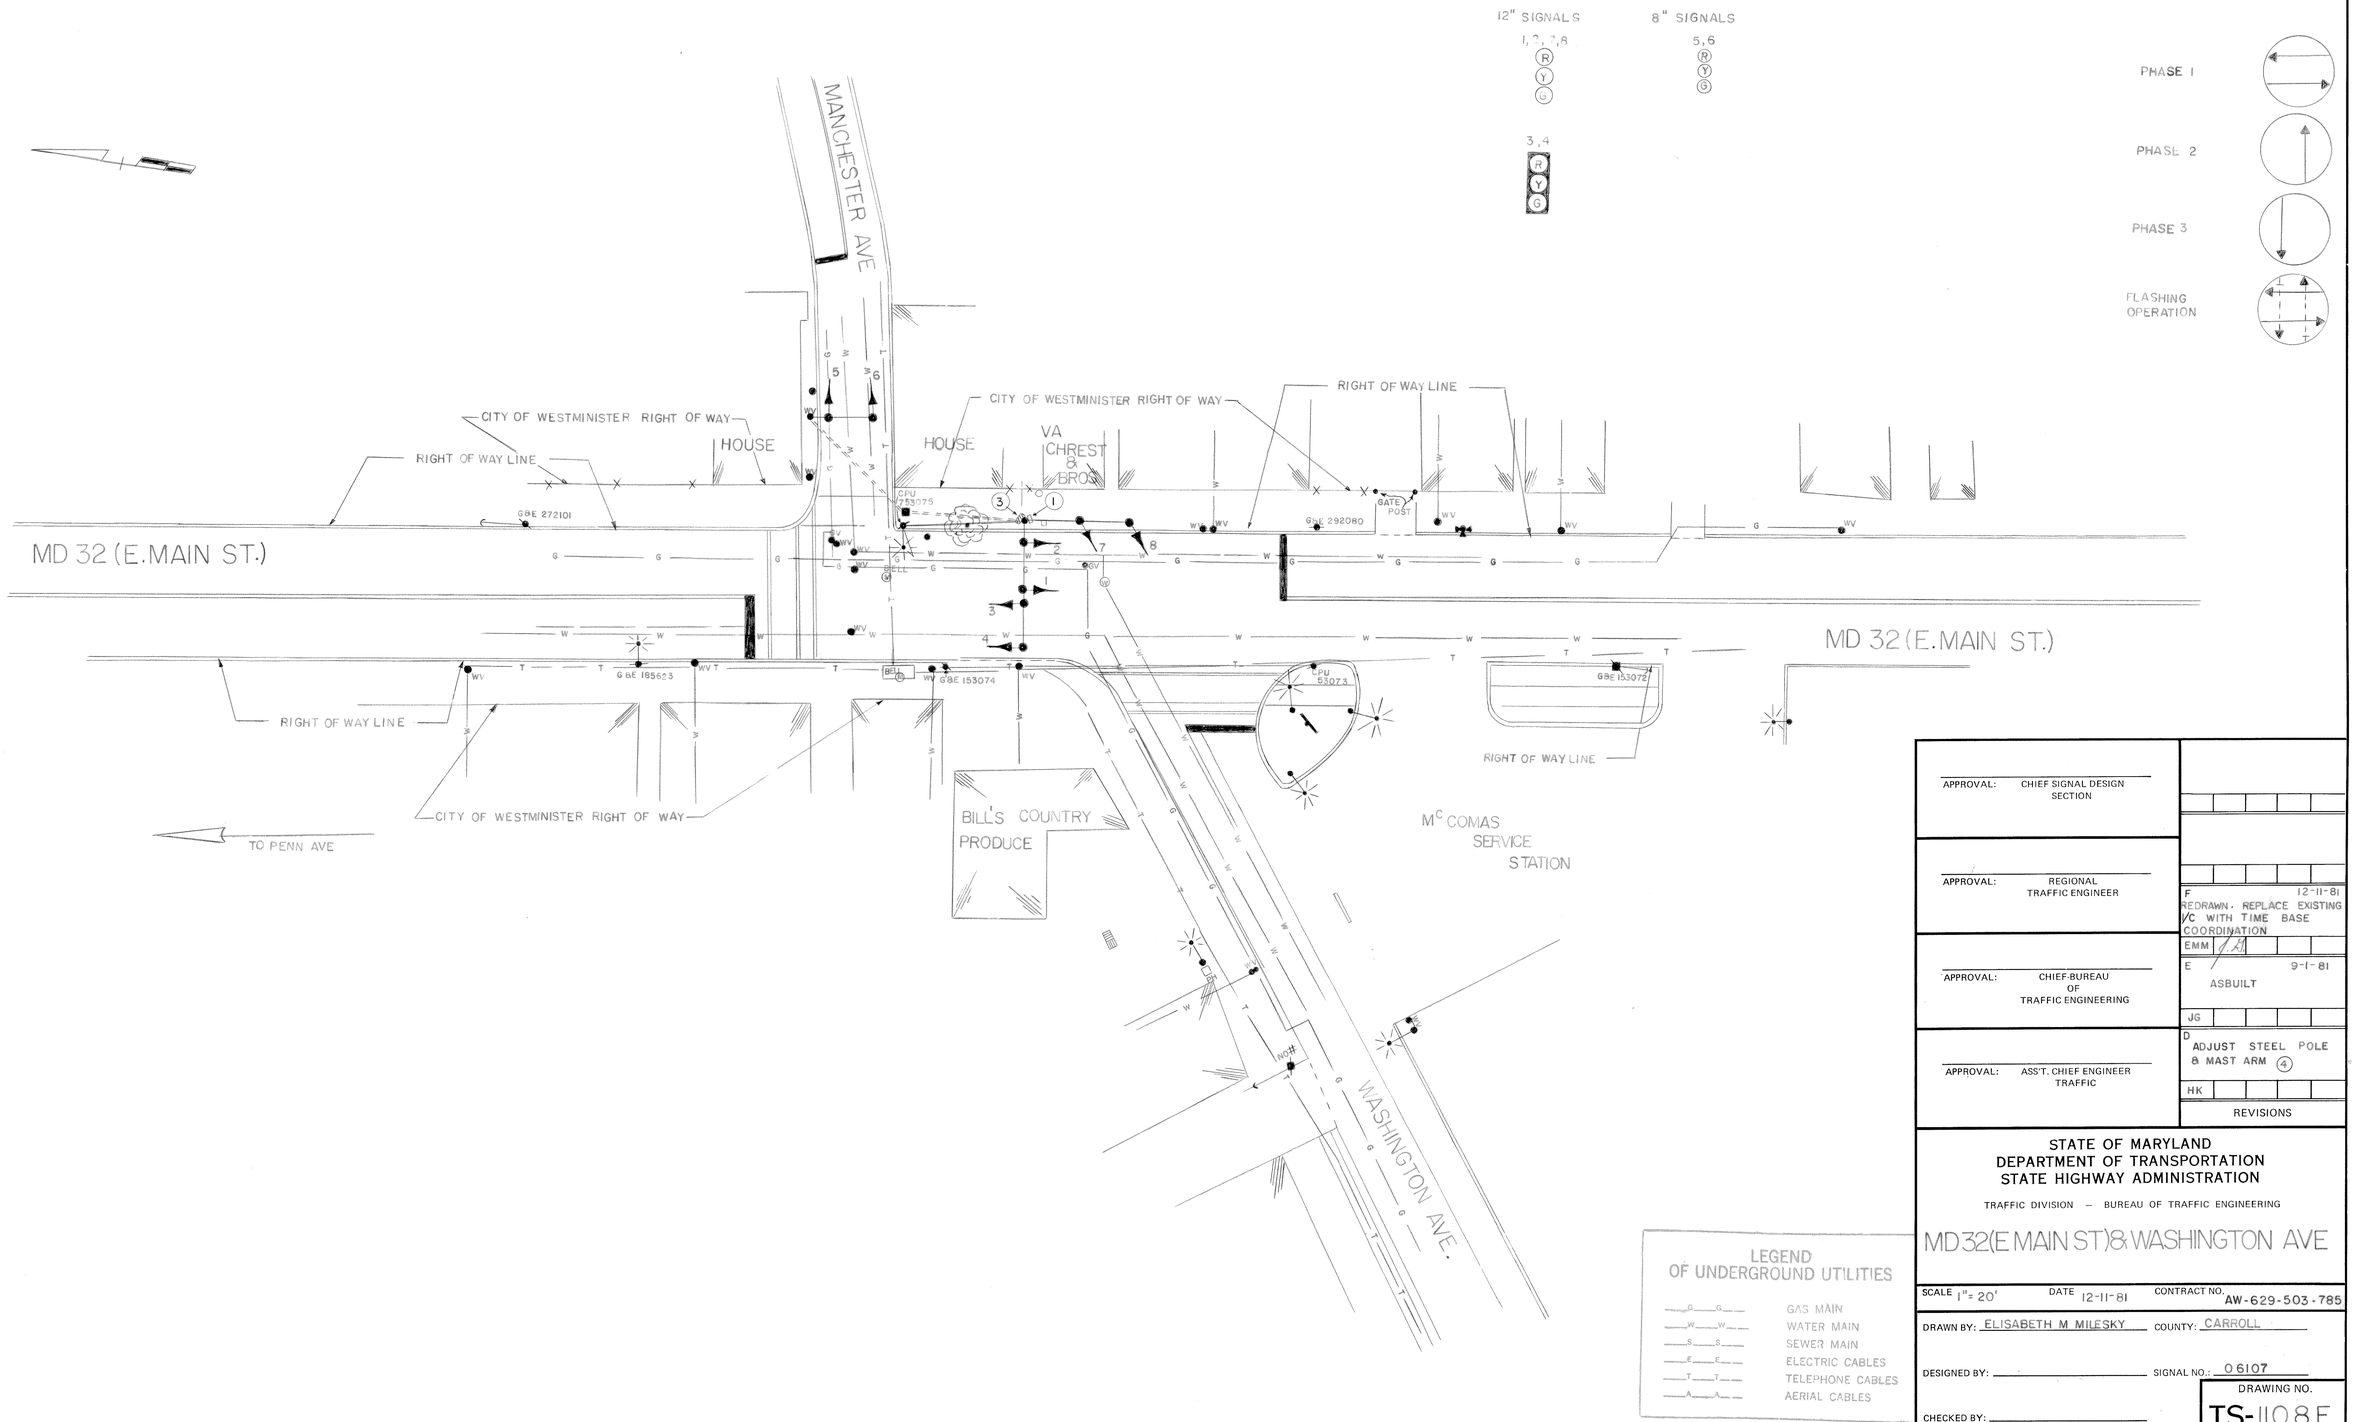

LEGEND OF UNDERGROUND UTILITIES

G	GAS MAIN
W	WATER MAIN
S	SEWER MAIN
E	ELECTRIC CABLES
T	TELEPHONE CABLES
A	AERIAL CABLES

APPROVAL: CHIEF SIGNAL DESIGN SECTION

APPROVAL: REGIONAL TRAFFIC ENGINEER

APPROVAL: CHIEF-BUREAU OF TRAFFIC ENGINEERING

APPROVAL: ASS'T. CHIEF ENGINEER TRAFFIC

F	REDRAWN: REPLACE EXISTING I/C WITH TIME BASE COORDINATION	12-11-81
EMM		
E	ASBUILT	9-1-81
JG		
D	ADJUST STEEL POLE & MAST ARM (4)	
HK		

REVISIONS

STATE OF MARYLAND
DEPARTMENT OF TRANSPORTATION
STATE HIGHWAY ADMINISTRATION

TRAFFIC DIVISION – BUREAU OF TRAFFIC ENGINEERING

MD 32 (E MAIN ST) & WASHINGTON AVE

SCALE 1" = 20' DATE 12-11-81 CONTRACT NO. AW-629-503-785

DRAWN BY: ELISABETH M MILESKY COUNTY: CARROLL

DESIGNED BY: SIGNAL NO.: 06107

CHECKED BY:

DRAWING NO. TS-1108F