F. H. WA. REGION NO	STATE	FED. AID PROJ. NO	SHEET NO.	TOTAL SHEETS
3	MD.			

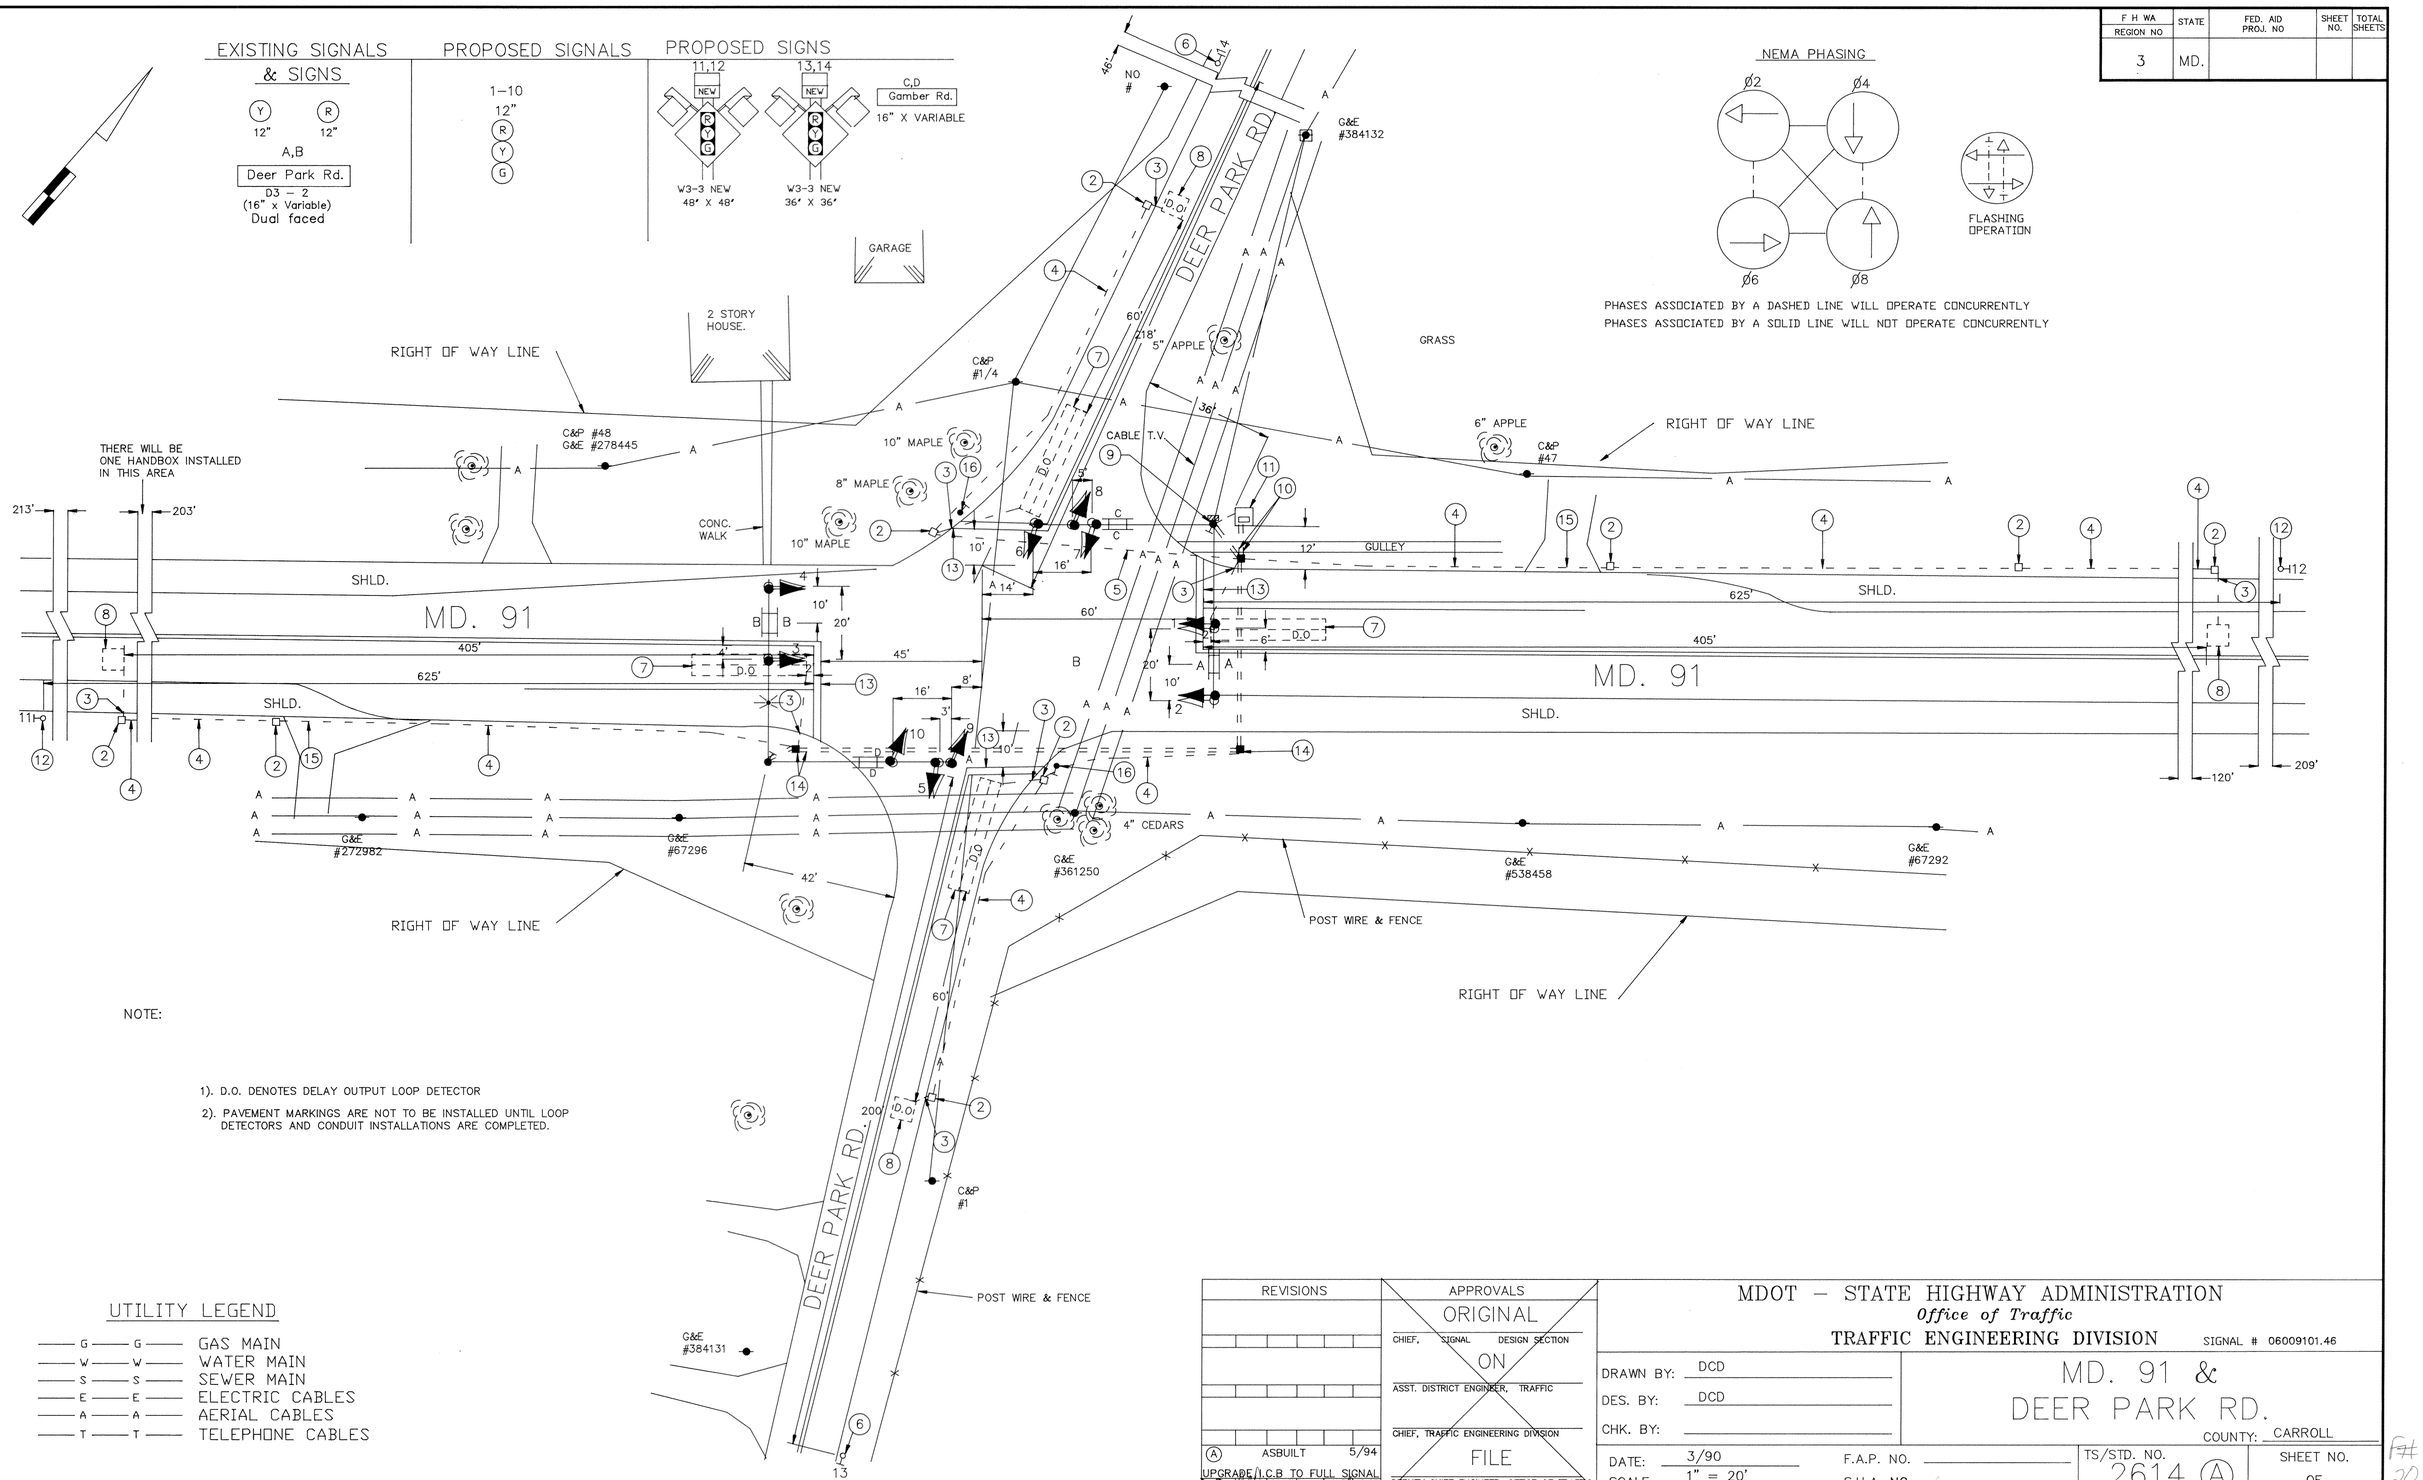

NOTE:

1). D.O. DENOTES DELAY OUTPUT LOOP DETECTOR

2). PAVEMENT MARKINGS ARE NOT TO BE INSTALLED UNTIL LOOP DETECTORS AND CONDUIT INSTALLATIONS ARE COMPLETED.

UTILITY LEGEND

—— G —— G ——	GAS MAIN
—— W —— W ——	WATER MAIN
—— S —— S ——	SEWER MAIN
—— E —— E ——	ELECTRIC CABLES
—— A —— A ——	AERIAL CABLES
—— T —— T ——	TELEPHONE CABLES

REVISIONS	APPROVALS
	ORIGINAL
	CHIEF, SIGNAL DESIGN SECTION
	ON
	ASST. DISTRICT ENGINEER, TRAFFIC
	CHIEF, TRAFFIC ENGINEERING DIVISION
Ⓐ ASBUILT 5/94	FILE
UPGRADE I.C.B TO FULL SIGNAL	DEPUTY CHIEF ENGINEER, OFFICE OF TRAFFIC

MDOT – STATE HIGHWAY ADMINISTRATION

Office of Traffic

TRAFFIC ENGINEERING DIVISION

SIGNAL # 06009101.46

DRAWN BY: DCD

DES. BY: DCD

CHK. BY:

MD. 91 & DEER PARK RD.

COUNTY: CARROLL

DATE: 3/90

SCALE: 1" = 20'

F.A.P. NO.

S.H.A. NO.

TS/STD. NO. 2614 Ⓐ

SHEET NO. ___ OF ___

Fig. 20