

MD 97 IS ASSUMED TO RUN IN A NORTH-SOUTH DIRECTION


EXISTING SIGNALS





PROPOSED SIGNS



EXISTING SIGNS TO BE REMOVED BY OTHERS

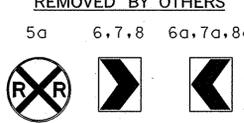

EXISTING SIGNS

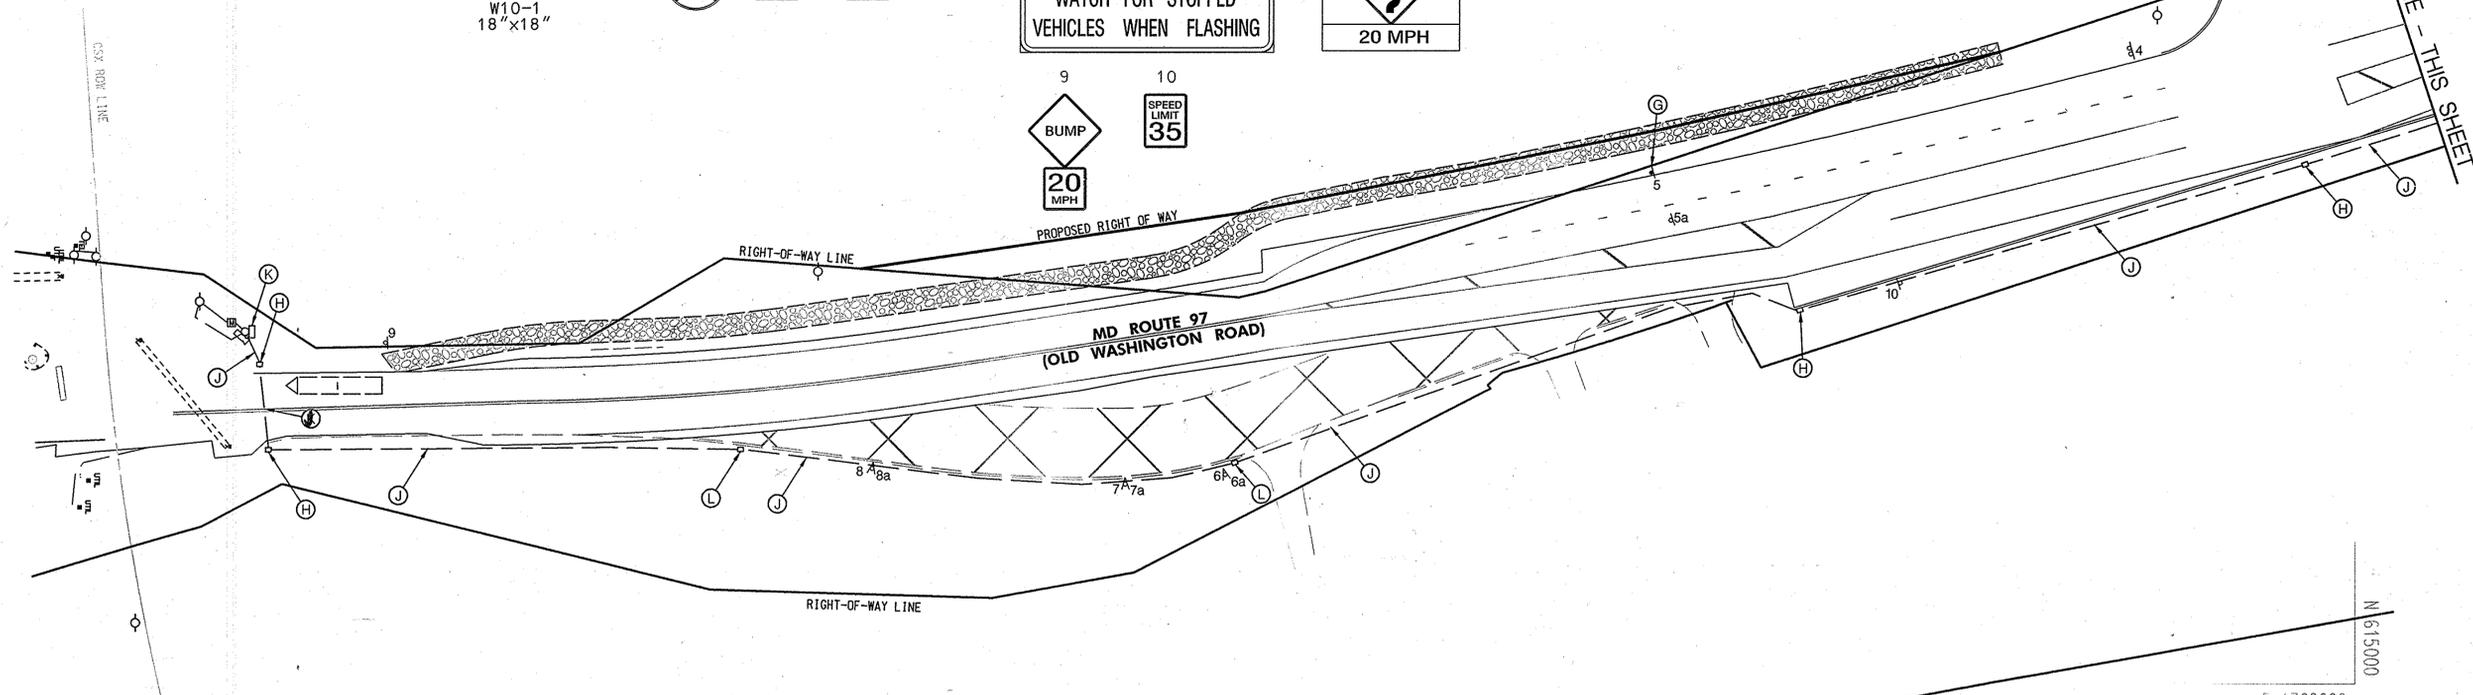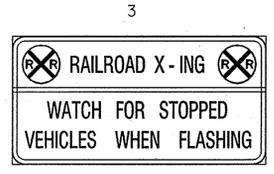

CONSTRUCTION DETAILS

- A. INSTALL ELECTRICAL HANDHOLE
- B. INSTALL 3 INCH SCHEDULE 80 PVC ELECTRICAL CONDUIT - TRENCHED
- C. REMOVE EXISTING HANDHOLE
- D. ABANDON EXISTING CONDUIT, CAP AT NEAREST HANDHOLE
- E. INSTALL W BEAM TRAFFIC BARRIER (DOUBLE POST) WITH TYPE 'C' END TREATMENTS ON EITHER END AS SHOWN
- F. INSTALL 3 INCH CONDUIT BEND IN EXISTING FOUNDATION
- G. INSTALL NEW GROUND MOUNTED SIGN ON ONE 4 INCH x 6 INCH WOOD SUPPORT
- H. USE EXISTING HANDHOLE
- J. USE EXISTING CONDUIT
- K. USE EXISTING POLE MOUNTED CABINET
- L. ADJUST EXISTING HANDHOLE TO GRADE

GENERAL NOTES

1. MAINTENANCE OF TRAFFIC WILL BE HANDLED BY THE CONTRACTOR UTILIZING MDSA STANDARD TYPICALS FOR TRAFFIC CONTROL.
2. THE CONTRACTOR SHALL CONTACT MISS UTILITY TO VERIFY ALL UNDERGROUND UTILITIES PRIOR TO THE INSTALLATION OF PROPOSED SIGNAL EQUIPMENT. IF ANY UTILITY CONFLICTS ARISE THE CONTRACTOR SHALL CONTACT THE PROJECT ENGINEER.
3. WITHIN 36 IN. OF UNDERGROUND UTILITY LOCATIONS, THE CONTRACTOR SHALL BE REQUIRED TO EXCAVATE FOR FOUNDATION AND CONDUIT BY HAND.
4. THE SHA SIGNAL SHOP WILL BE RESPONSIBLE FOR ALL INTERNAL CABINET WIRING. THE CONTRACTOR SHALL BE RESPONSIBLE FOR ROUTING AND PROPERLY LABELING ALL SIGNAL CABLES.
5. THE CONTRACTOR SHALL REMOVE AND DISPOSE OF ALL ABANDONED ELECTRICAL CABLES.
6. ALL EXISTING TRAFFIC SIGNAL EQUIPMENT REMOVED SHALL BECOME THE PROPERTY OF THE SIGNAL CONTRACTOR UPON COMPLETION OF THE SIGNAL MODIFICATION.

TOD NO: AT913-14
SHA NO: CL362A51
SOUTHBOUND MD9@CSX RAILROAD

SHA STATE OF MARYLAND
DEPARTMENT OF TRANSPORTATION
STATE HIGHWAY ADMINISTRATION
OFFICE OF TRAFFIC & SAFETY
TRAFFIC ENGINEERING DESIGN DIVISION
SOUTHBOUND MD 97 AT THE CSX RAILROAD
HAZARD IDENTIFICATION BEACON

MATCHLINE - THIS SHEET

GEOMETRIC LEGEND	APPROVALS	REVISIONS	SIGNALIZATION PLAN SHEET	
<p>EXISTING PROPOSED</p> <p>UTILITY LEGEND</p> <p>SD - STORM DRAIN G - GAS MAIN W - WATER MAIN S - SEWER MAIN E - ELECTRIC CABLES A - AERIAL CABLES T - TELEPHONE CABLES F - FIBER-OPTIC</p>	<p>TEAM LEADER</p> <p>ASST. DIR. CHIEF</p> <p>DIVISION CHIEF</p> <p>OFFICE DIRECTOR</p>	<p>(A) INSTALL NEW CONDUIT RUN 01/2008 DUE TO GEOMETRIC CHANGES SHA NO. AT9135185</p>	<p>SCALE 1" = 30' ADVERTISED DATE 705 CONTRACT NO. AT1715185</p> <p>DESIGNED BY FAE COUNTY CARROLL</p> <p>DRAWN BY LOGMILE 06097000.33</p> <p>CHECKED BY MJA TMS NO. 1902</p> <p>F.A.P. NO. TOD NO.</p>	<p>TS NO. 4424A DRAWING SG-01 OF 02 SHEET NO. 1 OF 2</p>

PLOTTED: Tuesday, January 15, 2008 at 9:33:00 AM
FILE: p53-P001_M067-CSX.dgn

BY: syoung2