F. H. WA REGION NO	STATE	FED. AID PROJ. NO	SHEET NO.	TOTAL SHEETS
3	MD.			

12" SIGNALS

1–4	5,6
Y	R

SIGNS

7

ONLY

R 3–5(L)
30"X 36"

FLASHING OPERATION

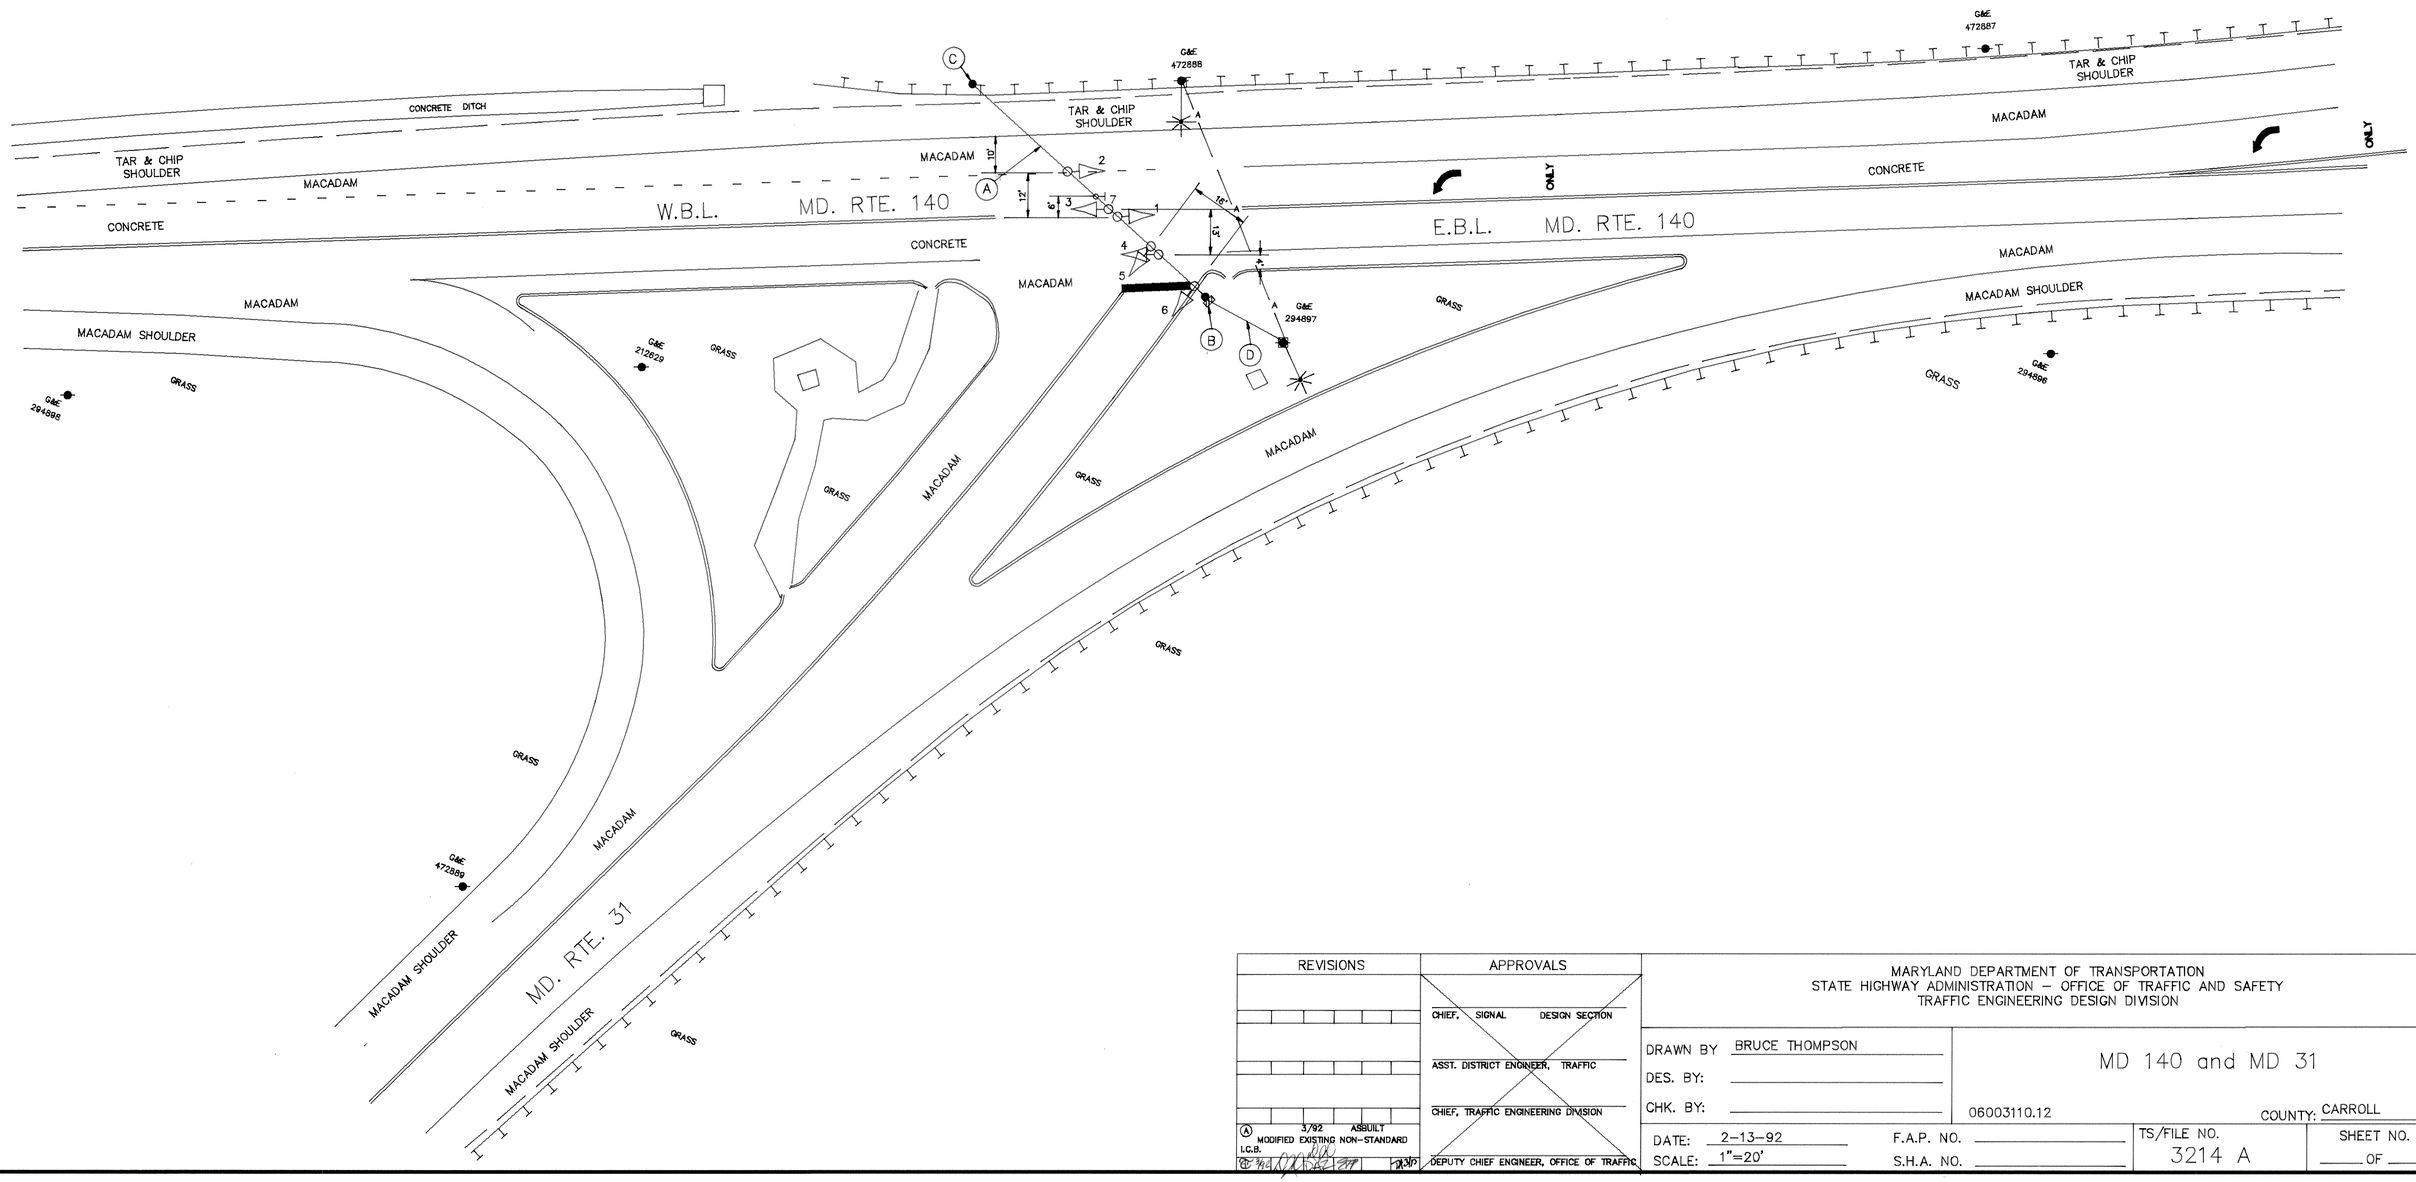

REVISIONS	APPROVALS
	CHIEF, SIGNAL DESIGN SECTION
	ASST. DISTRICT ENGINEER, TRAFFIC
	CHIEF, TRAFFIC ENGINEERING DIVISION
Ⓐ 3/92 ASBUILT MODIFIED EXISTING NON-STANDARD I.C.B.	DEPUTY CHIEF ENGINEER, OFFICE OF TRAFFIC

MARYLAND DEPARTMENT OF TRANSPORTATION
STATE HIGHWAY ADMINISTRATION – OFFICE OF TRAFFIC AND SAFETY
TRAFFIC ENGINEERING DESIGN DIVISION

DRAWN BY BRUCE THOMPSON
DES. BY:
CHK. BY:

MD 140 and MD 31

06003110.12

COUNTY: CARROLL

DATE: 2–13–92
SCALE: 1"=20'

F.A.P. NO.
S.H.A. NO.

TS/FILE NO. 3214 A

SHEET NO. ___ OF ___

06003110.12