F.H.W.A. REGION NO.	STATE	FED. AID PROJ. NO.	SHEET NO.	TOTAL SHEETS
3	MD	SEE TITLE SHEET	86	182

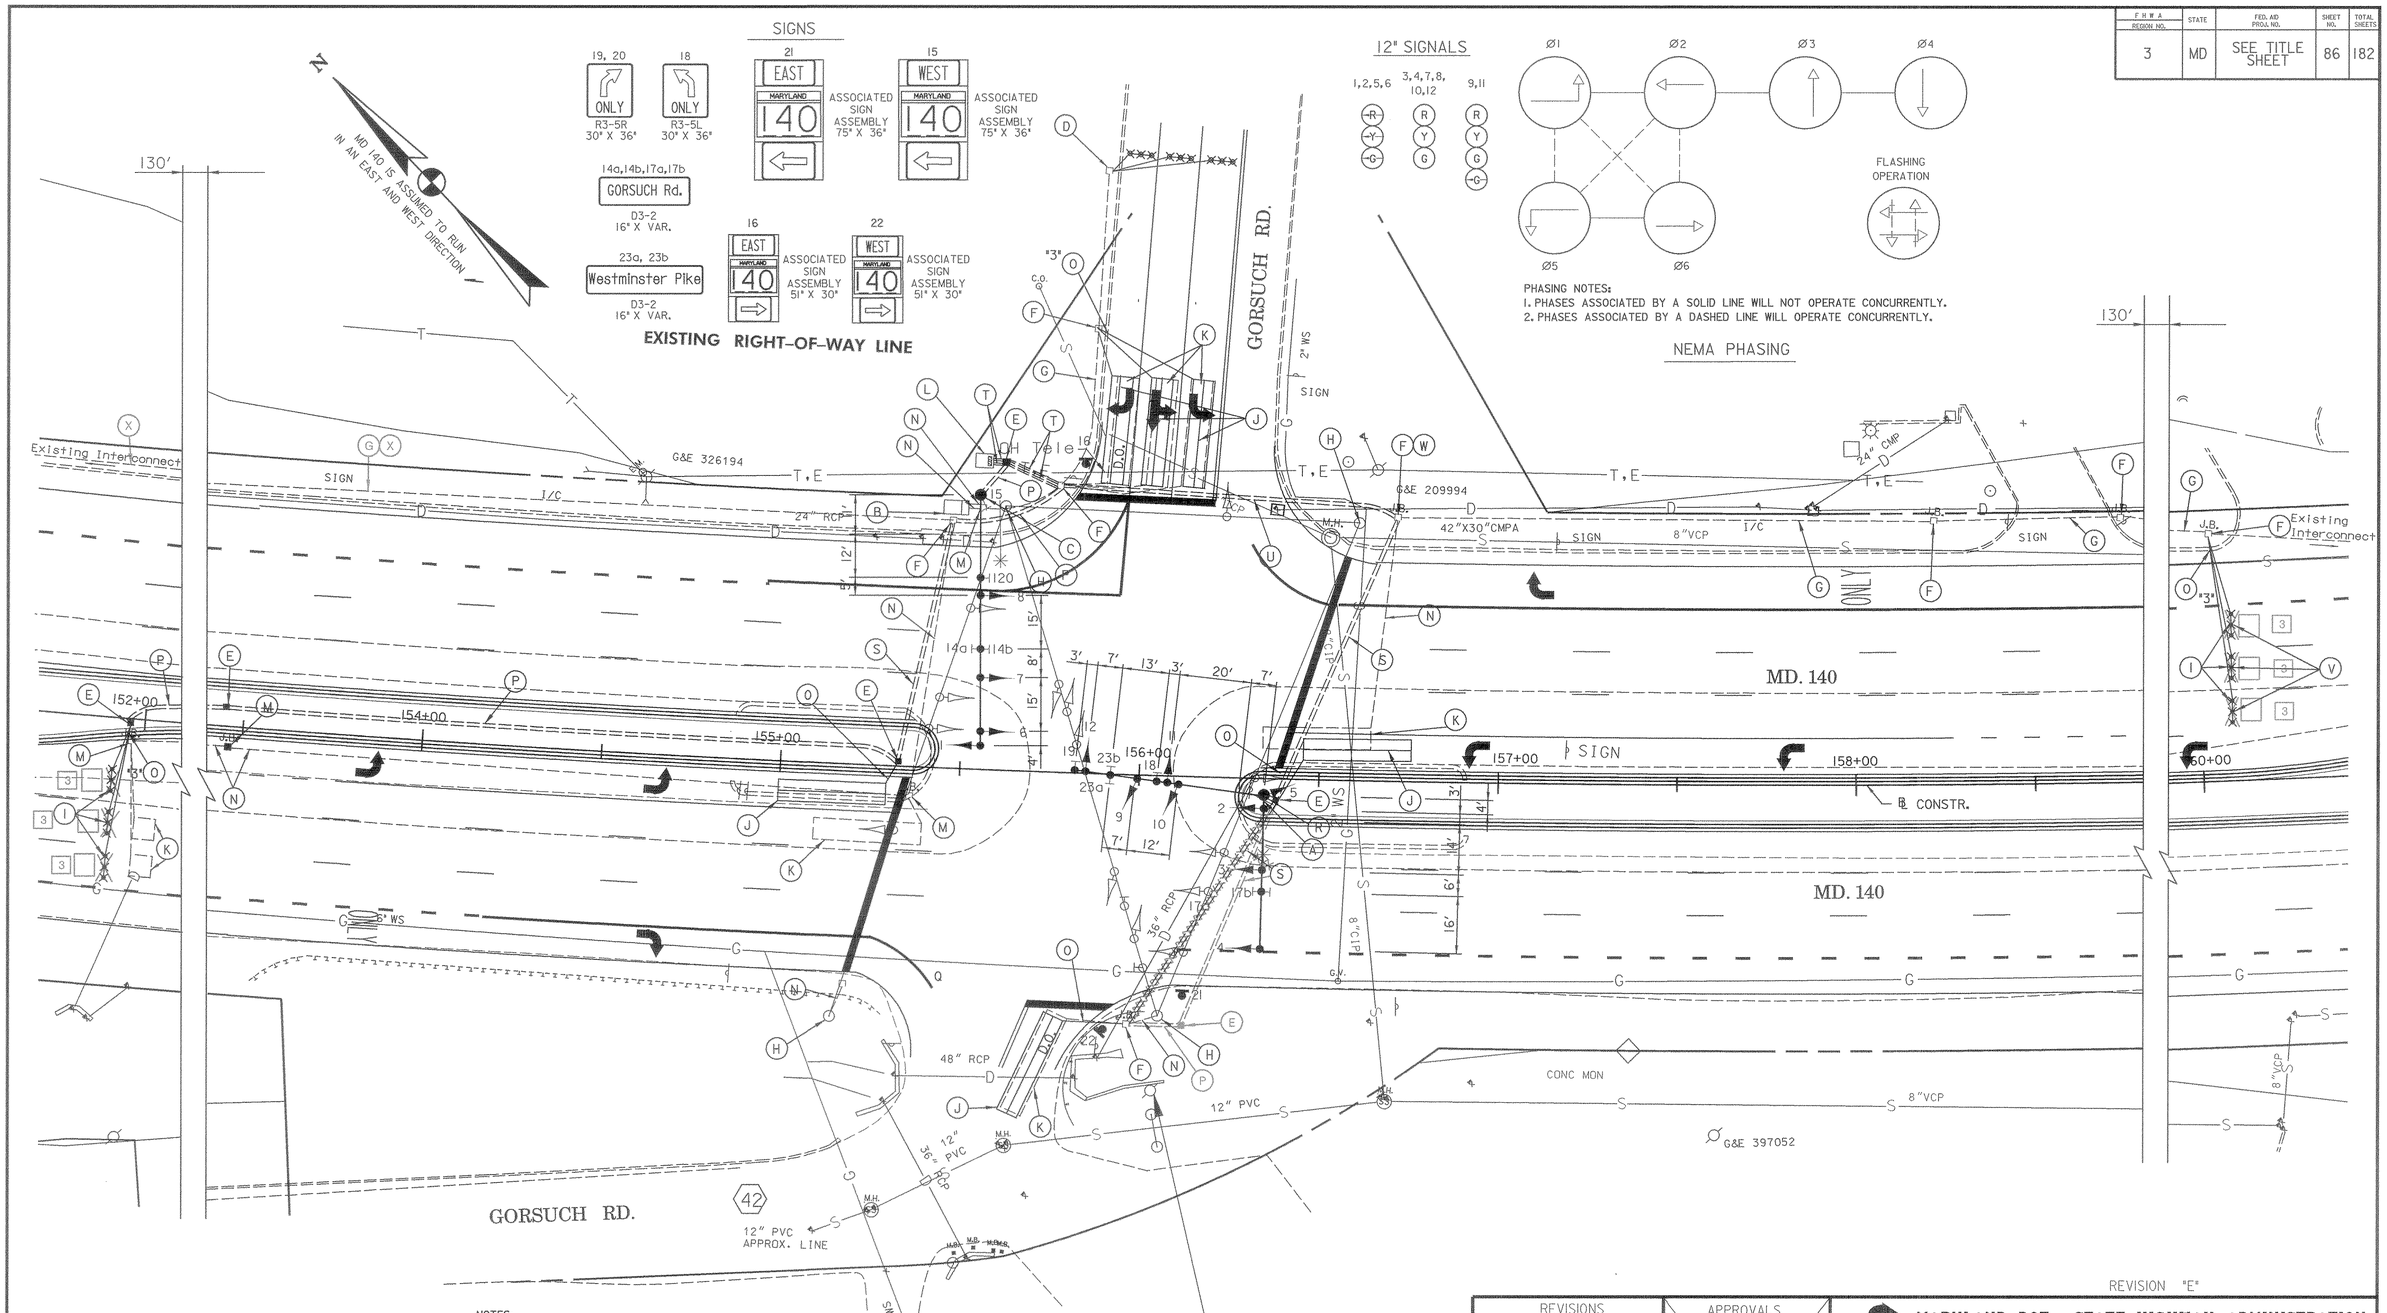

REVISION "E"

UTILITY LEGEND

G — G	GAS MAIN
W — W	WATER MAIN
S — S	SEWER MAIN
E — E	ELECTRIC CABLES
D — D	STORM DRAIN
A — A	AERIAL CABLES
T — T	TELEPHONE CABLES

NOTES:

1. THE SIGNAL CONTRACTOR SHALL CONFIRM GEOMETRICS PRIOR TO THE INSTALLATION OF SIGNAL EQUIPMENT.
2. LOOP DETECTORS AND CONDUIT SHALL BE INSTALLED PRIOR TO THE INSTALLATION OF PAVEMENT MARKINGS
3. PAVEMENT MARKINGS ARE TO BE INSTALLED BY THE CONTRACTOR IN ACCORDANCE WITH S.H.A. STANDARDS. PAVEMENT MARKING DETAILS ARE SHOWN ON THE SIGNING AND PAVEMENT MARKING PLAN.
4. ALL UNDERGROUND AND OVERHEAD UTILITIES SHOWN ON THESE PLANS ARE SCHEMATIC AND ARE NOT TO BE CONSIDERED COMPLETE. THE CONTRACTOR SHALL BE RESPONSIBLE FOR NOTIFYING ALL UTILITY COMPANIES PRIOR TO CONSTRUCTION SO THAT ALL UTILITIES MAY BE LOCATED IN THE FIELD. IF THE CONTRACTOR PERCEIVES THAT A CONFLICT BETWEEN THE UTILITIES AND THE TRAFFIC SIGNAL WILL OCCUR, THE CONTRACTOR SHALL NOTIFY THE APPROPRIATE PROJECT ENGINEER IMMEDIATELY.
5. 'D.O.' INDICATES DELAY OUTPUT LOOP DETECTOR.

REVISIONS	APPROVALS
3 REDLINE REVISION NO.3	ASST. DIVISION CHIEF, TEDD
ⓓ SEPT., 1997 RECONSTRUCT SIGNAL FOR NEW GEOMETRICS	ASST. DISTRICT ENGINEER, TRAFFIC
ⓑ APRIL 15, 1997 WIDEN NORTH LEG OF GORSUCH RD. SPLIT SIDE STREET S.H.A. NO. BW 772M82 R.R.Z.	CHIEF, TRAFFIC ENGINEERING DESIGN DIVISION
ⓒ APRIL 15, 1996 ADDED THRU LANE TO WESTBOUND MD. 140 S.H.A. NO. BW 881M82 M.A.M.	DIRECTOR, OFFICE OF TRAFFIC & SAFETY

ORIGINAL ON FILE

MARYLAND DOT - STATE HIGHWAY ADMINISTRATION

Office of Traffic & Safety

TRAFFIC ENGINEERING DESIGN DIVISION

TRAFFIC SIGNAL PLAN
MD. RTE. 140 AT GORSUCH ROAD

LOG MILE #06014008.50

DATE / /

DRAWN BY: R.L.L.	F.A.P. NO.	SEE TITLE SHEET	TS/STD. NO.	SHEET NO.
CHECK BY: R.D.C.	S.H.A. NO.	CL7845176	1388E	TS-5 OF TS-8
SCALE: 1"=20'	COUNTY	CARROLL		