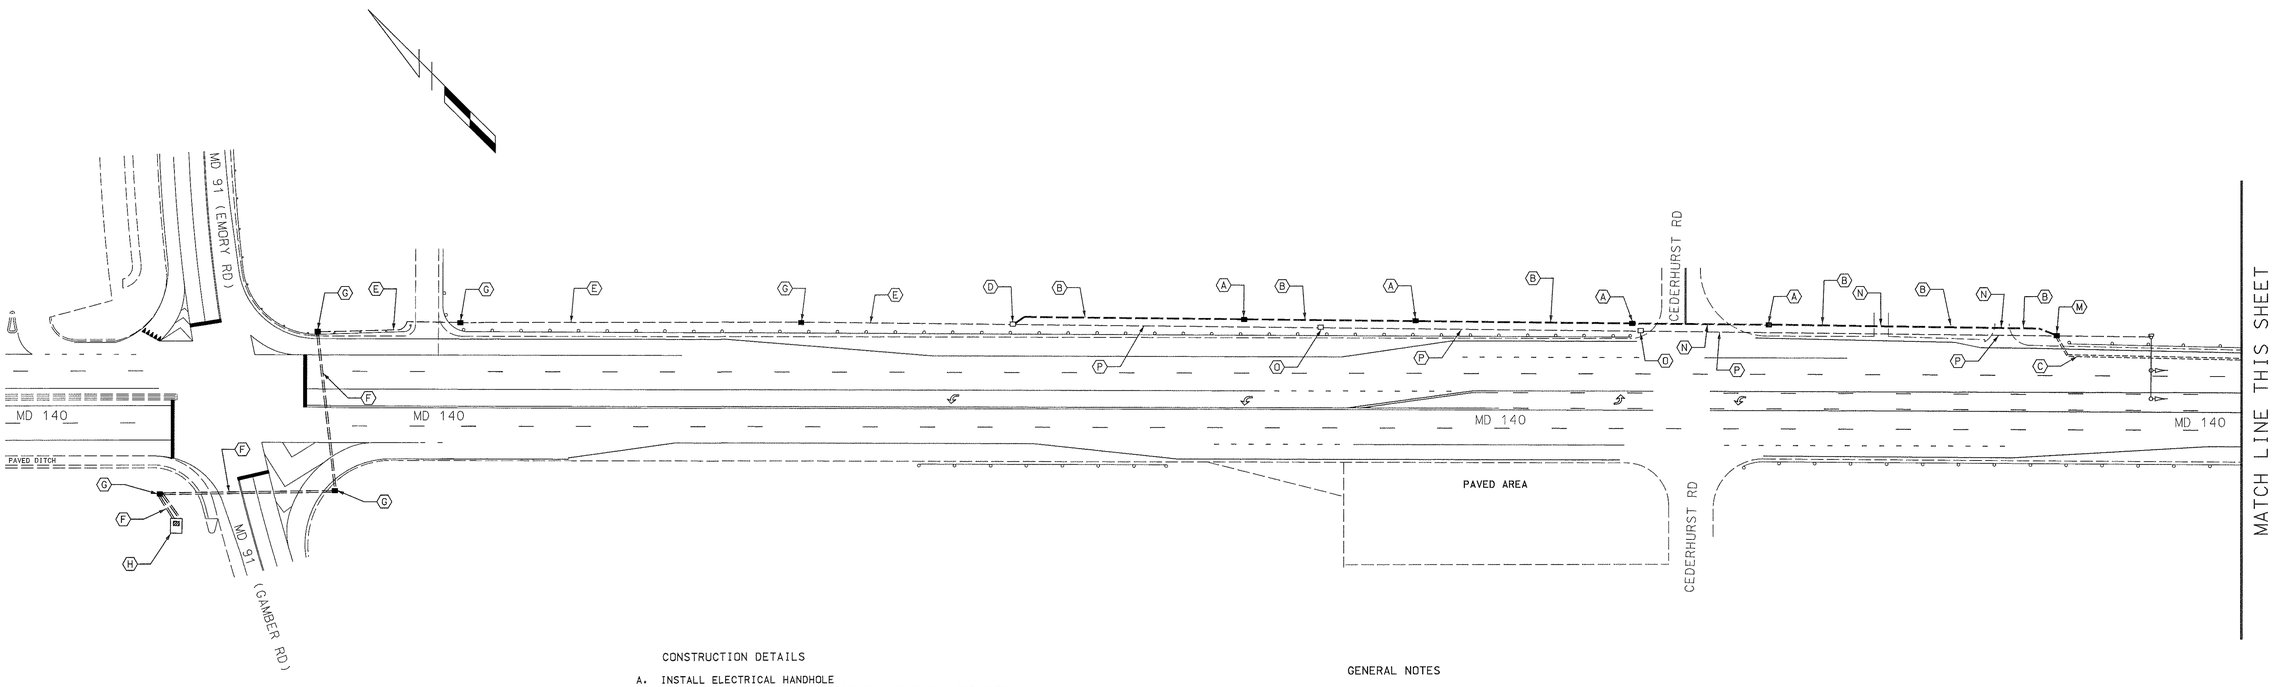


CONSTRUCTION DETAILS

A. INSTALL ELECTRICAL HANDHOLE
B. INSTALL 3 IN. SCHEDULE 80 RIGID PVC CONDUIT - TRENCHED
C. INSTALL 3 IN. SCHEDULE 80 RIGID PVC CONDUIT - SLOTTED
D. USE EXISTING HANDHOLE
E. USE EXISTING CONDUIT
F. 4 IN. CONDUIT (SEE SIGNAL PLAN)
G. HANDHOLE (SEE SIGNAL PLAN)
H. BASE MOUNTED CABINET AND CONTROLLER (SEE SIGNAL PLAN)
J. USE EXISTING POLE MOUNTED CABINET AND CONTROLLER
K. USE EXISTING STRAIN POLE
L. USE EXISTING SPAN WIRE
M. REPLACE HANDHOLE FRAME AND COVER
N. INSTALL 3 IN. SCHEDULE 80 RIGID PVC CONDUIT - BORED
O. ABANDON EXISTING HANDHOLE
P. ABANDON EXISTING CONDUIT

2

GENERAL NOTES

1. INSTALL 12-PAIR COMMUNICATION CABLE BETWEEN THE PROPOSED CONTROLLER AT MD 140 AND MD 91 AND THE EXISTING CONTROLLER AT MD 140 AND DEDE ROAD.
2. MAXIMUM SPACING OF HANDHOLES SHALL BE 200 FT.




2 REVISION 11-2-01

TRAFFIC CONCEPTS, INC.
325 Gambrills Road
Suite E
Gambrills, MD 21054
(410) 923-7101

MARYLAND DOT - STATE HIGHWAY ADMINISTRATION
*Office of Traffic & Safety*
TRAFFIC ENGINEERING DESIGN DIVISION
INTERCONNECT PLAN

MD 140 FROM MD 91 TO DEDE ROAD
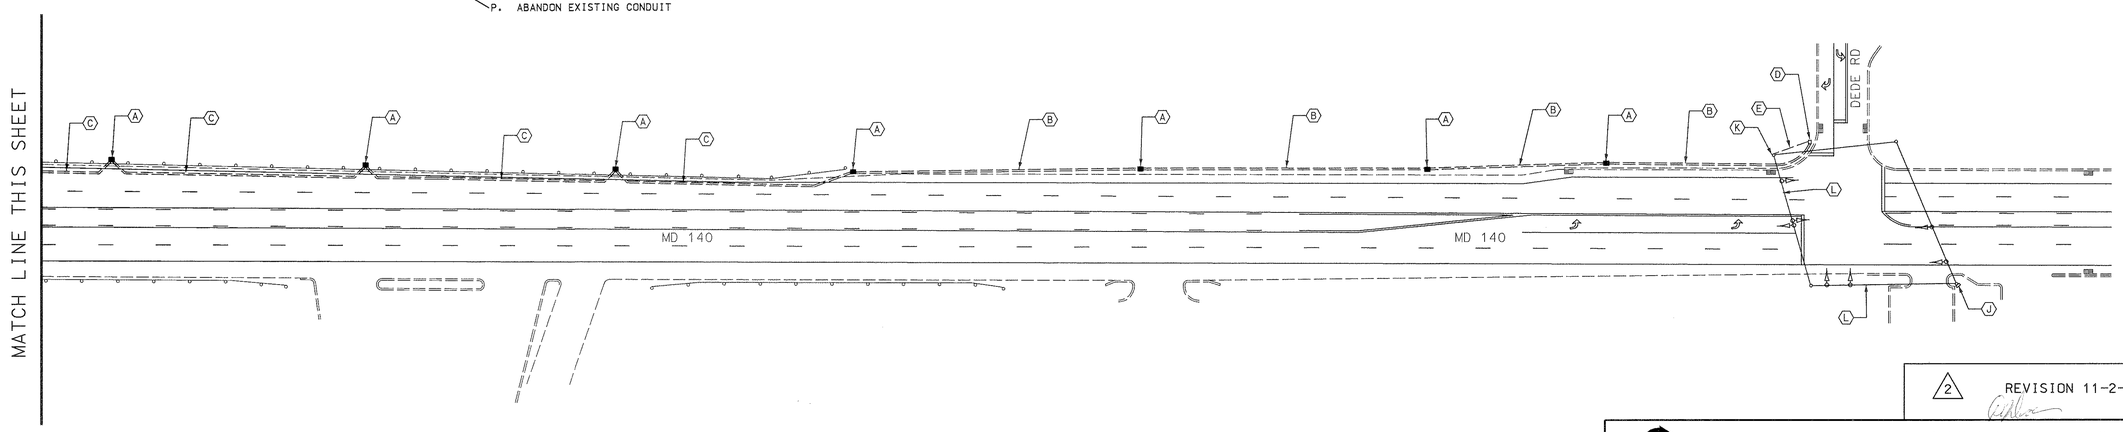
| | | | | | |
|---|---|---|---|---|---|
| DRAWN BY: | M. HOWELL | F.A.P. NO. | | TS NO. 1667C I/C | SHEET NO. |
| CHECKED BY: | T. ZAYDEL | S.H.A. NO. | | | |
| SCALE: | 1" = 50' | COUNTY: | CARROLL | T.I.M.S. NO. E620 | ___ OF ___ |
| DATE: | 6-22-01 | LOG MILE: | | | |