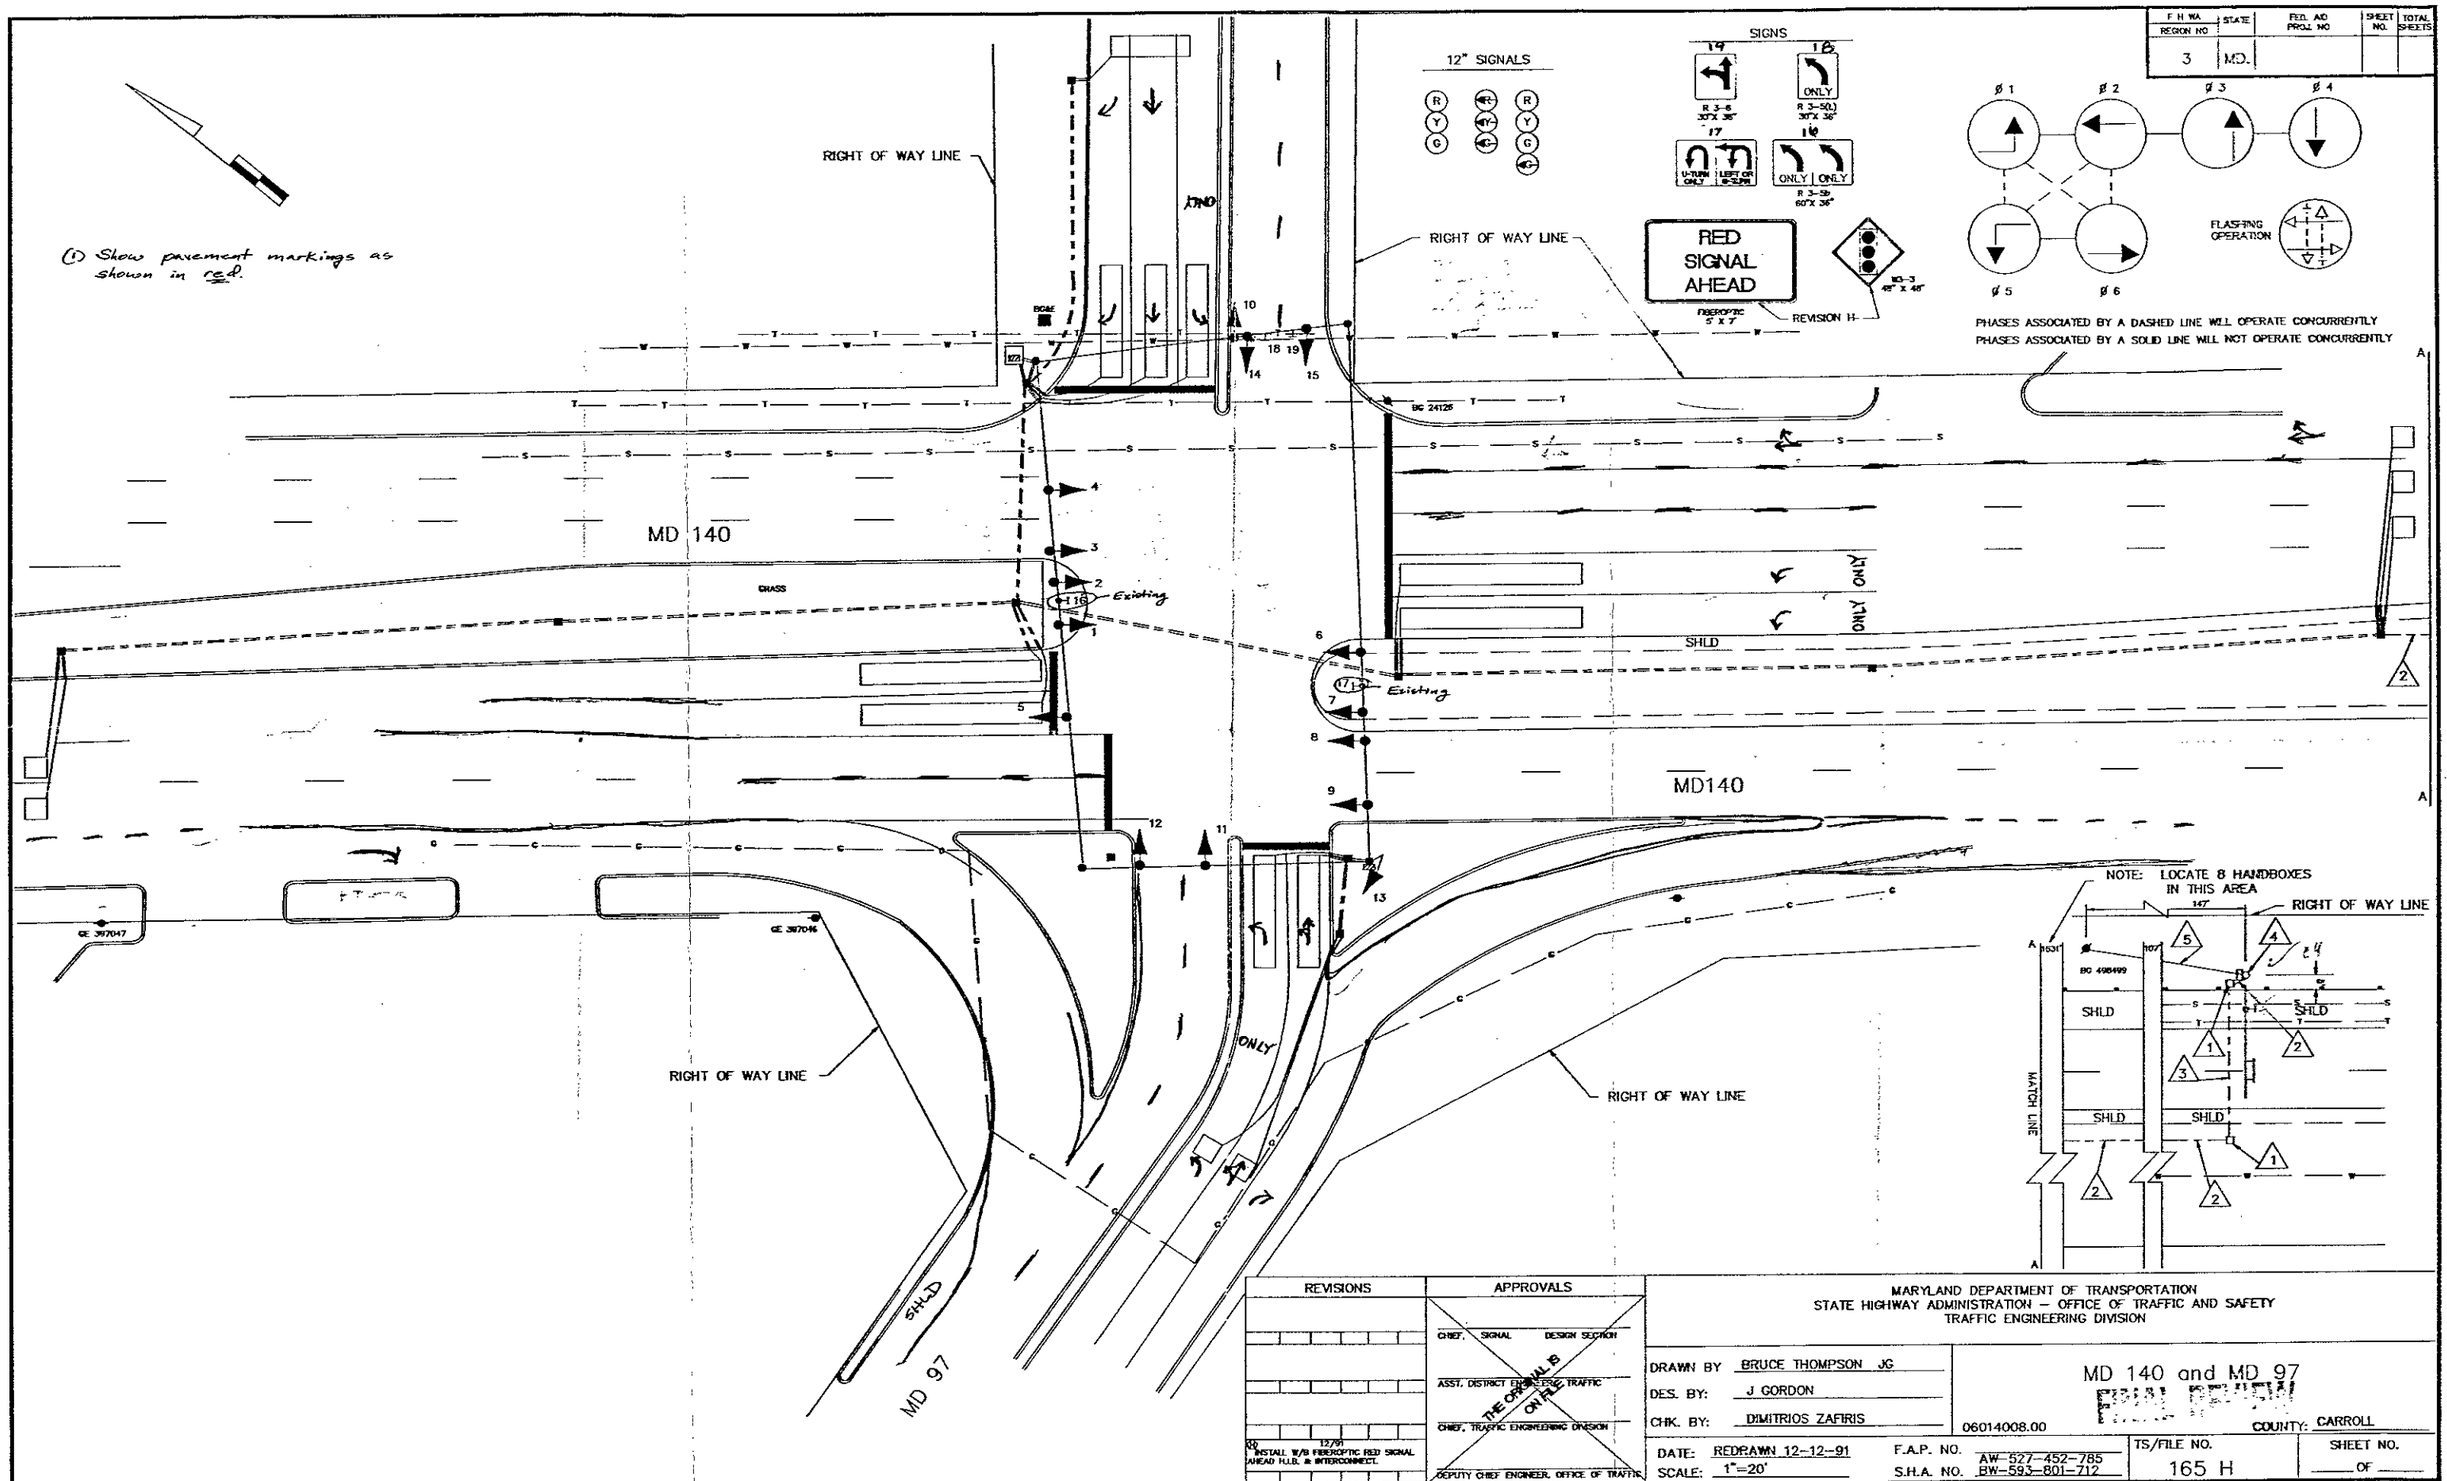

F H WA REGION NO 3
STATE MD.
FED. AID PROJ. NO
SHEET NO.
TOTAL SHEETS
12" SIGNALS
SIGNS
RED SIGNAL AHEAD
REVISION H
FLASHING OPERATION
PHASES ASSOCIATED BY A DASHED LINE WILL OPERATE CONCURRENTLY
PHASES ASSOCIATED BY A SOLID LINE WILL NOT OPERATE CONCURRENTLY
(1) Show pavement markings as shown in red.
RIGHT OF WAY LINE
MD 140
MD140
MD 97
GRASS
SHLD
ONLY
Existing
NOTE: LOCATE 8 HANDBOXES IN THIS AREA
MATCH LINE
REVISIONS
APPROVALS
CHIEF, SIGNAL DESIGN SECTION
ASST. DISTRICT ENGINEER, TRAFFIC
CHIEF, TRAFFIC ENGINEERING DIVISION
DEPUTY CHIEF ENGINEER, OFFICE OF TRAFFIC
THE ORIGINAL IS ON FILE
12/91
INSTALL W/B FIBEROPTIC RED SIGNAL AHEAD H.I.B. & INTERCONNECT.
MARYLAND DEPARTMENT OF TRANSPORTATION
STATE HIGHWAY ADMINISTRATION – OFFICE OF TRAFFIC AND SAFETY
TRAFFIC ENGINEERING DIVISION
DRAWN BY BRUCE THOMPSON JG
DES. BY: J GORDON
CHK. BY: DIMITRIOS ZAFIRIS
MD 140 and MD 97
06014008.00
COUNTY: CARROLL
DATE: REDRAWN 12-12-91
SCALE: 1"=20'
F.A.P. NO. AW-527-452-785
S.H.A. NO. BW-593-801-712
TS/FILE NO. 165 H
SHEET NO. OF