F.H.WA. REGION NO.	STATE	FED. AID PROJ. NO.	SHEET NO.	TOTAL SHEETS
3	MD.		2	2

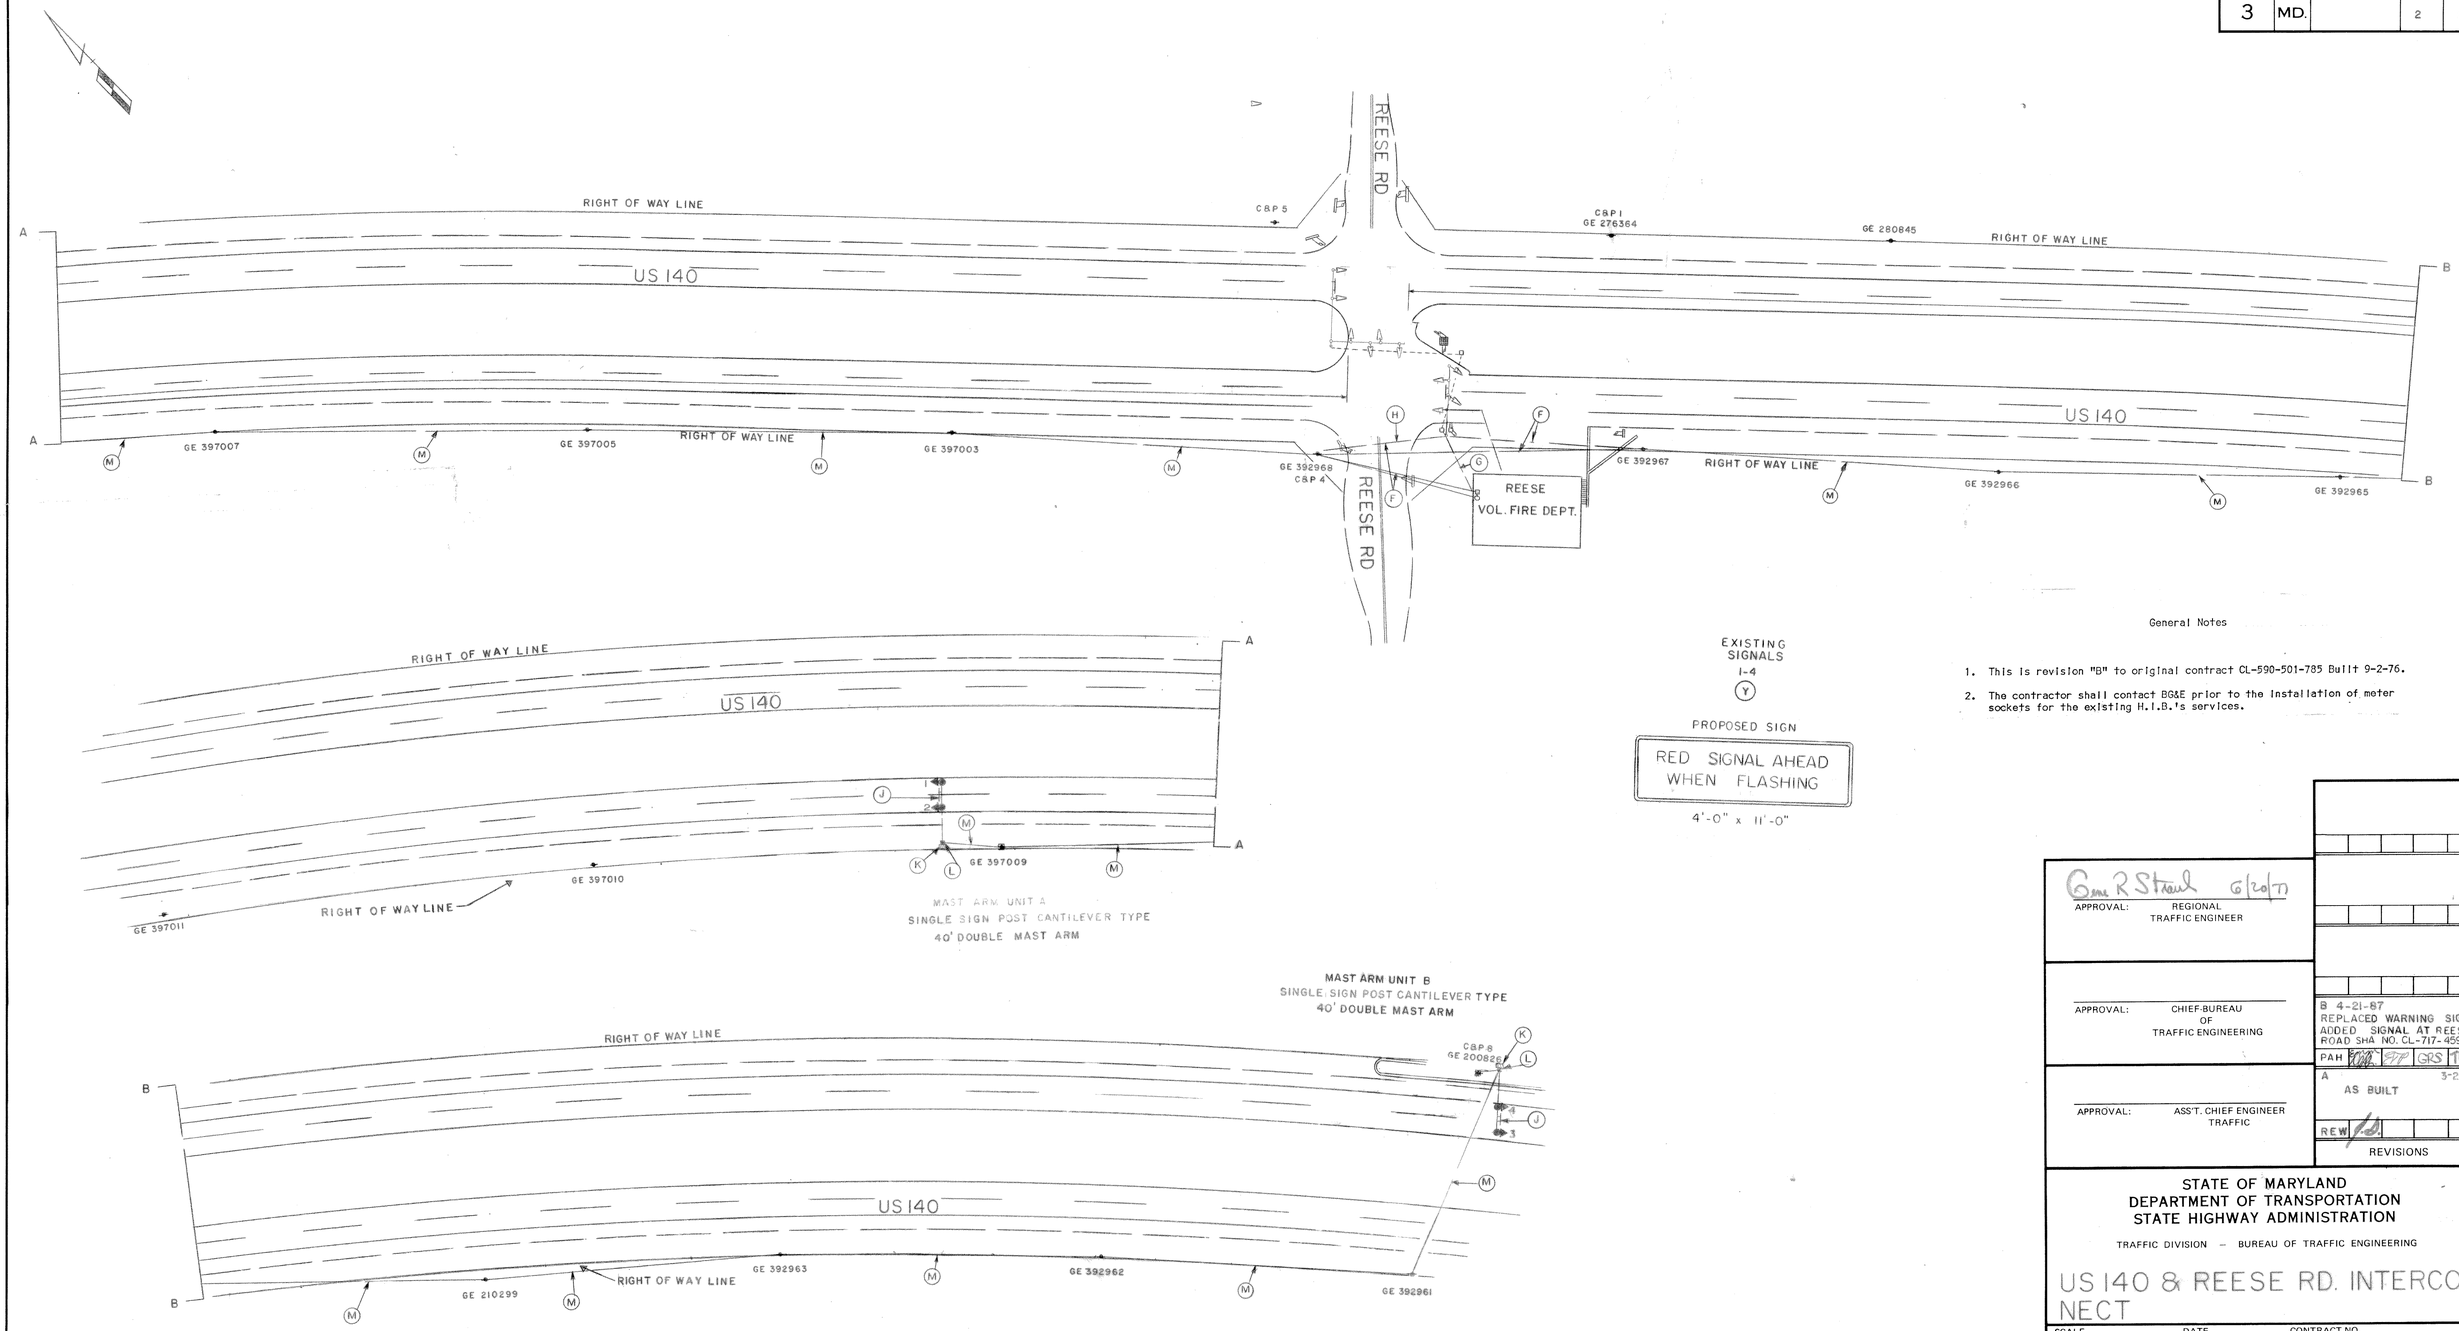

General Notes

1. This is revision "B" to original contract CL-590-501-785 Built 9-2-76.
2. The contractor shall contact BG&E prior to the installation of meter sockets for the existing H.I.B.'s services.

APPROVAL: REGIONAL TRAFFIC ENGINEER — Gene R Strauch 6/20/77

APPROVAL: CHIEF-BUREAU OF TRAFFIC ENGINEERING

APPROVAL: ASS'T. CHIEF ENGINEER TRAFFIC

B 4-21-87
REPLACED WARNING SIGNS
ADDED SIGNAL AT REESE
ROAD SHA NO. CL-717-459-785
PAH | GRS | TH 7/13

A 3-28-79
AS BUILT

REW

REVISIONS

STATE OF MARYLAND
DEPARTMENT OF TRANSPORTATION
STATE HIGHWAY ADMINISTRATION

TRAFFIC DIVISION – BUREAU OF TRAFFIC ENGINEERING

US 140 & REESE RD. INTERCONNECT

SCALE 1" = 50' DATE 10-5-76 CONTRACT NO. CL-590-501-785

DRAWN BY: J GORDON COUNTY: CARROLL

DESIGNED BY: J Gordon SIGNAL NO.:

CHECKED BY: A. Budnichuk 3-13-77

DRAWING NO. TS-176X1B

BRUNING 44-511 19927