K&E BALTIMORE 17 0153 PHOENIX 10-35 MC 4156

F.H.W.A. REGION NO.	STATE	FED. AID PROJ. NO.	SHEET NO.	TOTAL SHEETS
3	MD.		6	9

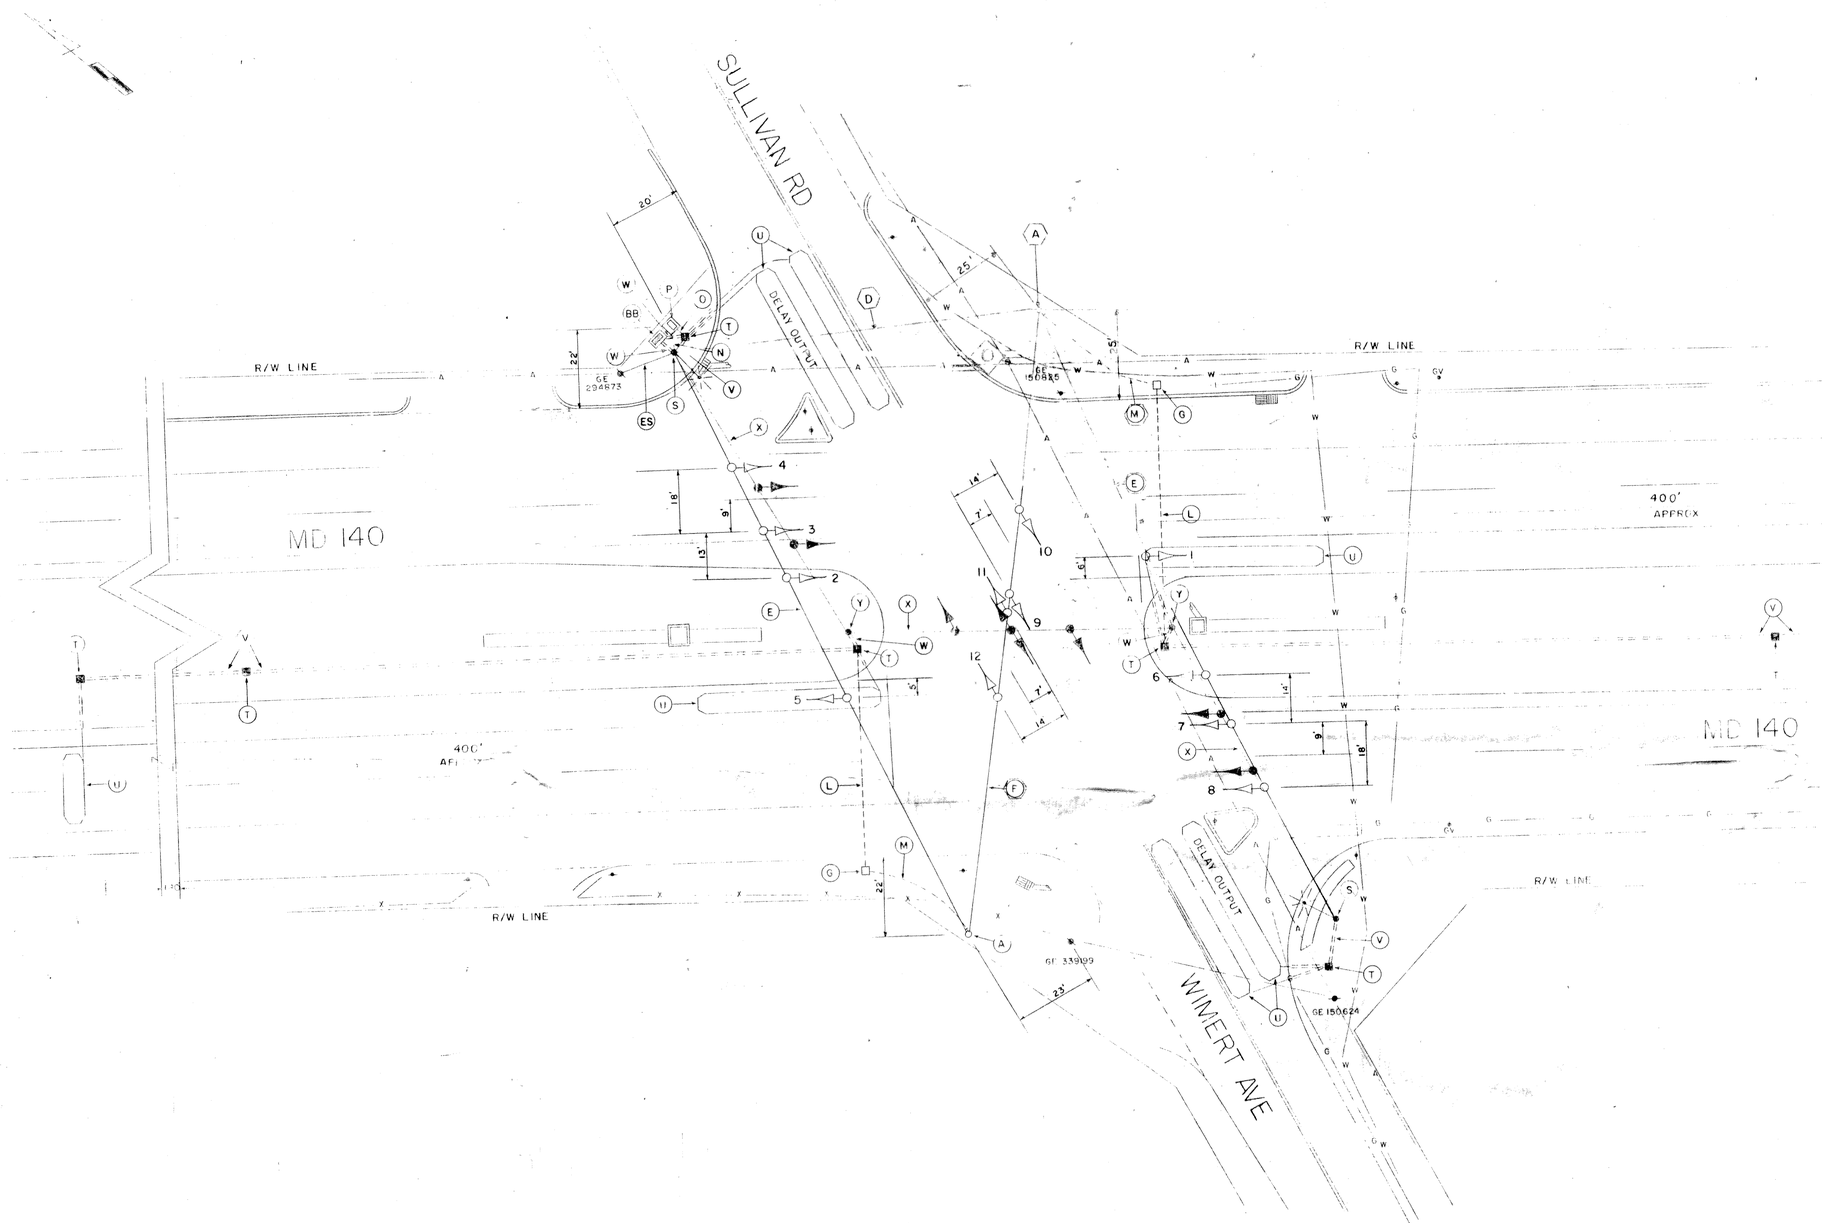

SIGNALS

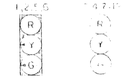

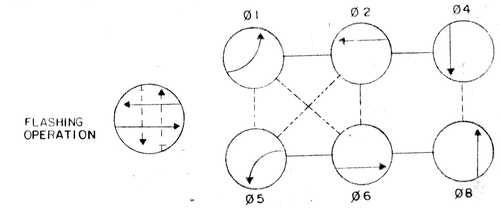

1) Phases associated by a solid line will not operate concurrently.
2) Phases associated by a dashed line may/will operate concurrently.

LEGEND OF UNDERGROUND UTILITIES

	GAS MAIN
W	WATER MAIN
	SEWER MAIN
	ELECTRIC CABLE
	TELEPHONE CABLE
	FIBER OPTIC CABLE

APPROVAL: REGIONAL TRAFFIC ENGINEER

APPROVAL: CHIEF BUREAU OF TRAFFIC ENGINEERING

APPROVAL: ASS'T. CHIEF ENGINEER TRAFFIC

(B) REVISED 8-2-84
POLE RELOCATED IN SOUTH EAST QUADRANT.
S.H.A. NO. CL 612-501-785
E MM

A. RELOCATE STEEL POLES & SIG. INSTALL NEW CONT., T.B & C.B.C.
S.H.A. NO. CL-612-501-785

REVISIONS

STATE OF MARYLAND
DEPARTMENT OF TRANSPORTATION
STATE HIGHWAY ADMINISTRATION

TRAFFIC DIVISION – BUREAU OF TRAFFIC ENGINEERING

MD 140 & SULLIVAN RD

SCALE 1"=20' DATE 4-5-79 CONTRACT NO.

DRAWN BY: J GORDON COUNTY: CARROLL

DESIGNED BY: SIGNAL NO.:

CHECKED BY: 6/4/79

DRAWING NO. TS-1577A 8

06014010.04