F H WA REGION NO	STATE	FED. AID PROJ. NO	SHEET NO.	TOTAL SHEETS
3	MD.			

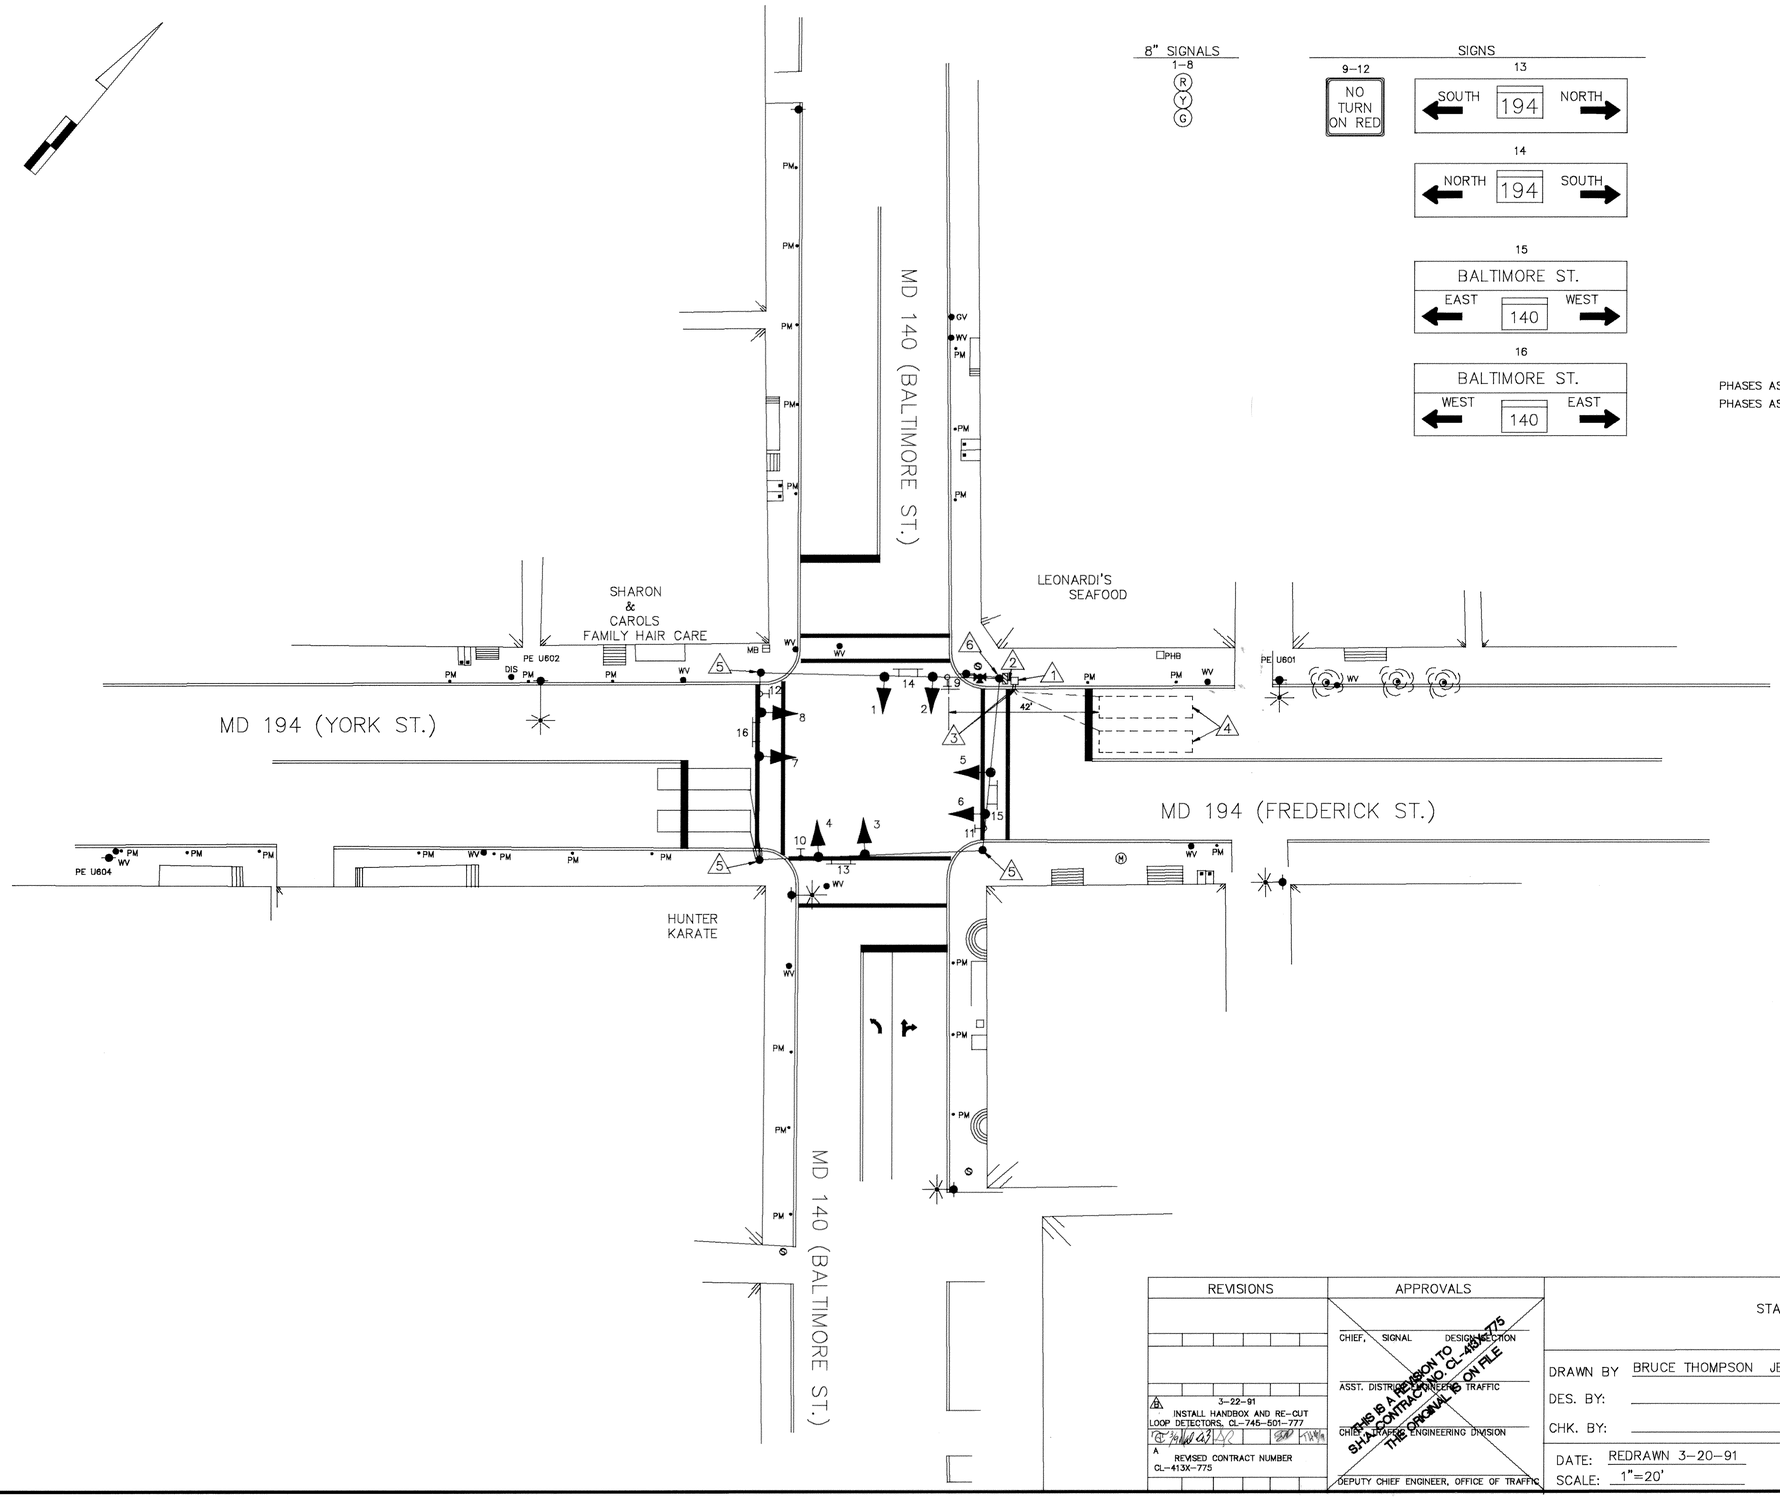

8" SIGNALS

1–8 R Y G

SIGNS

9–12 NO TURN ON RED

13 SOUTH 194 NORTH

14 NORTH 194 SOUTH

15 BALTIMORE ST. EAST 140 WEST

16 BALTIMORE ST. WEST 140 EAST

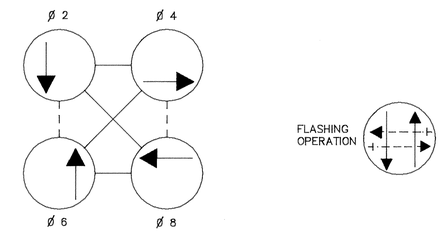

PHASES ASSOCIATED BY A DASHED LINE WILL OPERATE CONCURRENTLY
PHASES ASSOCIATED BY A SOLID LINE WILL NOT OPERATE CONCURRENTLY

REVISIONS	APPROVALS
3-22-91 INSTALL HANDBOX AND RE-CUT LOOP DETECTORS, CL-745-501-777	CHIEF, SIGNAL DESIGN SECTION
A REVISED CONTRACT NUMBER CL-413X-775	ASST. DISTRICT ENGINEER, TRAFFIC
	CHIEF, TRAFFIC ENGINEERING DIVISION
	DEPUTY CHIEF ENGINEER, OFFICE OF TRAFFIC

THIS IS A REVISION TO S.H.A. CONTRACT NO. CL-413X-775 THE ORIGINALS ON FILE

MARYLAND DEPARTMENT OF TRANSPORTATION
STATE HIGHWAY ADMINISTRATION – OFFICE OF TRAFFIC
TRAFFIC ENGINEERING DIVISION

DRAWN BY BRUCE THOMPSON JB
DES. BY:
CHK. BY:

MD 140 and MD 194
TANEYTOWN

06019406.25

COUNTY: CARROLL

DATE: REDRAWN 3-20-91
SCALE: 1"=20'

F.A.P. NO.
S.H.A. NO. CL-513X-785

TS/FILE NO. 732 B

SHEET NO. ___ OF ___

06014021.48