PROJECT DESCRIPTION

I. GENERAL

THIS PROJECT INVOLVES THE MODIFICATION OF AN EXISTING TRAFFIC CONTROL SIGNAL (ULTIMATE PHASE) AT THE INTERSECTION OF MD ROUTE 187 (OLD GEORGETOWN ROAD) AND I-270 SB AND NB RAMPS IN MONTGOMERY COUNTY. MD ROUTE 187 (OLD GEORGETOWN ROAD) IS ASSUMED TO RUN IN A NORTH-SOUTH DIRECTION.

II. INTERSECTION OPERATION

THE INTERSECTION WILL OPERATE IN A NEMA SIX (6) PHASE, SEMI-TRAFFIC-ACTUATED MODE. THERE WILL BE AN EXCLUSIVE LEFT TURN PHASE FOR SOUTHBOUND AND NORTHBOUND MD 187 MOVEMENT. THE MD 187 THROUGH MOVEMENTS ARE TO OPERATE CONCURRENTLY. EASTBOUND MOVEMENTS FROM THE I-270 RAMPS WILL OPERATE CONCURRENTLY. AN ADDITIONAL EASTBOUND RIGHT TURN PHASE ON THE I-270 RAMP WILL OPERATE CONCURRENTLY WITH THE EASTBOUND I-270 RAMP MOVEMENT. CONCURRENT PEDESTRIAN PHASES WILL BE PROVIDED ACROSS THE EAST AND WEST LEGS OF MD 187.

A FULL-TRAFFIC-ACTUATED, EIGHT-PHASE CONTROLLER WITH VIDEO TRAFFIC DETECTION SYSTEM, AND L.A.U. PANEL WITH ASSOCIATED HARNESS HOUSED IN A NEMA SIZE "6" BASE MOUNTED CABINET WILL BE INSTALLED AT THIS LOCATION.

III. INTERCONNECTION

THE EXISTING 50 PAIR VOICE GRADE INTERCONNECT CABLE BETWEEN THE INTERSECTIONS OF MD 187 AT TUCKERMAN LANE AND MD 187 AT ROCK SPRING DRIVE IS TO BE MAINTAINED AND REWIRED AS SHOWN ON THE WIRING DIAGRAM.

THE CONTRACTOR SHALL BE RESPONSIBLE FOR TERMINATING ALL SIGNAL CABLE, EXCLUDING INTERCONNECT, TO THE APPROPRIATE TERMINALS AND PROPERLY LABELING EACH CABLE. DISCONNECTING AND SPLICING OF INTERCONNECT CABLE SHALL BE PERFORMED BY MONTGOMERY COUNTY FORCES. THE CONTRACTOR SHALL RUN THE INTERCONNECT CABLE INTO THE BASE OF CABINET AND PROPERLY TAG. CONTACT MR BOB GONZLES AT (240) 777-8761 SEVENTY TWO HOURS IN ADVANCE OF THE INTENDED WORK.

IV. PROJECT CONTACTS

THE CONTACT PERSONS FOR DISTRICT THREE ARE AS FOLLOWS:

MR. CHARLIE WATKINS
DISTRICT ENGINEER
PHONE (301) 513-7311

MR. MAJID SHAKIB
ASSISTANT DISTRICT ENGINEER-TRAFFIC
PHONE: (301) 513-7358

MR. AUGUSTINE REHBISH
UTILITY ENGINEER
PHONE: (301) 513-7350

MR. RICHARD L. DAFF, SR.
CHIEF, TRAFFIC OPERATIONS DIVISION
PHONE: (410) 787-7630

MR. ROBERT GONZALES
TRAFFIC ENGINEER
MONTGOMERY COUNTY DPWT
PHONE: (240) 777-8761

THE POWER COMPANY REPRESENTATIVE IS POTOMAC ELECTRIC POWER COMPANY
5105 PEGRAM WAY
PHONE: (202) 872-2000

V. MAINTENANCE OF TRAFFIC

THE FOLLOWING STANDARD TRAFFIC CONTROL NUMBERS SHALL BE REFERENCED:

STANDARD NO.104.00
STANDARDS NO.104.37, 104.38 (LANE CLOSURE)
STANDARDS NO.104.33, (D.A.) (CONSTRUCTION FAR SIDE DISTURBED)
STANDARD NO.104.43 (SHOULDER WORK)

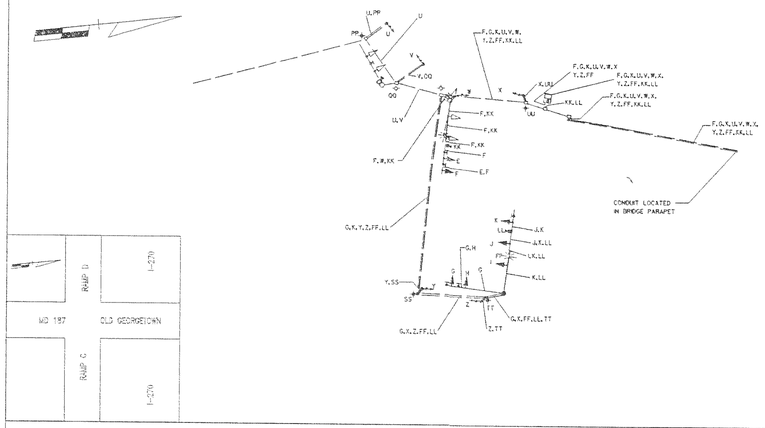

WIRING LEGEND:

A,E,F,G,H,J,J,K, L,M,N,O,P,S,T — 5-CONDUCTOR ELECTRICAL CABLE (NO.14 A.W.G.)

U,V,W,X,Y,Z, AA,BB,CC,DD — 3-CONDUCTOR ELECTRICAL CABLE (NO.14 A.W.G.)

FF,HH — 2-CONDUCTOR ELECTRICAL CABLE (NO.12 A.W.G.)

KK,LL,NN,OO, — VIDEO TRAFFIC DETECTION CABLE 7-CONDUCTOR (NO.18 A.W.G.)

PP,QQ,SS,TT,UU, WW,XX,YY,ZZ — STRANDED BARE COPPER GROUND WIRE (NO. 6 A.W.G.)

+ — 3/4" x 10' GROUND ROD

EQUIPMENT LIST 'A'

A. EQUIPMENT TO BE SUPPLIED BY THE SHA.

QUANTITY	UNIT	SPECIFICATION SECTION	DESCRIPTION
54	SF	813	FLAT SHEET ALUMINUM SIGNS CONSISTING OF:
			- 2 EACH R3-5L (30" X 36") - MAST ARM MOUNT
			- 1 EACH R3-6 (30" X 36") - MAST ARM MOUNT
			- 1 ASSOCIATED D.O.T. 187 FIELD ASSEMBLY (48" X 72")
			- 1 EACH R3-2 (30"X30") - MAST ARM MOUNT

5

EQUIPMENT LIST 'B'

B. EQUIPMENT TO BE FURNISHED AND/OR INSTALLED BY THE CONTRACTOR.

QUANTITY	UNIT	SPECIFICATION SECTION	DESCRIPTION
340	LF	556	12 INCH HEAT APPLIED WHITE PERMANENT PREFORMED THERMOPLASTIC PAVEMENT MARKING
200	LF	556	24 INCH HEAT APPLIED WHITE PERMANENT PREFORMED THERMOPLASTIC PAVEMENT MARKING
9	CY	531	FURNISH AND INSTALL CONCRETE FOR SIGNAL FOUNDATION
1	EA	SP	FURNISH AND INSTALL 27-FOOT STEEL POLE WITH TWIN 60-FOOT AND 70-FOOT MAST ARMS
21	EA	814	FURNISH AND INSTALL 12 INCH VEHICULAR TRAFFIC SIGNAL HEAD SECTION
54	SF	813	INSTALL OVERHEAD SIGN
1	EA	818	FURNISH AND INSTALL 20-FOOT LIGHTING ARM ON SIGNAL STRUCTURE
1	EA	836	FURNISH AND INSTALL 250 WATT HIGH PRESSURE SODIUM LAMP AND LUMINAIRE WITH PHOTOCELL
6	EA	804	FURNISH AND INSTALL GROUND ROD-3/4 INCH DIAMETER X 10-FOOT LENGTH
5	EA	SP	FURNISH AND INSTALL 10-FOOT BREAKWAY PEDESTAL POLE
2	EA	814	FURNISH AND INSTALL 12-INCH PEDESTRIAN SIGNAL HEAD SECTION POLE MOUNT
10	EA	814	FURNISH AND INSTALL 12-INCH PEDESTRIAN SIGNAL HEAD SECTION PEDESTAL MOUNT
2	EA	811	FURNISH AND INSTALL ELECTRICAL HANDHOLE
445	LF	810	FURNISH AND INSTALL ELECTRICAL CABLE- 2 CONDUCTOR (NO 12 AWG)
1370	LF	810	FURNISH AND INSTALL ELECTRICAL CABLE- 3 CONDUCTOR (NO 14 AWG)
1280	LF	810	FURNISH AND INSTALL ELECTRICAL CABLE- 5 CONDUCTOR (NO 14 AWG)
730	LF	SP	FURNISH AND INSTALL VIDEO TRAFFIC DETECTION CABLE
90	LF	810	FURNISH AND INSTALL NO. 6 AWG STRANDED BARE COPPER GROUND WIRE
140	LF	805	FURNISH AND INSTALL 3" SCHEDULE 80 RIGID PVC CONDUIT- TRENCHED
170	LF	805	FURNISH AND INSTALL 3" SCHEDULE 80 RIGID PVC CONDUIT- BORED
6	EA	SP	CUT, CLEAN AND CAP TRAFFIC SIGNAL STRUCTURE
1	LS	SP	REMOVE AND DISPOSE OF EXISTING EQUIPMENT
2	EA	SP	FURNISH AND INSTALL VIDEO TRAFFIC DETECTION SYSTEM

PHASE CHART

	1	2	3	4	5	6	7	8	9	10	11	12	13	14	15	16	17	18
PHASE 2 & 6	G	G	G	R	R	G	G	G	G	G	R	R	W	W	W	W	DW	DW
PED CLEAR	G	G	G	R	R	G	G	G	G	G	R	R	FL/DW	FL/DW	FL/DW	FL/DW	DW	DW
2 & 6 CHANGE	Y	Y	Y	R	R	G	G	Y	Y	Y	R	R	DW	DW	DW	DW	W	W
PHASE 2 & 5	R	R	R	G	G	G	G	R	R	R	R	R	DW	DW	DW	DW	FL/DW	FL/DW
2 & 5 CHANGE	R	R	R	Y	Y	Y	Y	R	R	R	R	R	DW	DW	DW	DW	DW	DW
PHASE 4	R	R	R	R	R	R	R	G	G	G	G	G	DW	DW	DW	DW	DW	DW
4 CHANGE	R	R	R	R	R	R	R	Y	Y	Y	Y	Y	DW	DW	DW	DW	DW	DW
FLASHING OPERATION	FL/Y	FL/Y	FL/Y	FL/Y	FL/Y	FL/Y	FL/Y	FL/R	FL/R	FL/R	FL/R	FL/R	DARK	DARK	DARK	DARK	DARK	DARK

REVISION "C"

KCI TECHNOLOGIES

KCI TECHNOLOGIES INC.
ENGINEERS AND PLANNERS
10 NORTH PARK DRIVE
HUNT VALLEY, MARYLAND
21030-1888
(410) 316-7800

REVISIONS
5 REDLINE REVISION NO. 5 NEW SHEET 9/4/2001
MP
A ADDENDUM NO. 2 REPLACEMENT SHEET 11/20/00
C NEW MD 187 GEOMETRICS 10-00 SHA CONT. NO. M08995172
MP
B REVISED SIGNAL HEAD DISPLAY 10/14/75
SR

APPROVALS

TEAM LEADER, TRAFFIC ENGINEERING DESIGN DIVISION

ORIGINAL

ASST. CHIEF TRAFFIC ENGINEERING DESIGN DIVISION

ON

CHIEF, TRAFFIC ENGINEERING DESIGN DIVISION

FILE

DIRECTOR, TRAFFIC & SAFETY

TS-14A

MARYLAND DOT - STATE HIGHWAY ADMINISTRATION
Office of Traffic & Safety
TRAFFIC ENGINEERING DESIGN DIVISION

I-270 INTERCHANGES AT ROCKLEDGE DRIVE AND MD 187
GENERAL INFORMATION SHEET (ULTIMATE PHASE)
I-270 RAMP C/RAMP D AT MD 187 (OLD GEORGETOWN ROAD)

DRAWN BY: STEVE RENZI	F.A.P. NO.	TS NO. 12500-01	SHEET NO.
CHECKED BY: STEVE RENZI	S.H.A. NO.		
SCALE: NONE	COUNTY: MONTGOMERY	T.I.M.S. NO. D-311	265A OF 404
DATE: 12/27/74	LOG MILE: 15.018703.73		

M:\1998\193073\TRAFF\C#

3/24/01 8:58:20 AM G:\PLOTTING\PS7\OCF\MYLAR_HP.cfg McGrady Pierre Division Transportation m:\1998\01980?8\TRAFFIC\spmcutjob.prt