EXISTING SIGNS

20,21 — R 3-5(L) 30" x 36"

23,25 — R 3-5(L) 30" x 36"

19 — Omega Dr. / Medical Center Dr. — D-3(1) 32" x Var.

22 — Medical Center Dr. / Omega Dr. — D-3(1) 32" x Var.

24,26 — Key West Ave — D -3(1) 16" x Var.

EXISTING SIGNALS

1,2,8-12 — R Y G 12"

3,4,5 — R Y G 12"

6,7 — R Y G 12"

13-18 — 12"

EXISTING NEMA PHASING

Ø2 Ø4 Ø5 Ø6 Ø8

Ø4 Alt.

FLASHING OPERATION

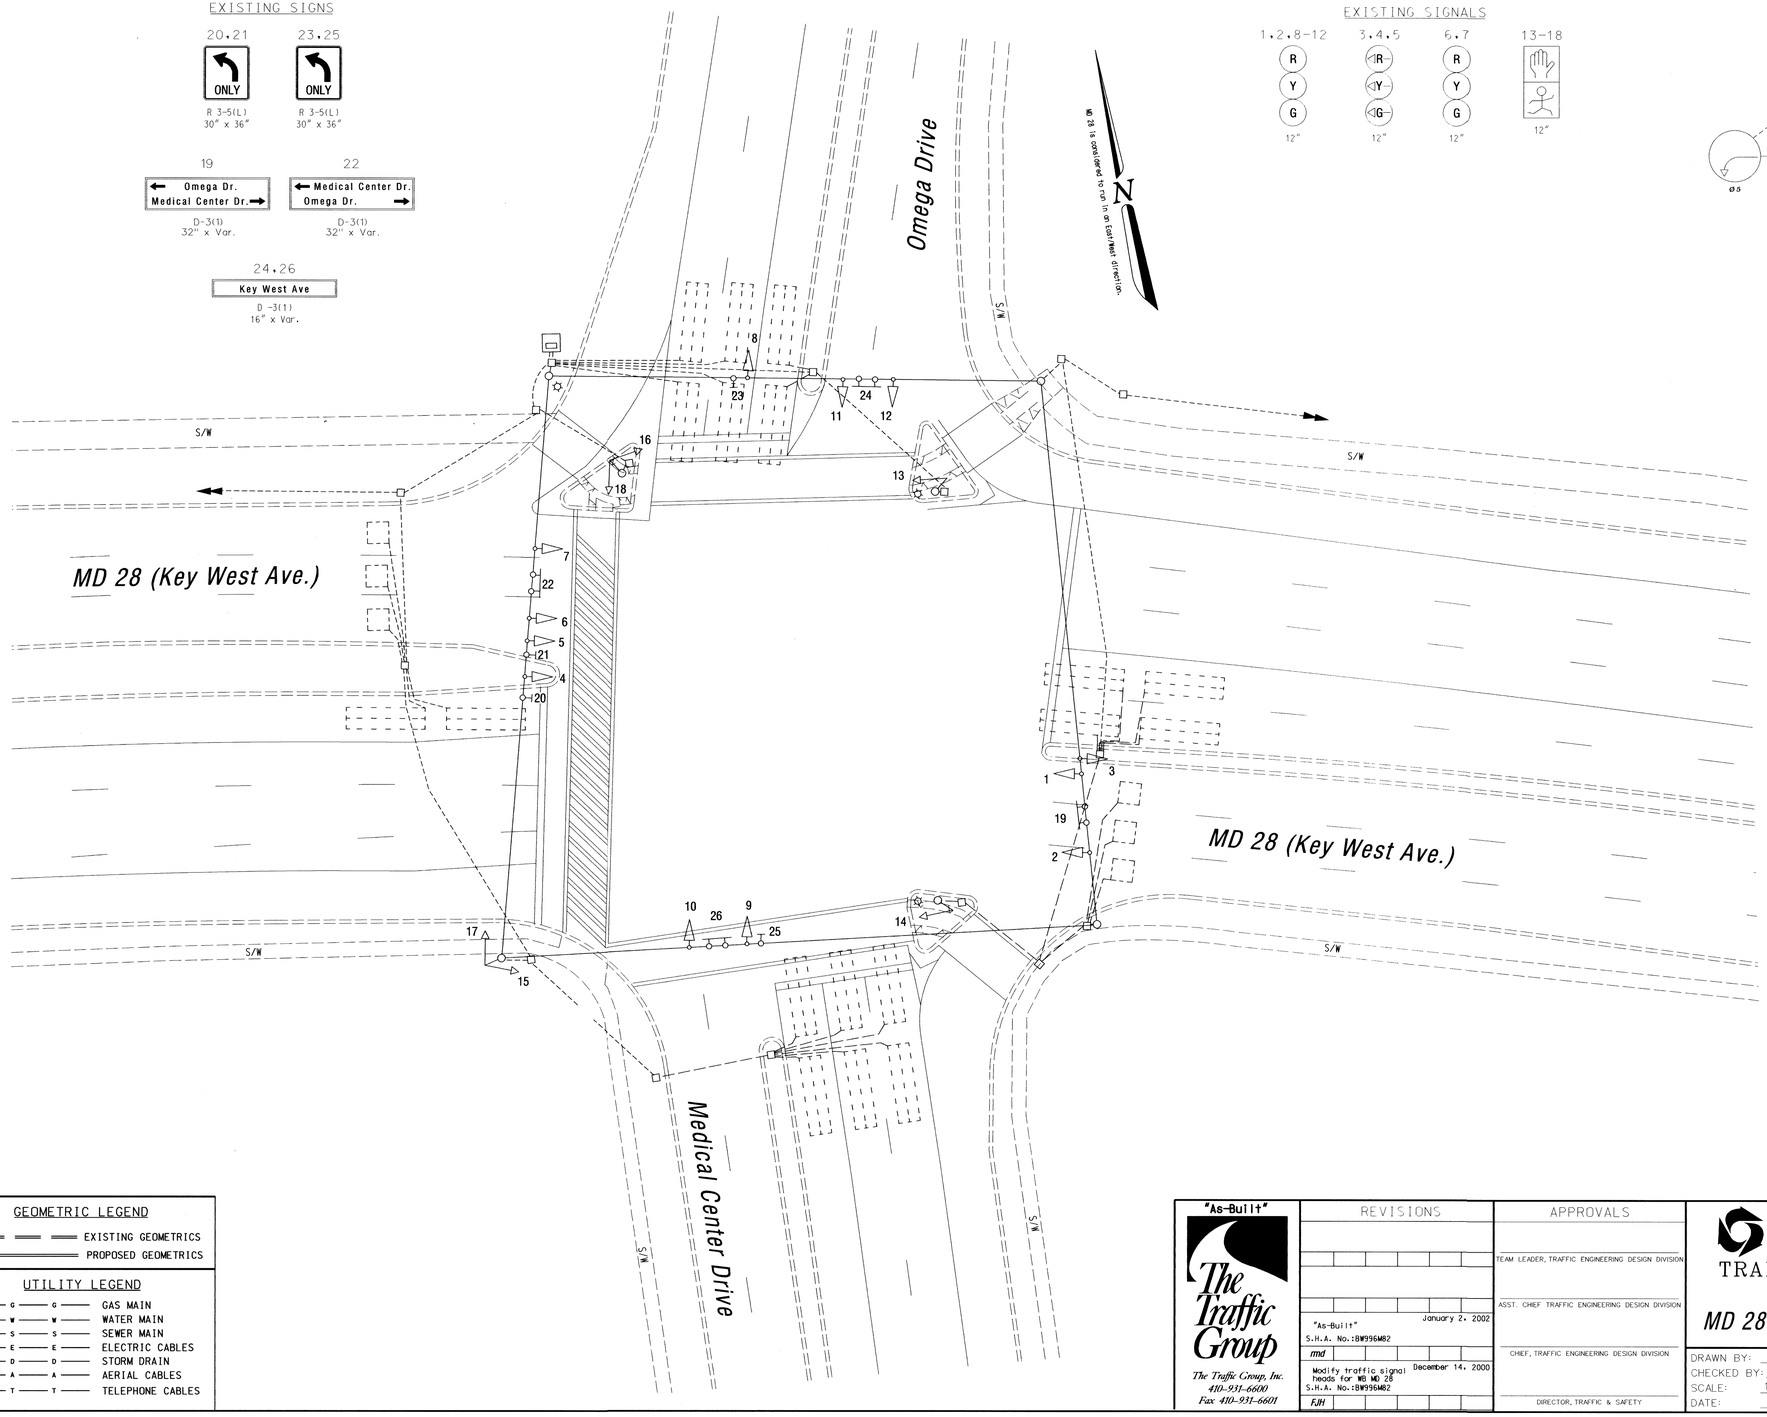

GEOMETRIC LEGEND

EXISTING GEOMETRICS

PROPOSED GEOMETRICS

UTILITY LEGEND

G	GAS MAIN
W	WATER MAIN
S	SEWER MAIN
E	ELECTRIC CABLES
D	STORM DRAIN
A	AERIAL CABLES
T	TELEPHONE CABLES

"As-Built"

The Traffic Group

The Traffic Group, Inc.
410-931-6600
Fax 410-931-6601

REVISIONS

"As-Built" S.H.A. No.:BW996M82	January 2, 2002	mmd
Modify traffic signal heads for MB MD 28 S.H.A. No.:BW996M82	December 14, 2000	FJH

APPROVALS

TEAM LEADER, TRAFFIC ENGINEERING DESIGN DIVISION

ASST. CHIEF TRAFFIC ENGINEERING DESIGN DIVISION

CHIEF, TRAFFIC ENGINEERING DESIGN DIVISION

DIRECTOR, TRAFFIC & SAFETY

MARYLAND DOT - STATE HIGHWAY ADMINISTRATION

Office of Traffic & Safety

TRAFFIC ENGINEERING DESIGN DIVISION

(As-Built)

MD 28 (Key West Ave.) at Medical Center Dr./Omega Dr.

DRAWN BY:	F.A.P. NO. N/A	TS NO. 4057	SHEET NO. 1 OF 1
CHECKED BY:	S.H.A. NO.		
SCALE: 1" = 20'	COUNTY: Montgomery	T.I.M.S. NO. E127	
DATE:	LOG MILE:		

I:\9999\9D13D\9D6\dwg\updated\updated\2002\ed-plans.dgn 07 FEB 2002