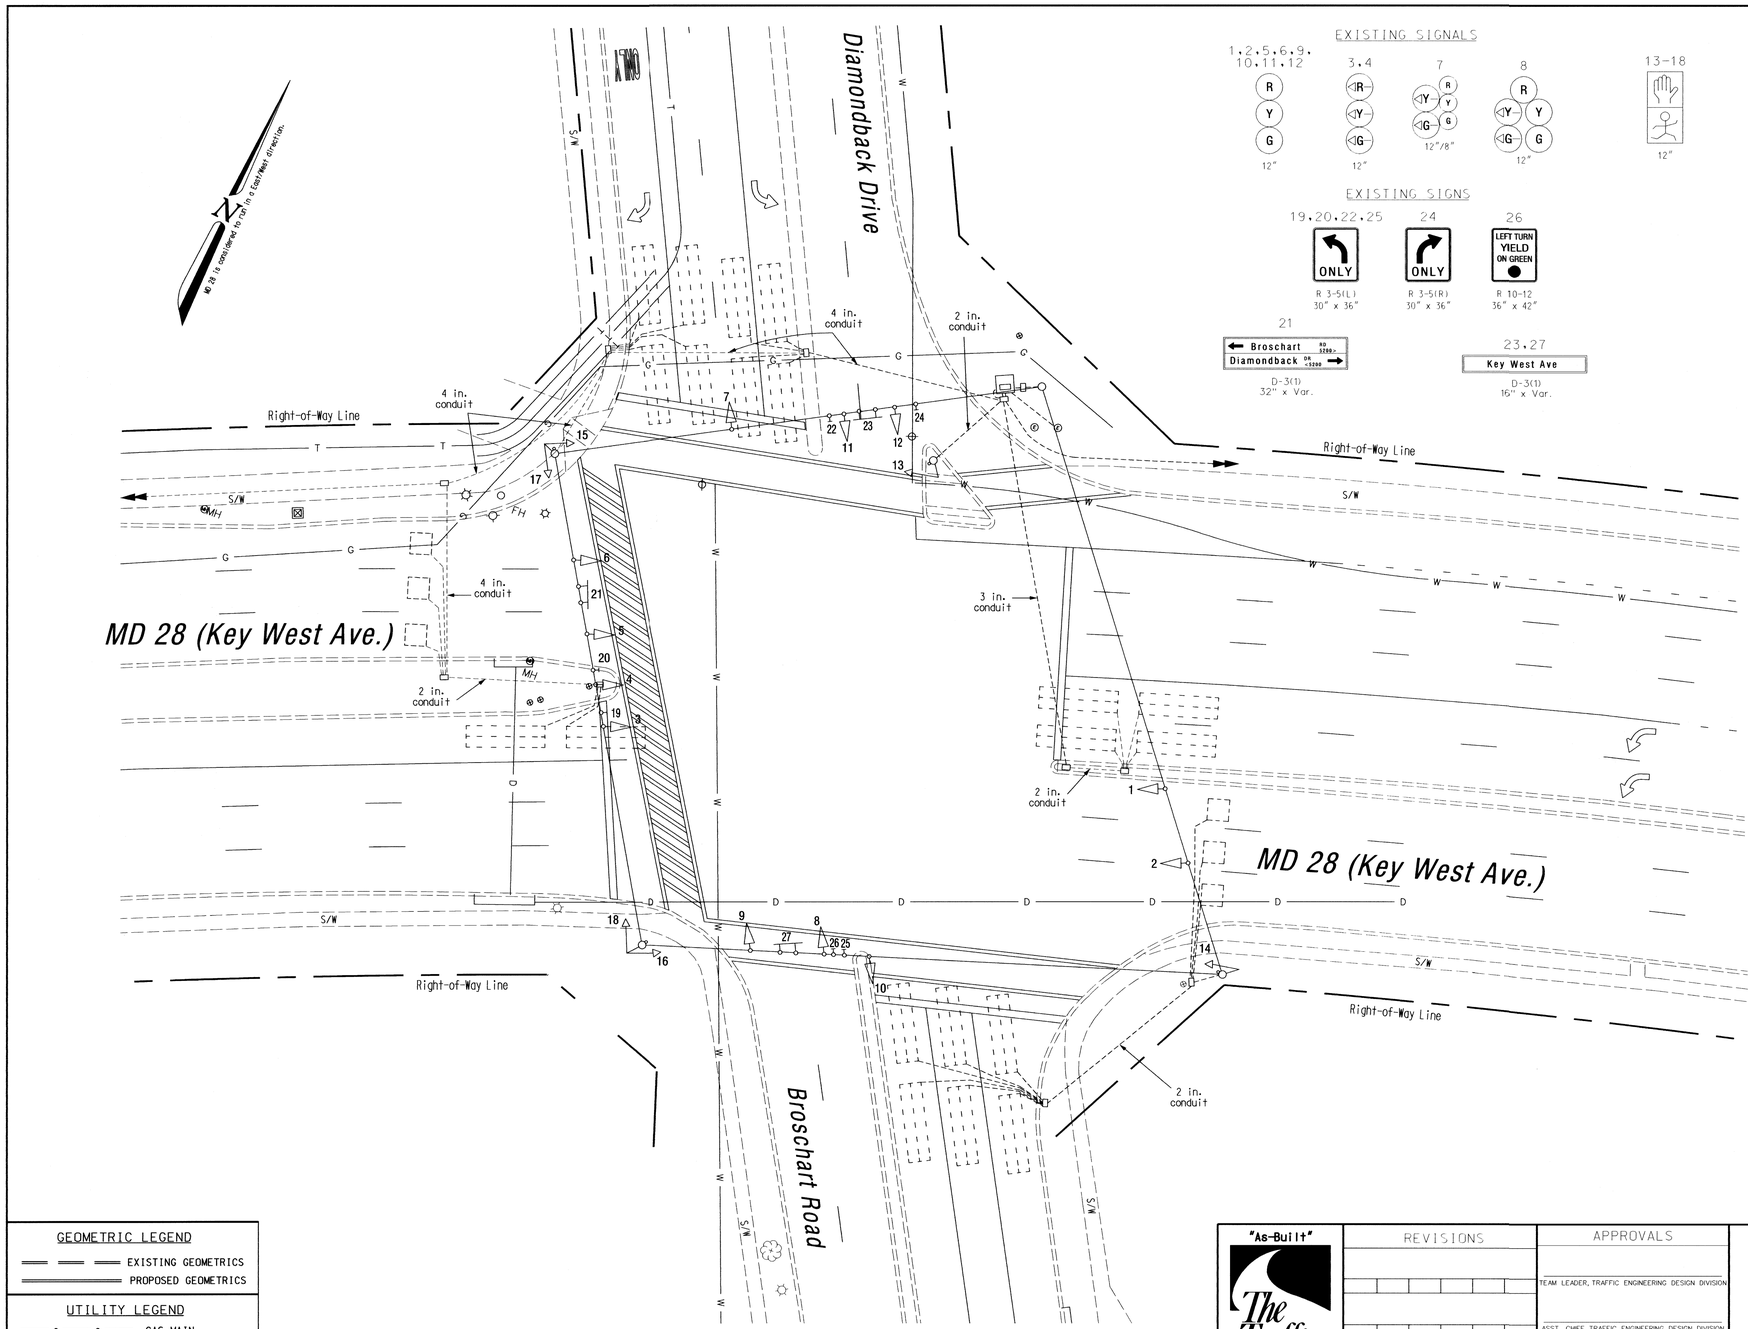


GEOMETRIC LEGEND

EXISTING GEOMETRICS

PROPOSED GEOMETRICS

UTILITY LEGEND

| | |
|---|---|
| G | GAS MAIN |
| W | WATER MAIN |
| S | SEWER MAIN |
| E | ELECTRIC CABLES |
| D | STORM DRAIN |
| A | AERIAL CABLES |
| T | TELEPHONE CABLES |

"As-Built"

The Traffic Group

The Traffic Group, Inc.
410-931-6600
Fax 410-931-6601

REVISIONS

"As-Built" January 2, 2002
S.H.A. No.:BW996M82
mmd

Geometric changes. December 14, 2000
Relocate pole and loop work.
S.H.A. No.:BW996M82
fjh/rdb

APPROVALS

TEAM LEADER, TRAFFIC ENGINEERING DESIGN DIVISION

ASST. CHIEF TRAFFIC ENGINEERING DESIGN DIVISION

CHIEF, TRAFFIC ENGINEERING DESIGN DIVISION

DIRECTOR, TRAFFIC & SAFETY

MARYLAND DOT - STATE HIGHWAY ADMINISTRATION

*Office of Traffic & Safety*

TRAFFIC ENGINEERING DESIGN DIVISION

(Traffic Signal Plan)

*MD 28 at Diamondback Drive/Broschart Road*

| | | | |
|---|---|---|---|
| DRAWN BY: | F.A.P. NO. N/A | TS NO. 4058 | SHEET NO. |
| CHECKED BY: | S.H.A. NO. BW996M82 | | |
| SCALE: 1" = 20' | COUNTY: Montgomery | T.I.M.S. NO. E127 | 1 OF 1 |
| DATE: | LOG MILE: | | |

f:\19930\19910\dev\update\jpr2002\ab plan1.dgn 07 FEB 2002